

BULLETIN # 20



DATE: December 12, 2025

TO: Piazza Inc.
Attn: Gus Carvajal

CC: Chaker Maghak, Hill Intl.,

FROM: Brian Dunn, AIA
KG+D Architects, PC

PROJECT: Harrison Recreation & Community Center – PHASE 2
Harrison, NY

RE: Stair A Storage Closet

Message:

Please provide pricing for the additional Storage Closet shown on the attached ASK-23. Scope to include additional smoke detector, dry type sprinkler head, 1 hour rated GWB wall and HM door and frame with hardware type 26.


Please call if there are any questions.

Cc: TVH Engineering Department
File

Encl: ASK-23

KG+D Architects, PC

285 Main Street, Mount Kisco, New York 10549
914.666.5900 kgdarchitects.com

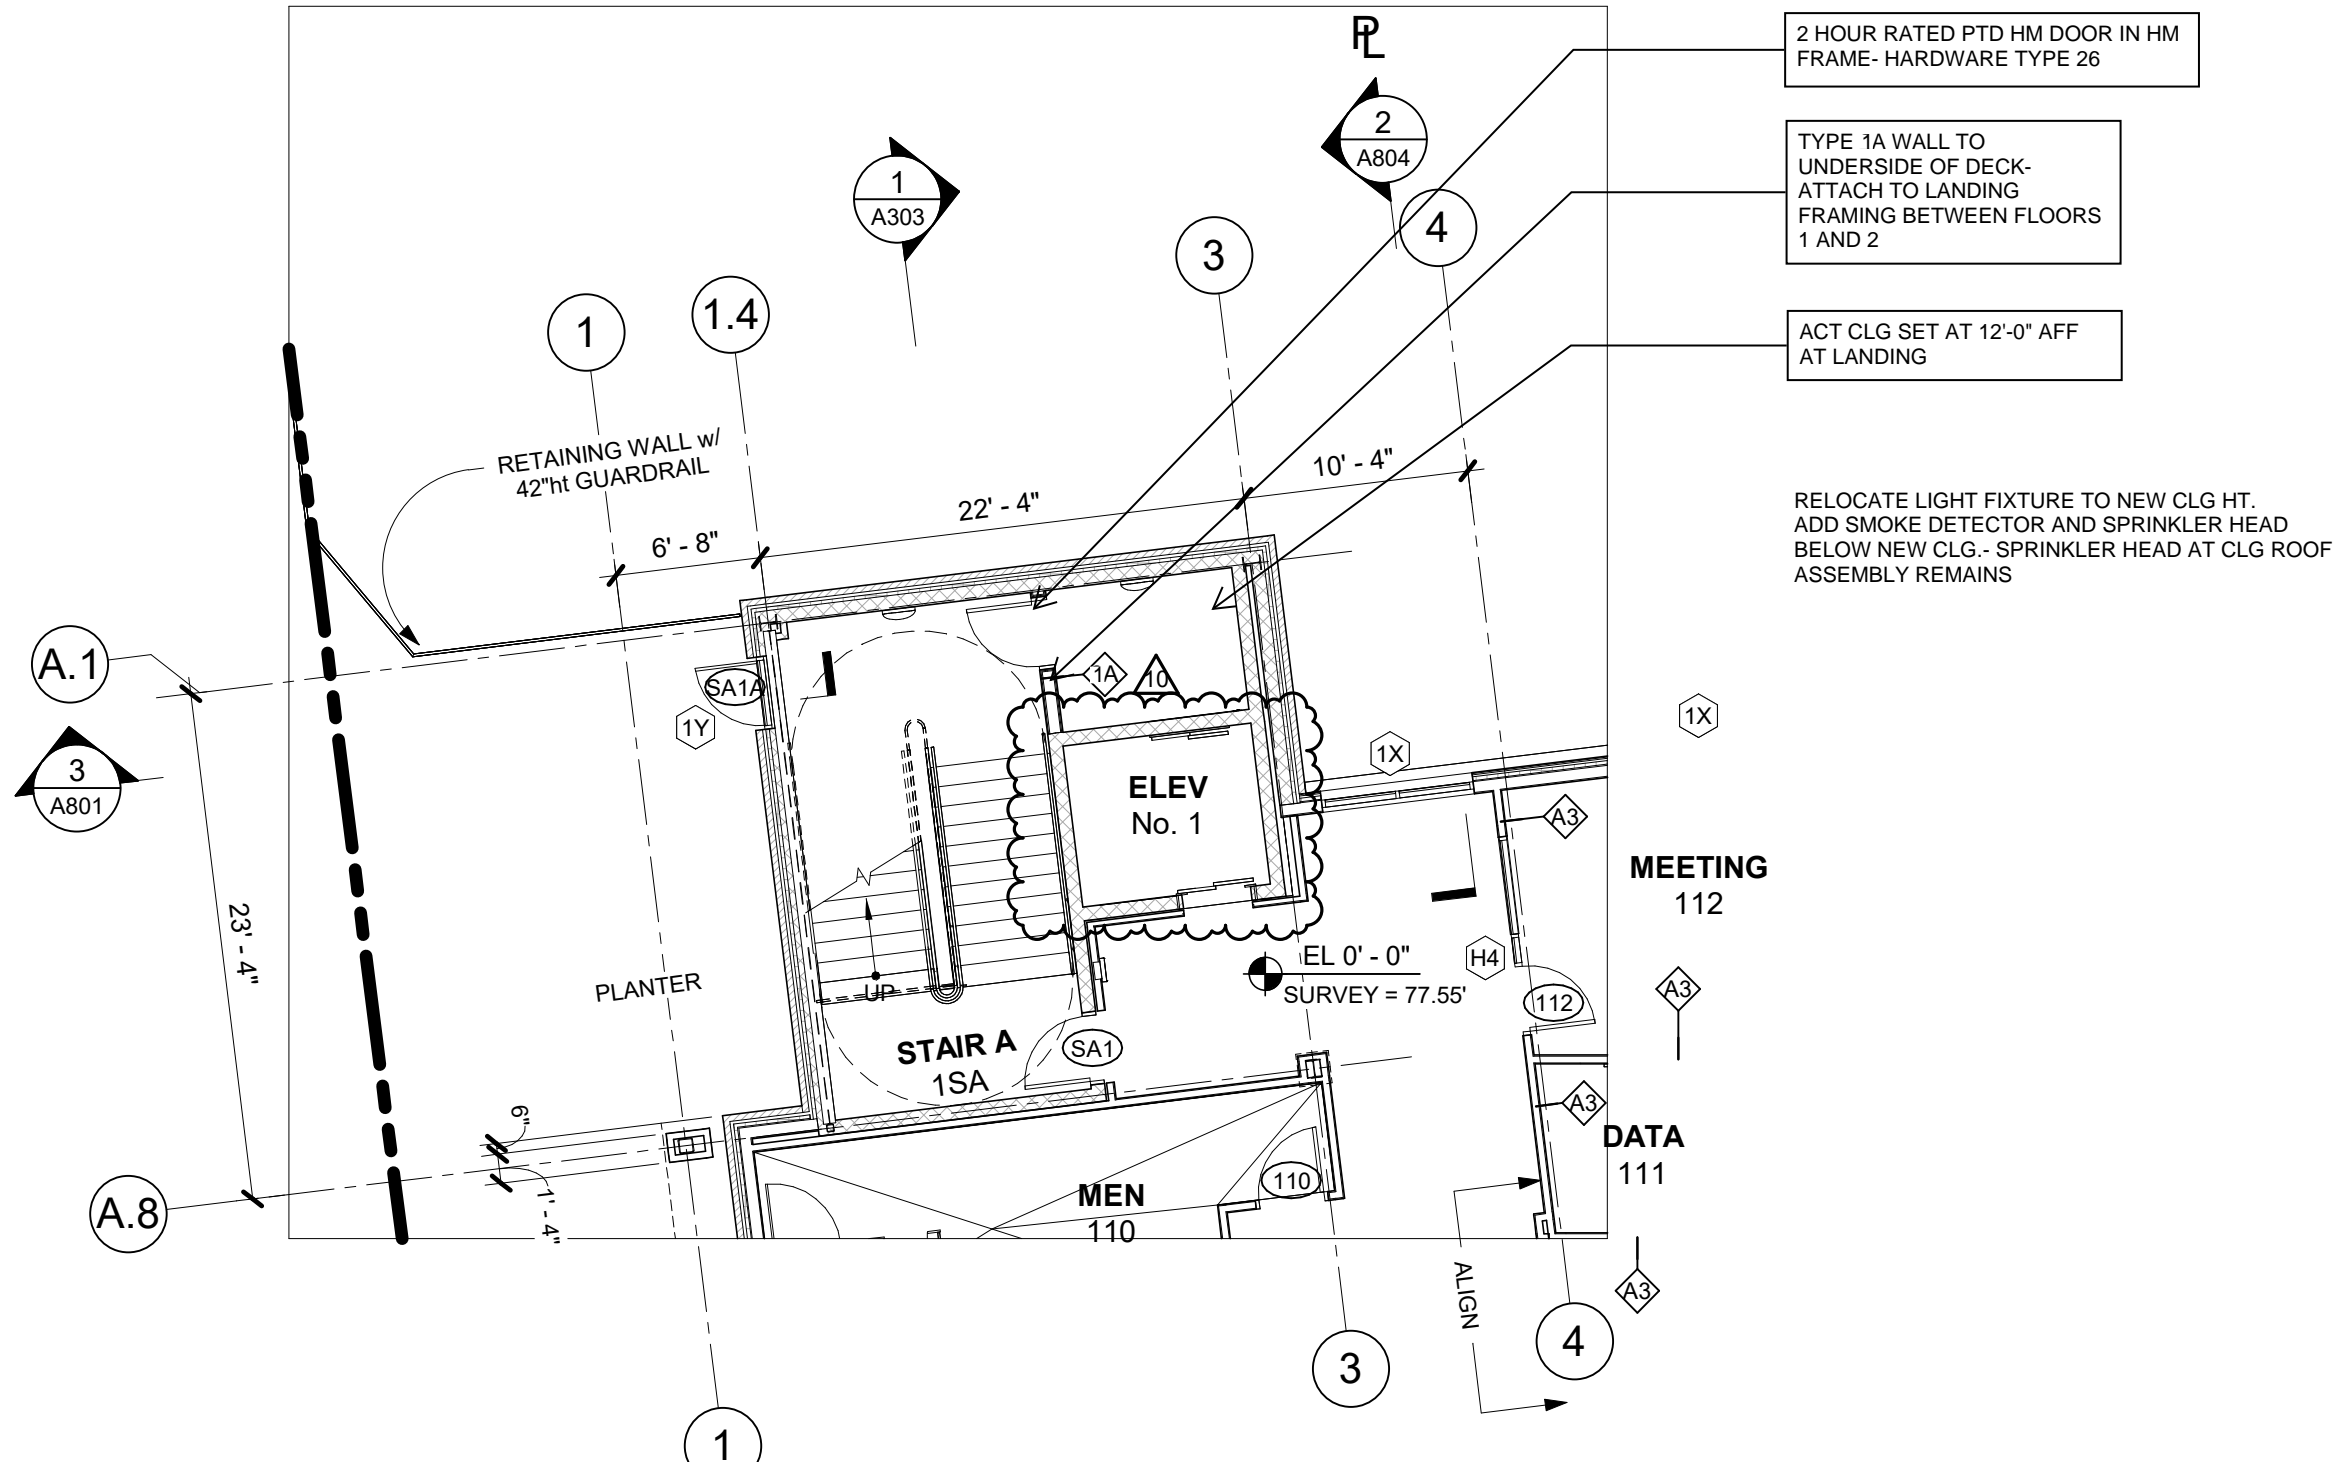

2 HOUR RATED PTD HM DOOR IN HM FRAME- HARDWARE TYPE 26

TYPE 1A WALL TO UNDERSIDE OF DECK- ATTACH TO LANDING FRAMING BETWEEN FLOORS 1 AND 2

ACT CLG SET AT 12'-0" AFF AT LANDING

RELOCATE LIGHT FIXTURE TO NEW CLG HT. ADD SMOKE DETECTOR AND SPRINKLER HEAD BELOW NEW CLG.- SPRINKLER HEAD AT CLG ROOF ASSEMBLY REMAINS



HARRISON RECREATION & COMMUNITY CENTER
Town / Village of Harrison

Sheet Title
STAIR A STORAGE CLOSET

Job No.
2020-1005
Date
12/10/25
Scale
1/8" = 1'-0"
Drawn / Checked
BD

Sheet No.
ASK-22