

BULLETIN # 27



DATE: March 13, 2026

TO: Piazza Inc.
Attn: John Piazza

CC: Chaker Maghak, Hill Intl.

FROM: Brian Dunn, AIA
KG+D Architects, PC

PROJECT: Harrison Recreation & Community Center – PHASE 2
Harrison, NY

RE: Interior Signage Design and Text Updates

As discussed with the client, the attached sketch demonstrates the signage revisions in both design and size requirements.

There are two types of interior signage:

1. The new “decorative” 2-layer translucent sign, that the client requested for review.
 - Applicable to the following signs Type A, Type C, and Types E – Type L.
2. The original “simple” 1-layer acrylic border sign, as per spec an as show in architect’s supplied sample.
 - Applicable to the following signs Type B, Type D, and Type M

Reminder on the following:


- Type Y is an exterior metal plate sign, not interior as the previous change order noted.
- Type P text/size/design will be address in a separate bulletin.
- Type Q is a corner stone b
- Type X12, X14, and X18 signs were already reviewed in shop drawings.

Examine the attachment and provide revised pricing for review. Also, please include information on any schedule impact for this work. If there are questions or require more information, please reach out to the Design Team.


Encl: *Bulletin #27: A530 revision/markup*

KG+D Architects, PC


285 Main Street, Mount Kisco, New York 10549
914.666.5900 kgdarchitects.com

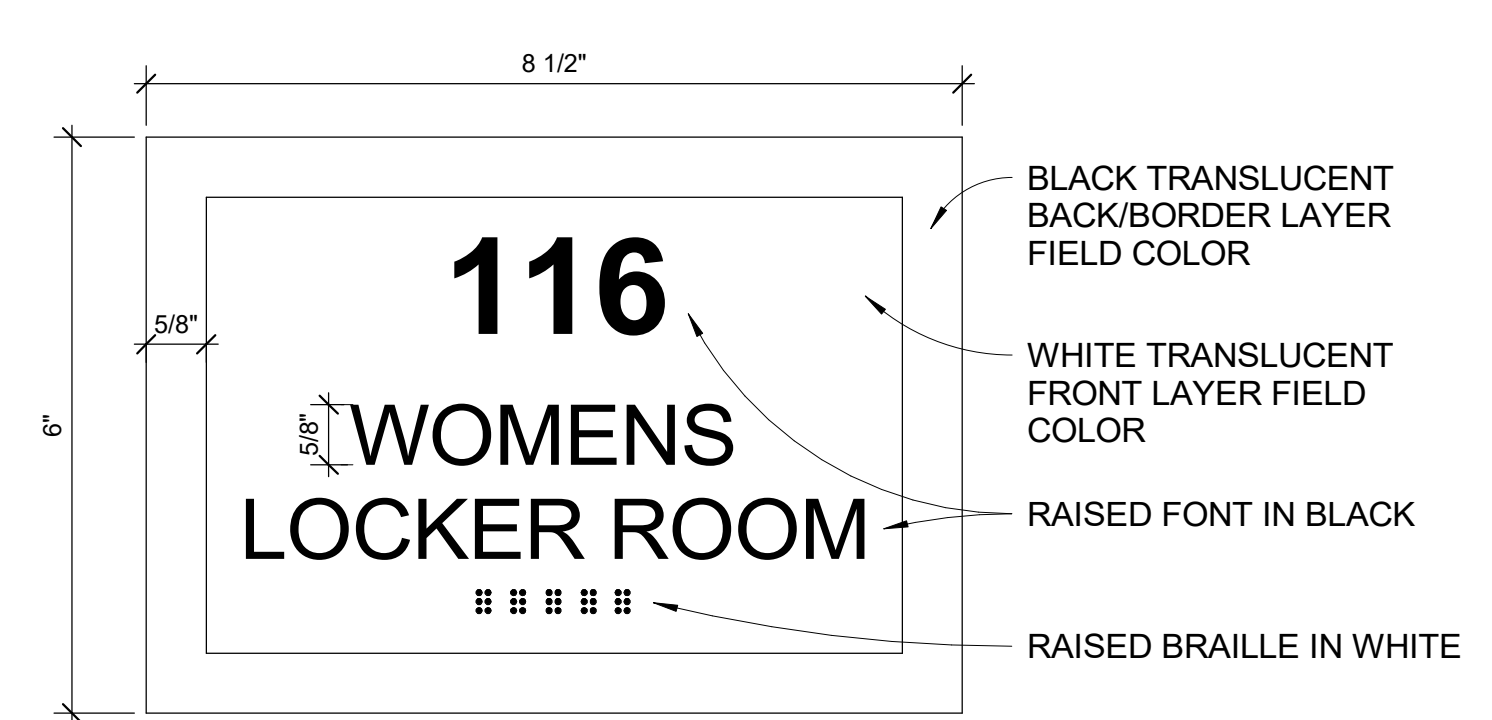


TYPE A
ROOM IDENTIFICATION SIGN
 (2 TRANSLUCENT STACKED LAYERS, AS PER MULBERRY PROVIDED SAMPLE)
 NOTE: WIDTH/HEIGHT OF SIGN TO BE ADJUSTED AS REQUIRED FOR WORDING FROM 8.5" - 10.5" W AND 6" - 7" H

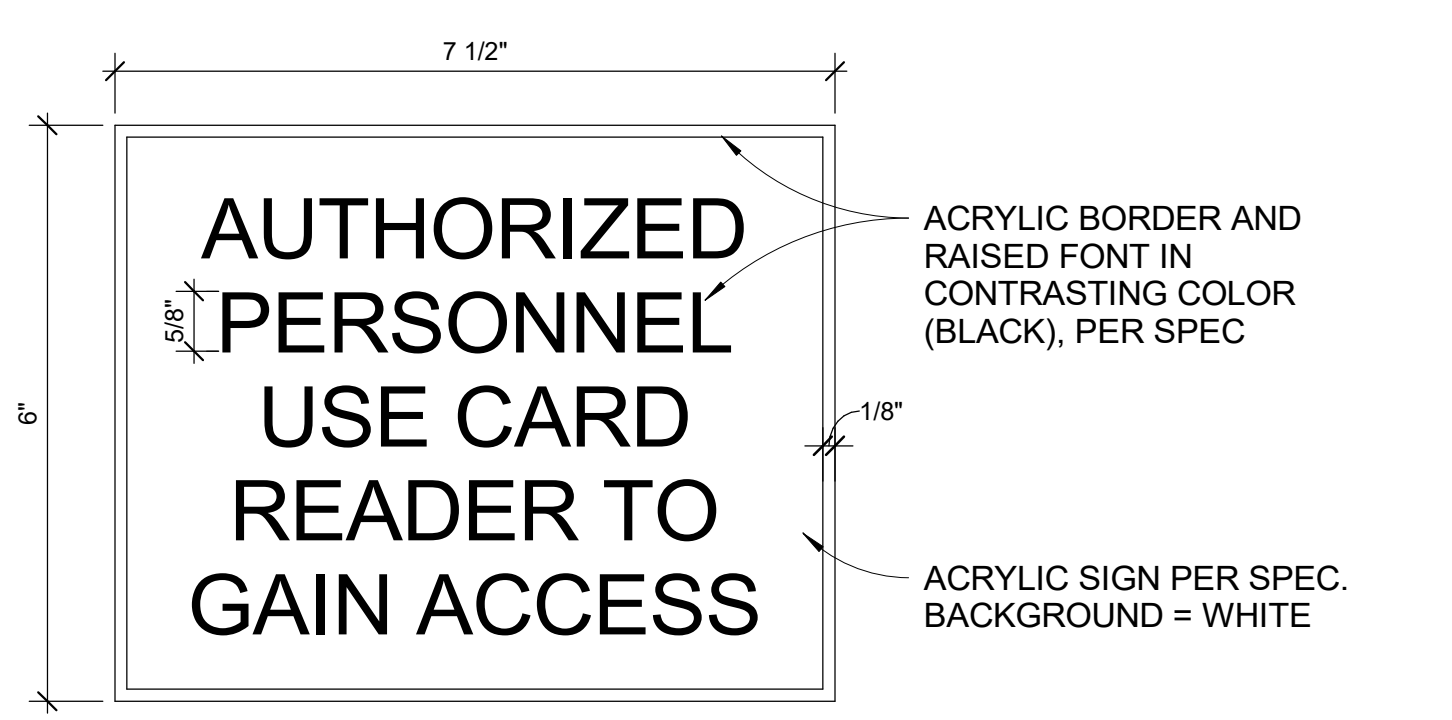


TYPE B
CARD READER SIGN
 (SIMPLE ACRYLIC BORDER SIGN, AS PER SPEC)
 NOTE: SIGNAGE APPLICABLE AT EVERY INTERIOR CARD READER INDICATED ON THE PLANS. GC TO VERIFY QUANTITIES

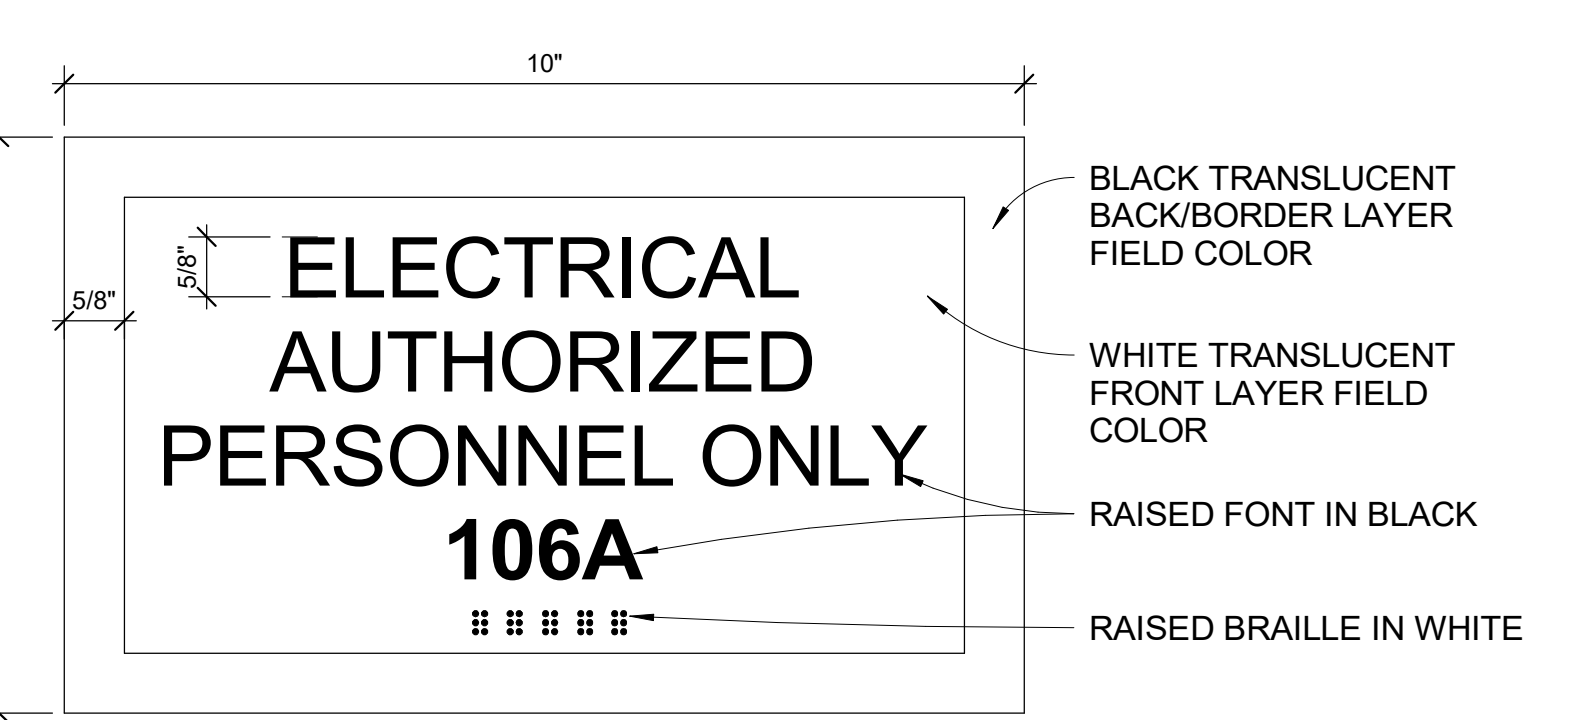


TYPE C
AUTHORIZED PERSONNEL - ROOM IDENTIFICATION
 (2 TRANSLUCENT STACKED LAYERS, AS PER MULBERRY PROVIDED SAMPLE)
 NOTE: WIDTH/HEIGHT OF SIGN TO BE ADJUSTED AS REQUIRED FOR WORDING FROM 8" - 12" W AND 6" - 10" H

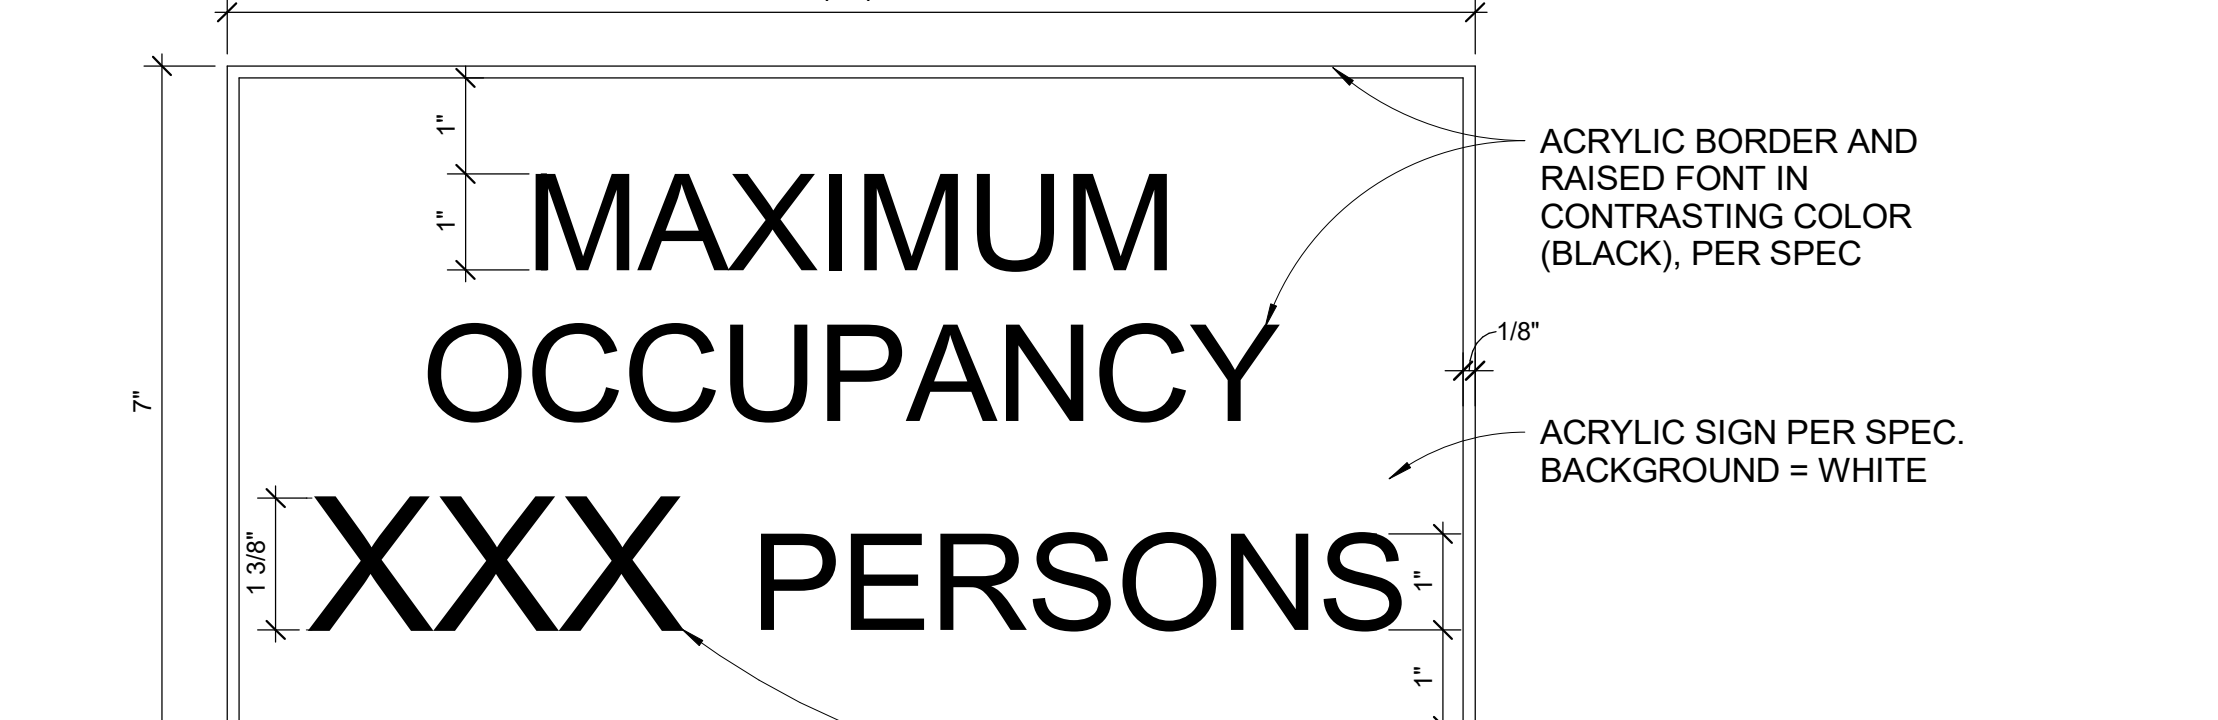


TYPE D
MAXIMUM ROOM OCCUPANCY IDENTIFICATION
 (SIMPLE ACRYLIC BORDER SIGN, AS PER SPEC)
 SEE SIGNAGE SCHEDULE FOR NUMBER INFILL TO REPLACE "XXX" AS NOTED PER ROOM

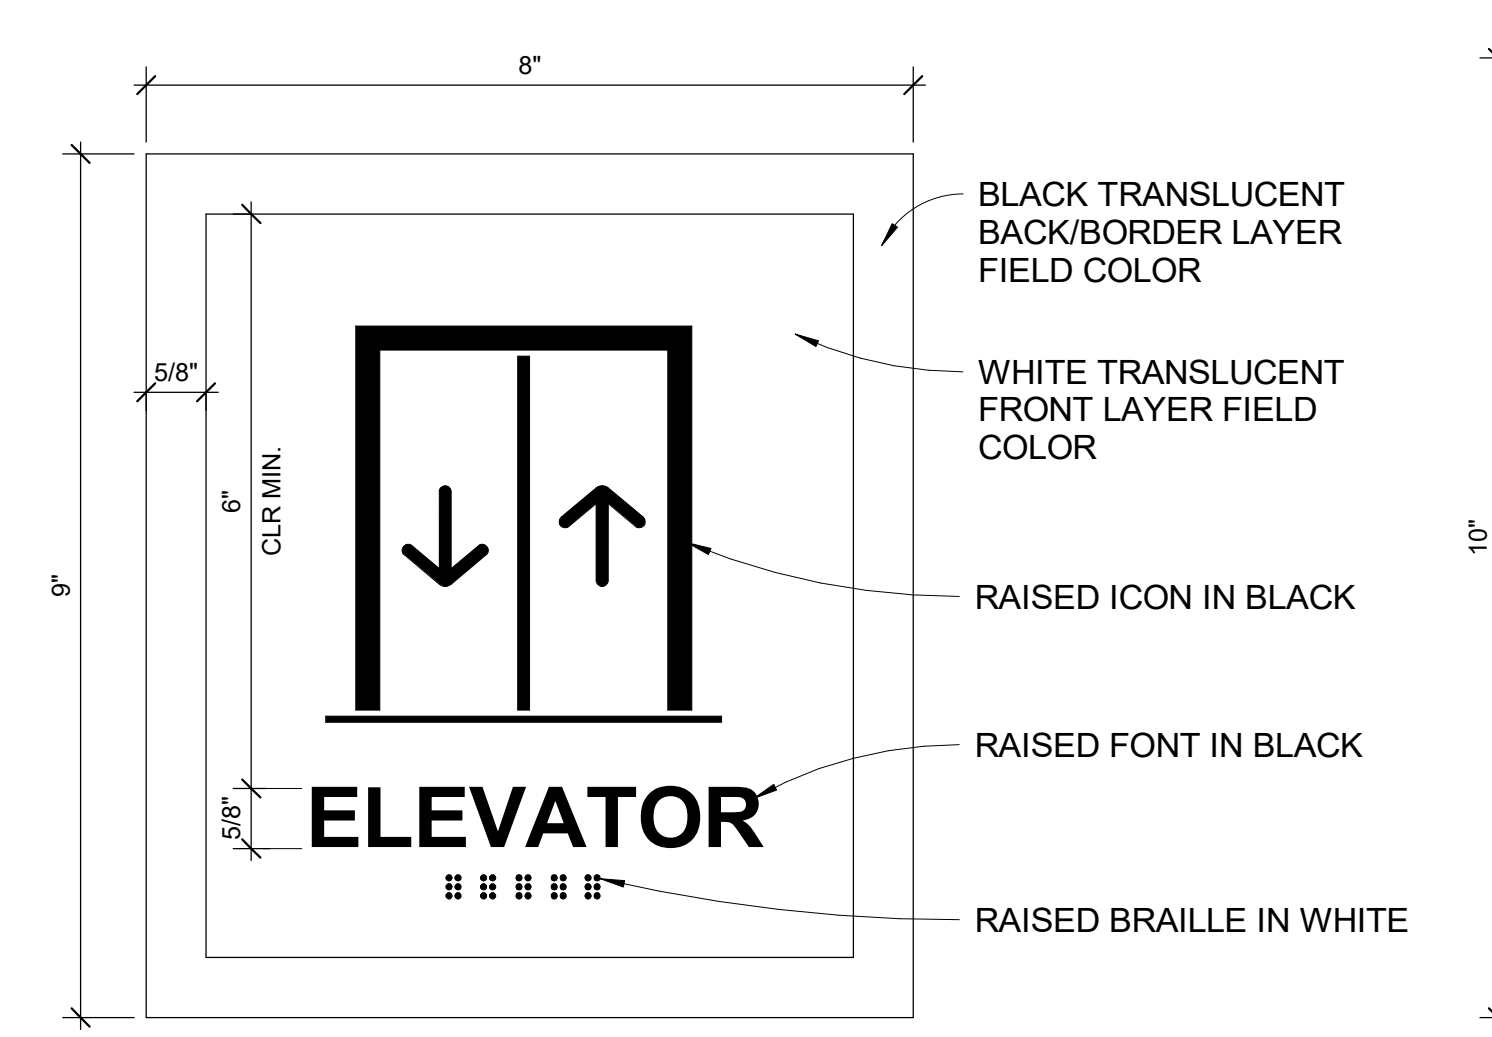


TYPE E
ELEVATOR IDENTIFICATION SIGN
 (2 TRANSLUCENT STACKED LAYERS, AS PER MULBERRY PROVIDED SAMPLE)

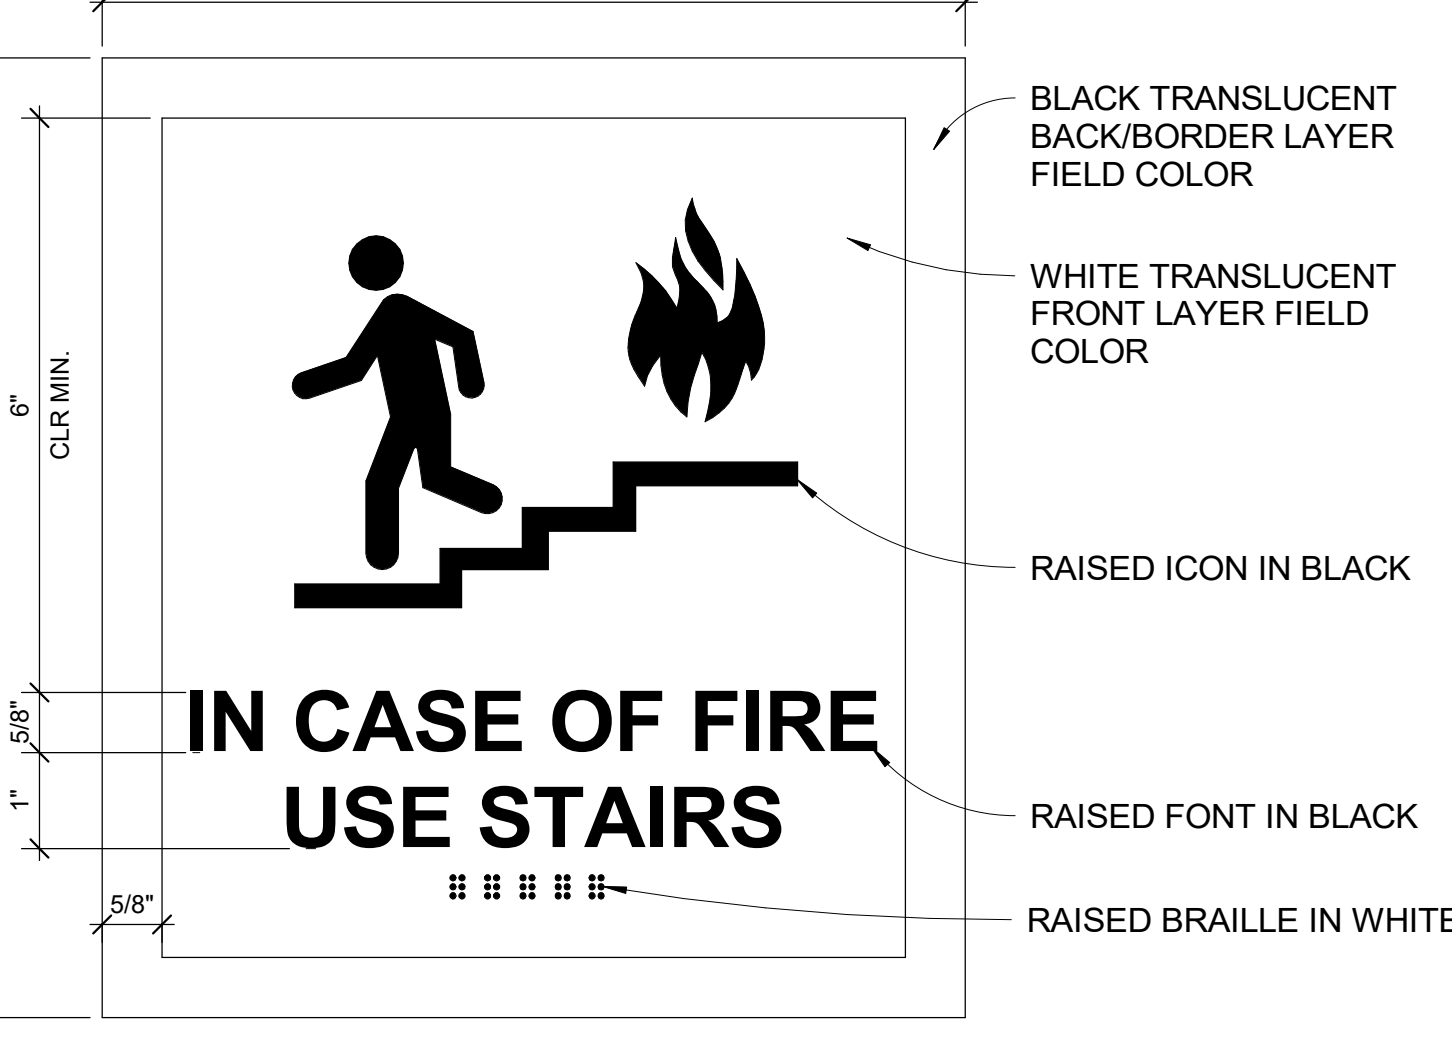


TYPE F
ELEVATOR SECONDARY SIGN
 (2 TRANSLUCENT STACKED LAYERS, AS PER MULBERRY PROVIDED SAMPLE)

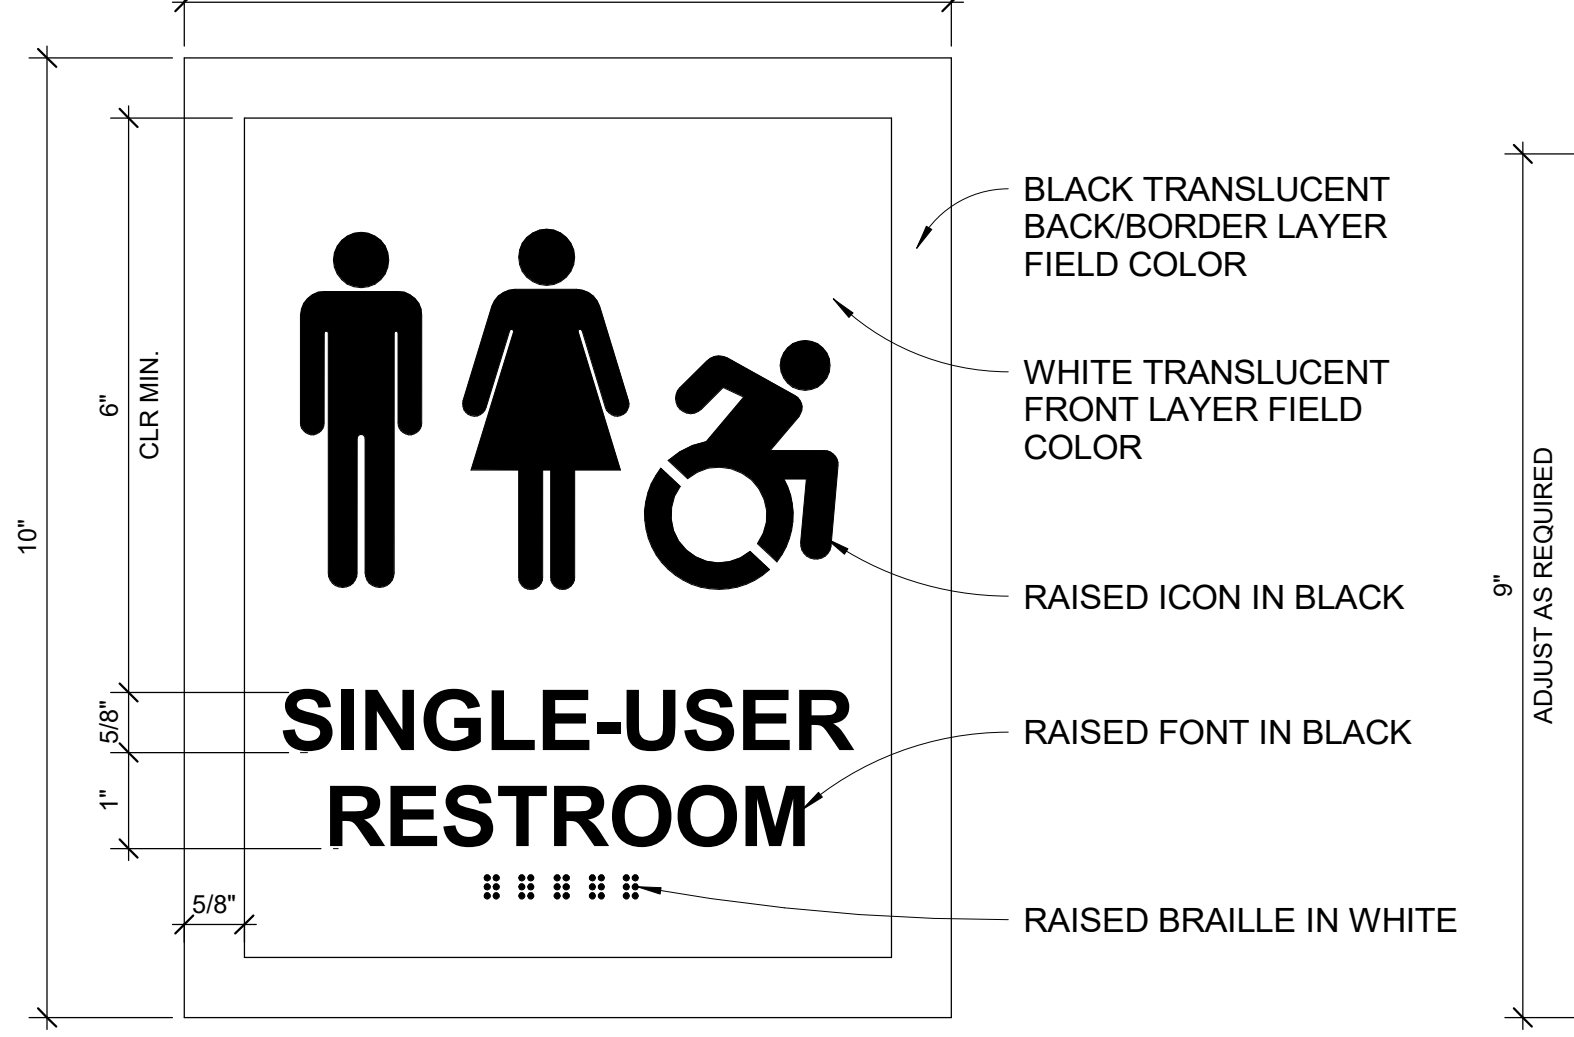


TYPE G
SINGLE USER TOILET IDENTIFICATION SIGN
 (2 TRANSLUCENT STACKED LAYERS, AS PER MULBERRY PROVIDED SAMPLE)

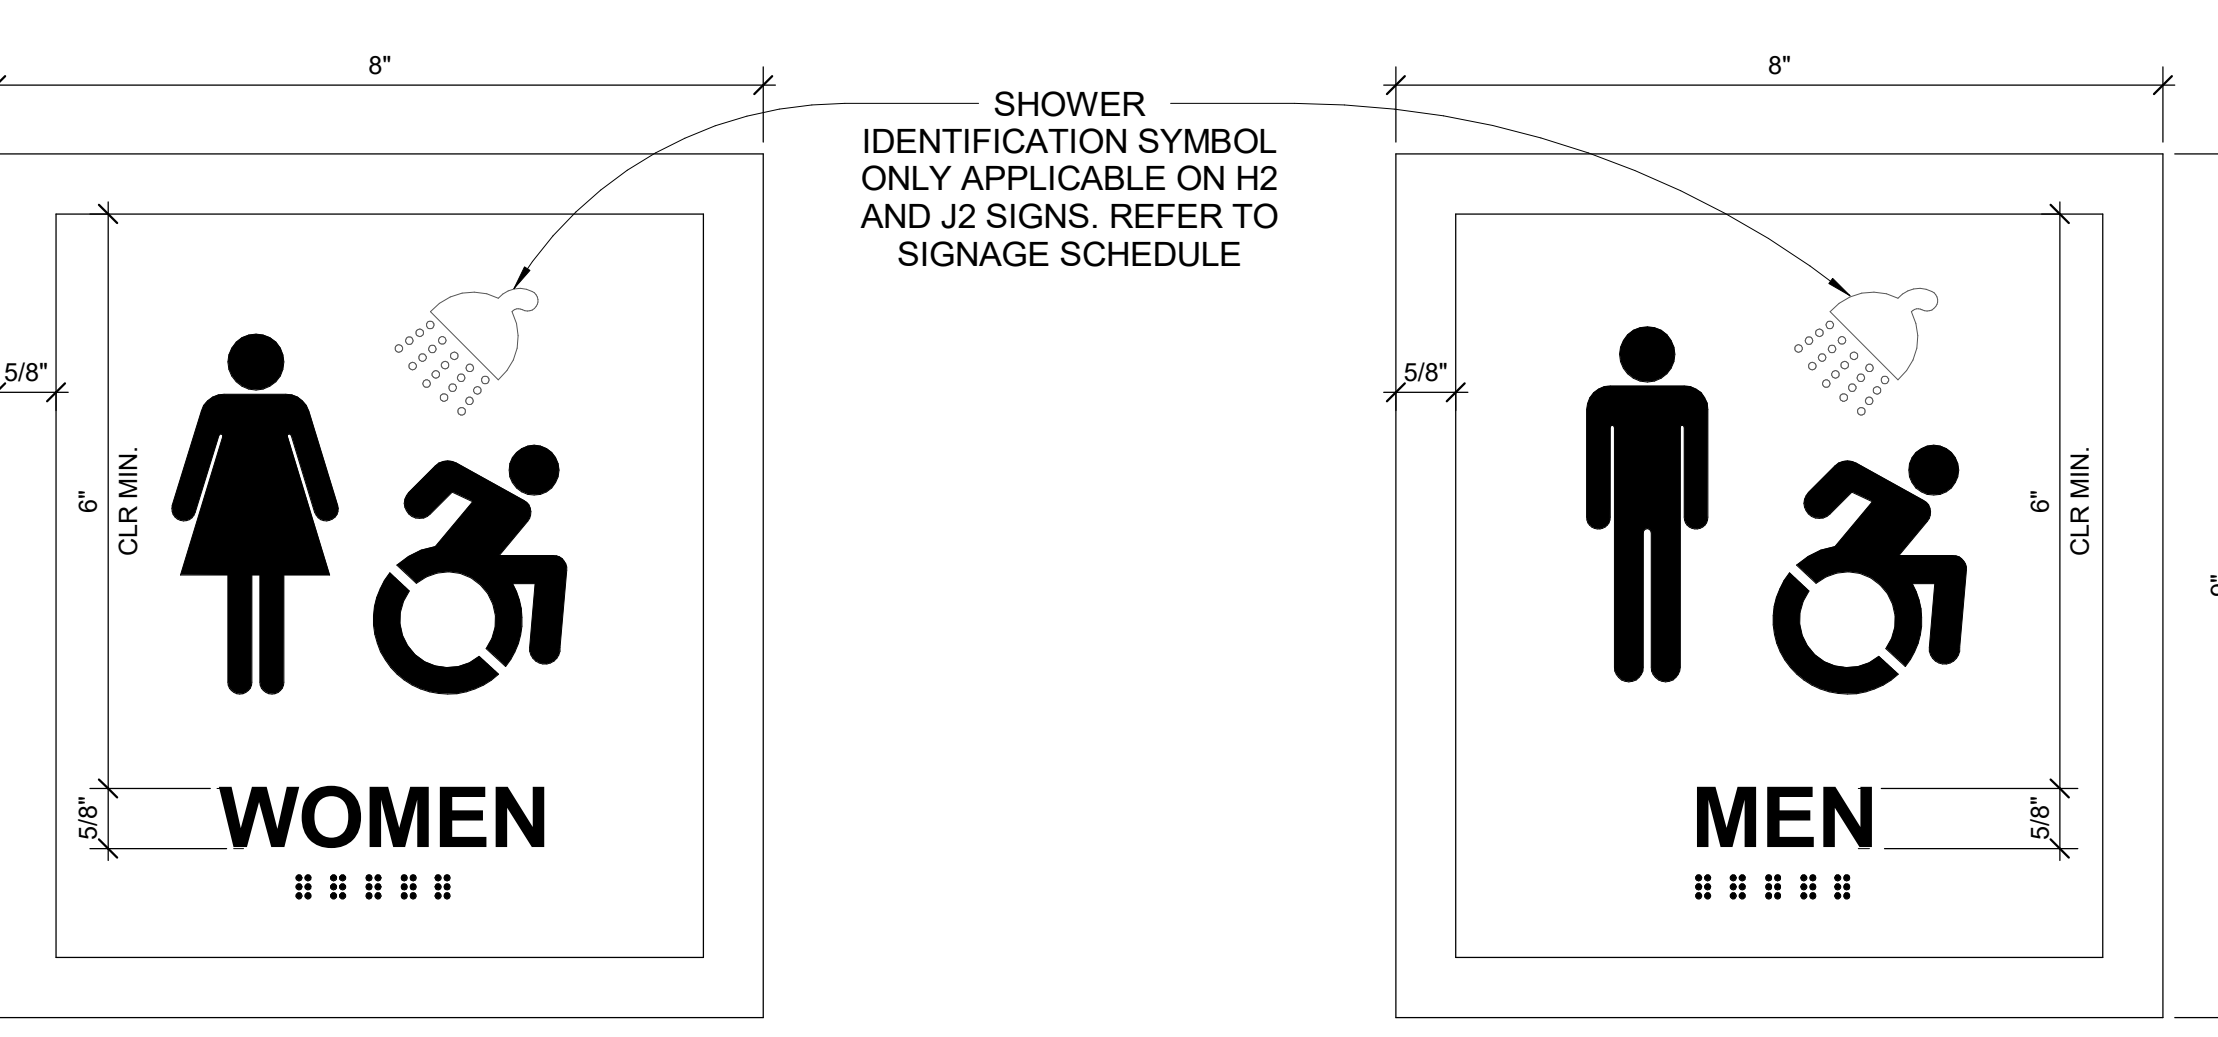


TYPE H
TOILET IDENTIFICATION SIGN
 (2 TRANSLUCENT STACKED LAYERS, AS PER MULBERRY PROVIDED SAMPLE)
 NOTE: ANNOTATIONS ARE SIMILAR TO TYPE G

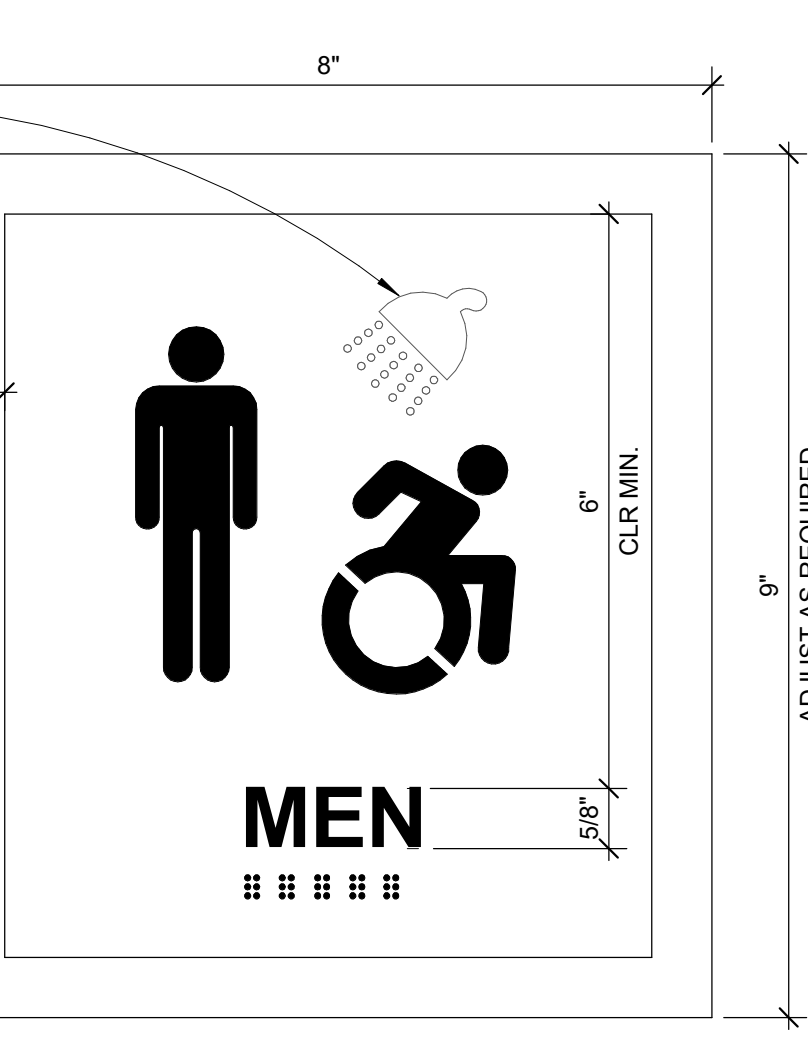


TYPE J
TOILET IDENTIFICATION SIGN
 (2 TRANSLUCENT STACKED LAYERS, AS PER MULBERRY PROVIDED SAMPLE)
 NOTE: ANNOTATIONS ARE SIMILAR TO TYPE G

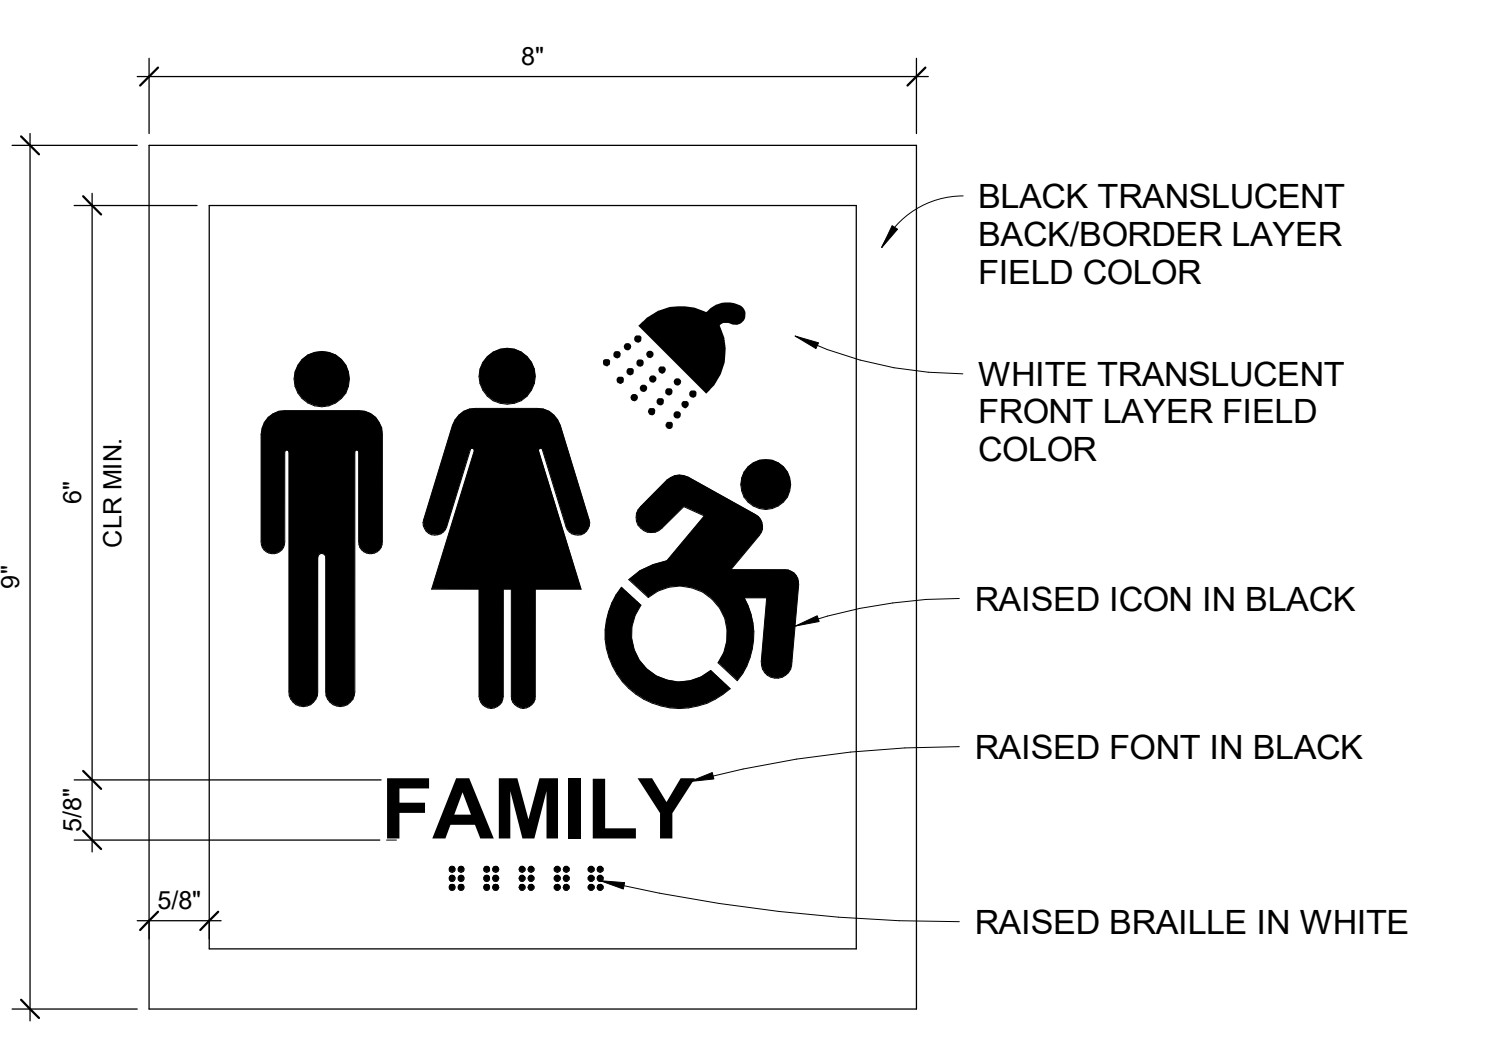


TYPE K
SINGLE USER WASH ROOM IDENTIFICATION SIGN
 (2 TRANSLUCENT STACKED LAYERS, AS PER MULBERRY PROVIDED SAMPLE)

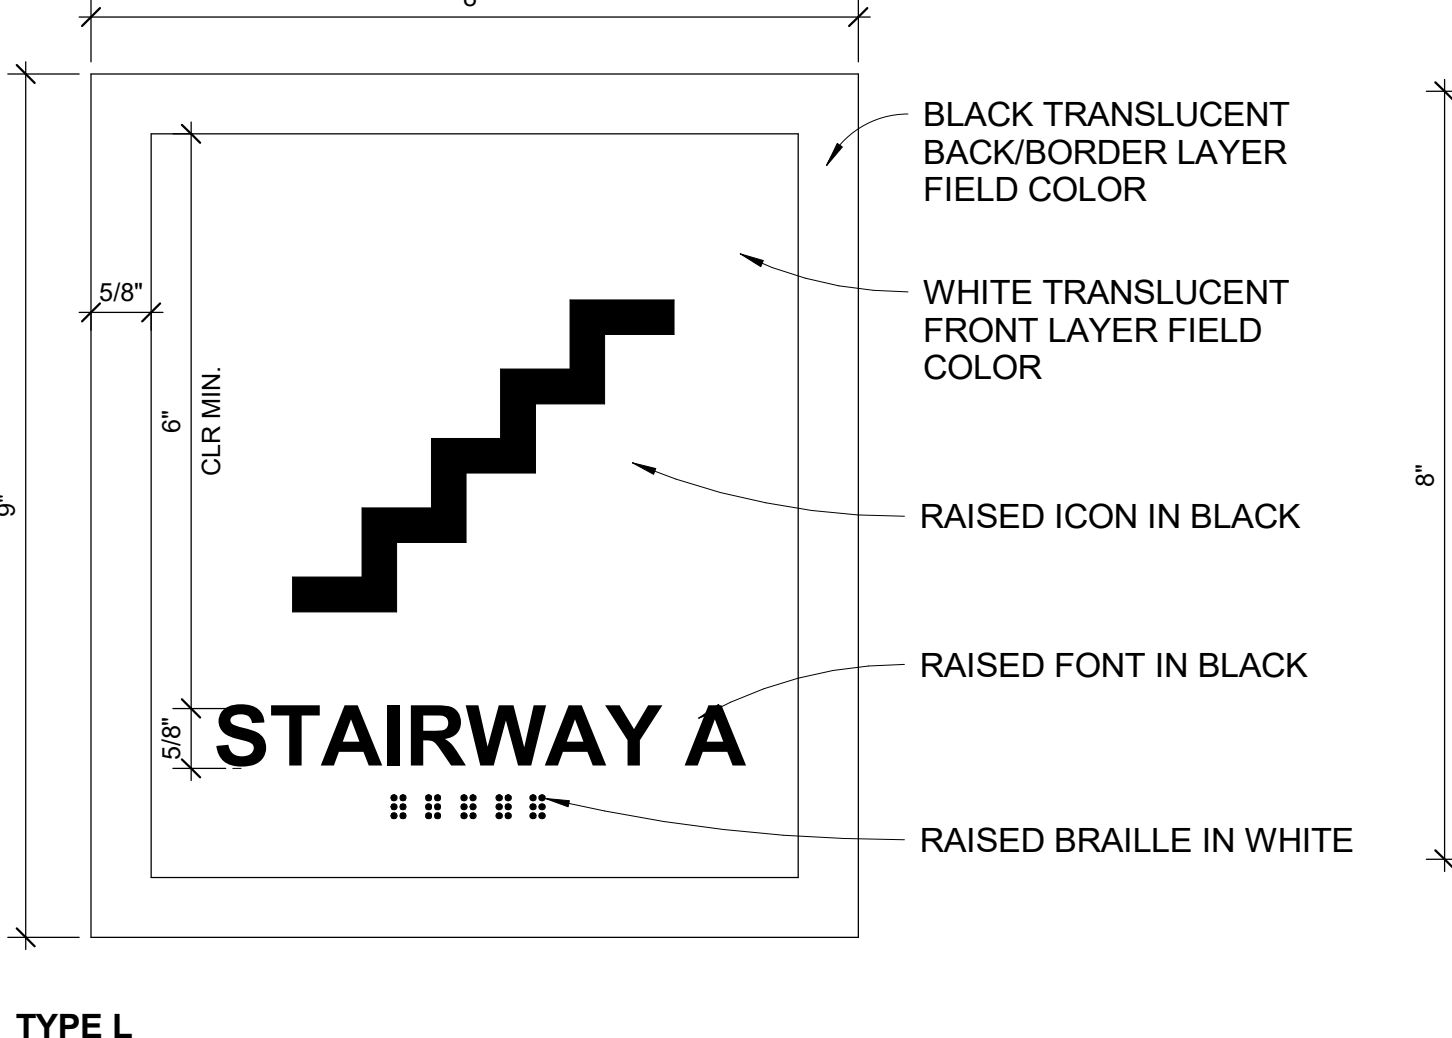


TYPE L
STAIR IDENTIFICATION SIGN
 (2 TRANSLUCENT STACKED LAYERS, AS PER MULBERRY PROVIDED SAMPLE)

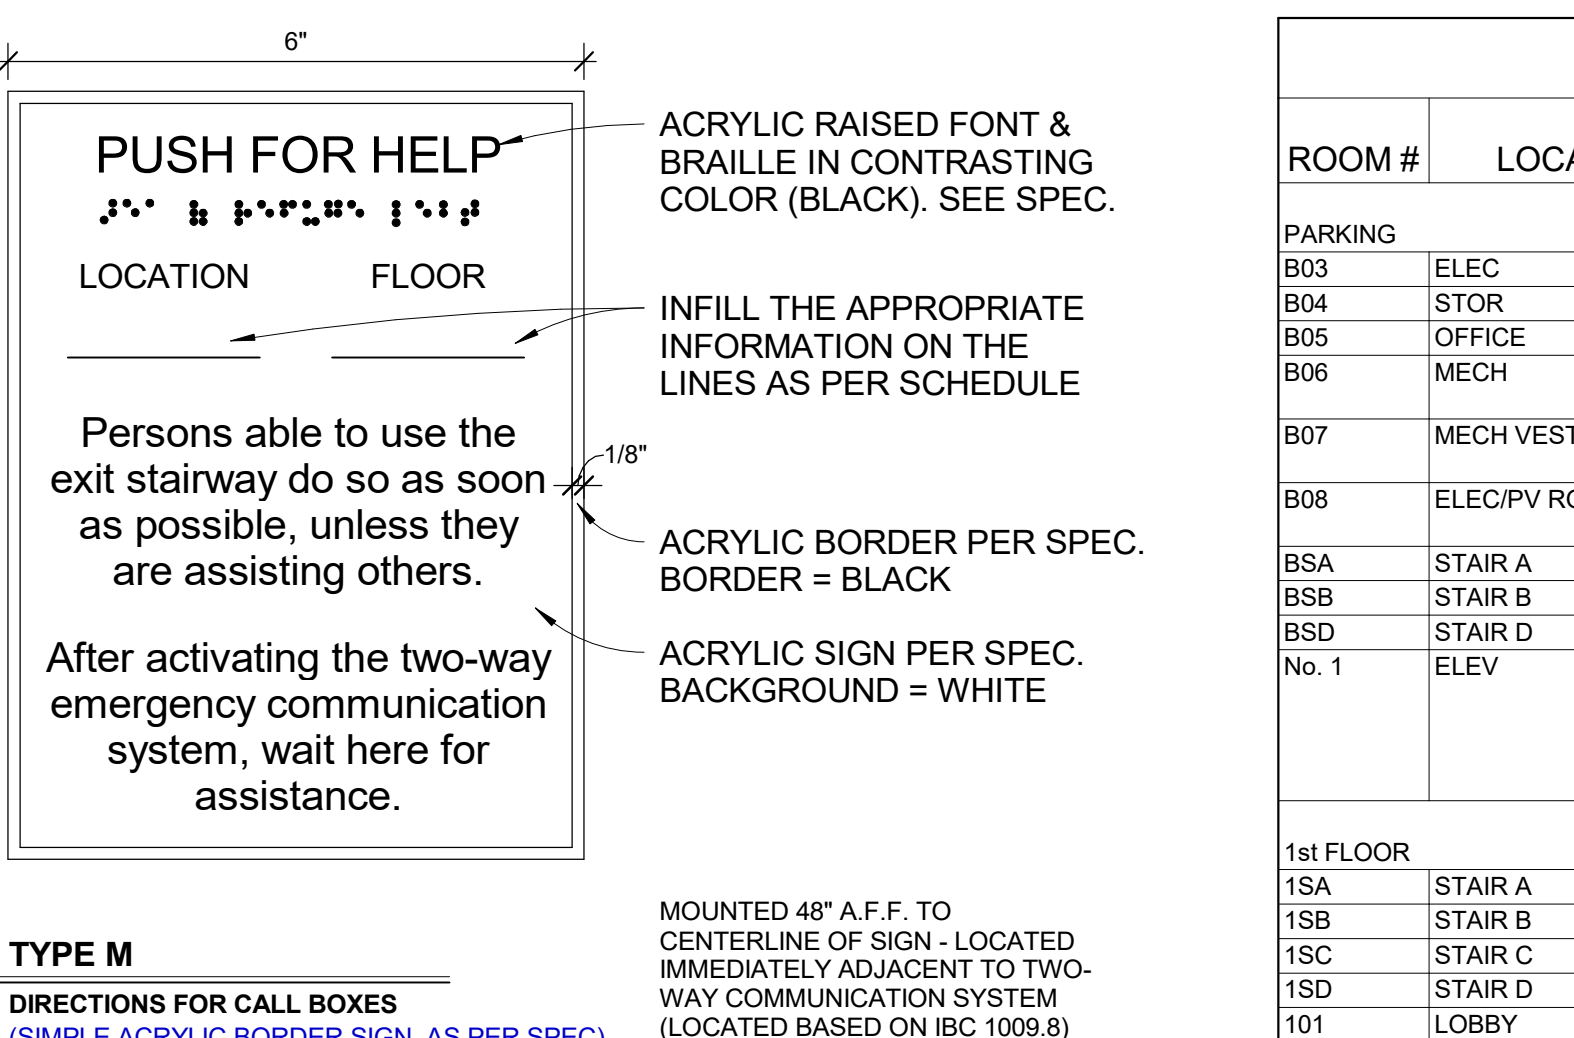


TYPE M
DIRECTIONS FOR CALL BOXES
 (SIMPLE ACRYLIC BORDER SIGN, AS PER SPEC)
 MOUNTED 48" A.F.F. TO CENTERLINE OF SIGN - LOCATED IMMEDIATELY ADJACENT TO TWO-WAY COMMUNICATION SYSTEM (LOCATED BASED ON IBC 1009.9)

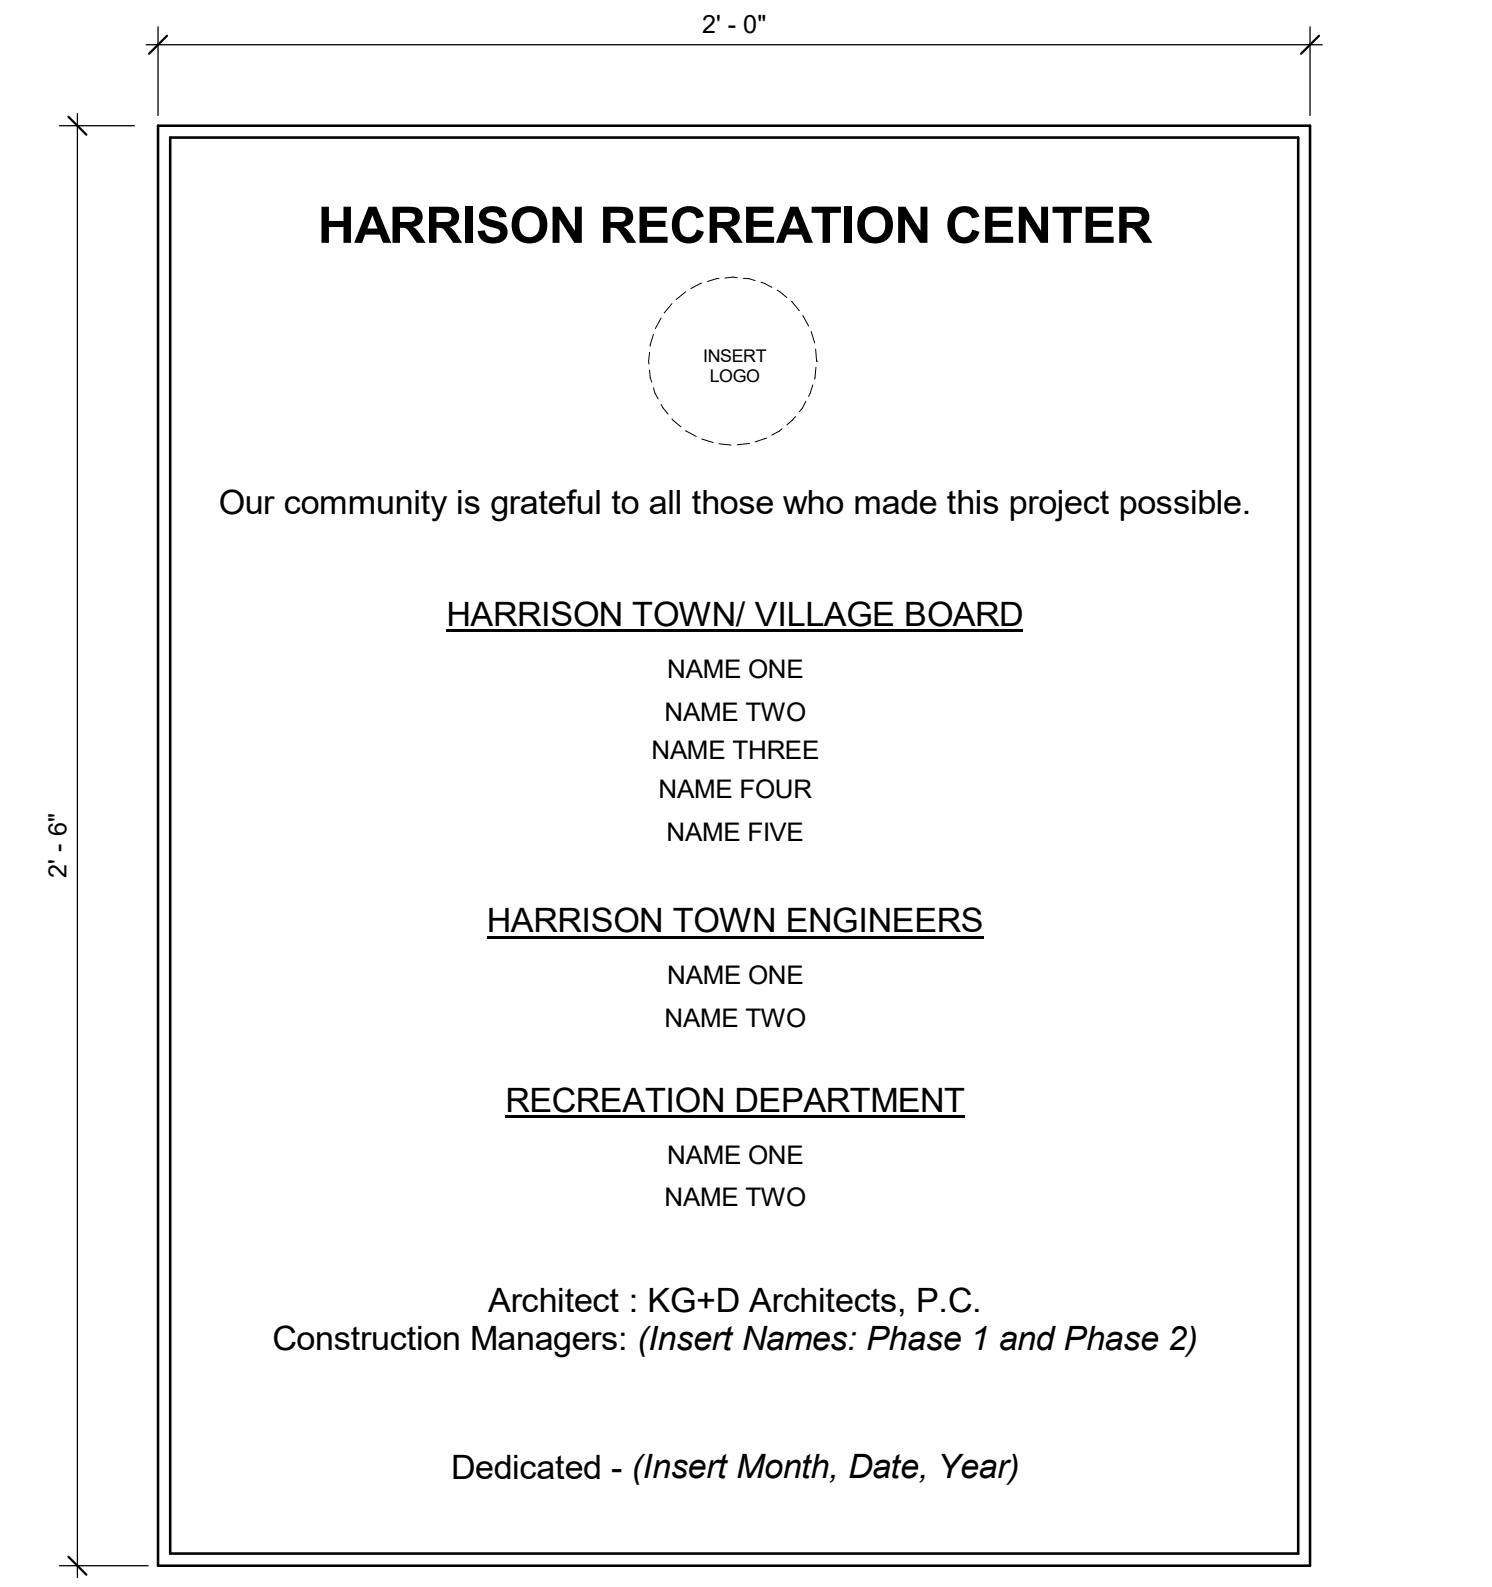


TYPE P
DEDICATION PLAQUE
 TEXT SHOWN ABOVE IS A CONCEPT DESIGN. (FINAL TEXT TO BE DETERMINED BY THE CLIENT)
 - CAST BRONZE PLAQUE WITH RAISE TEXT & BORDER
 - PROVIDE ONE SIGN, SEE ARCHITECT FOR FINAL LOCATION
 - SEE SPECIFICATION MANUAL FOR DETAILS
 CLIENT STILL WORKING ON PLAQUE TEXT/DESIGN. INFORMATION ON THE PLAQUE TO COME IN A SEPARATE BULLETIN

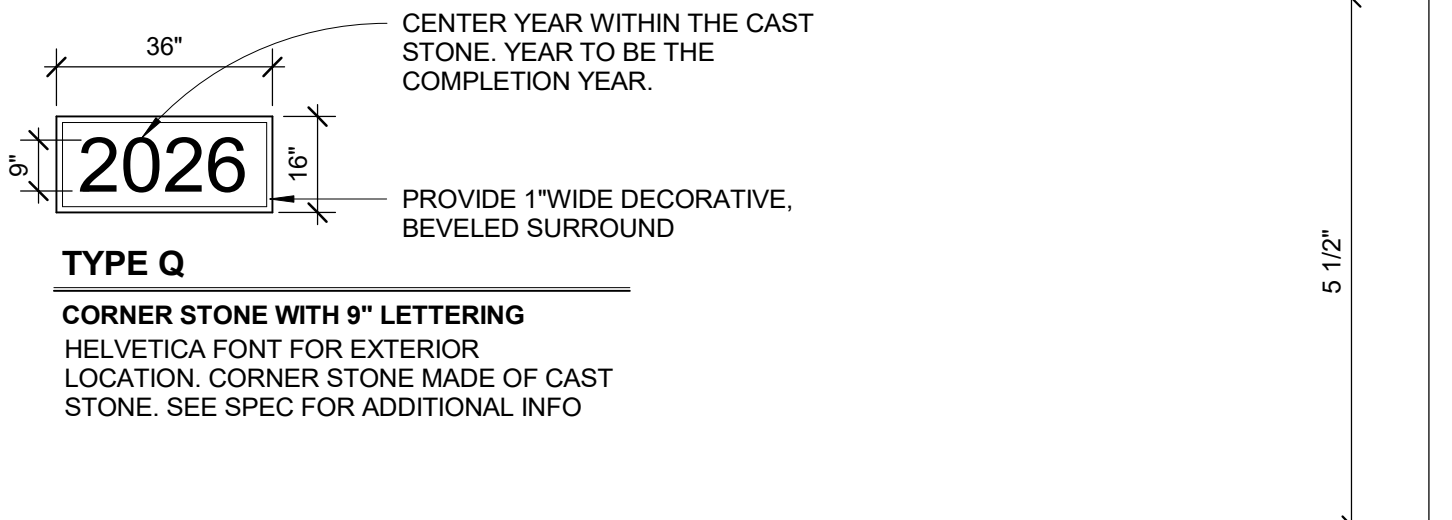


TYPE Q
CORNER STONE WITH 9" LETTERING
 HELVETICA FONT FOR EXTERIOR LOCATION. CORNER STONE MADE OF CAST STONE. SEE SPEC FOR ADDITIONAL INFO

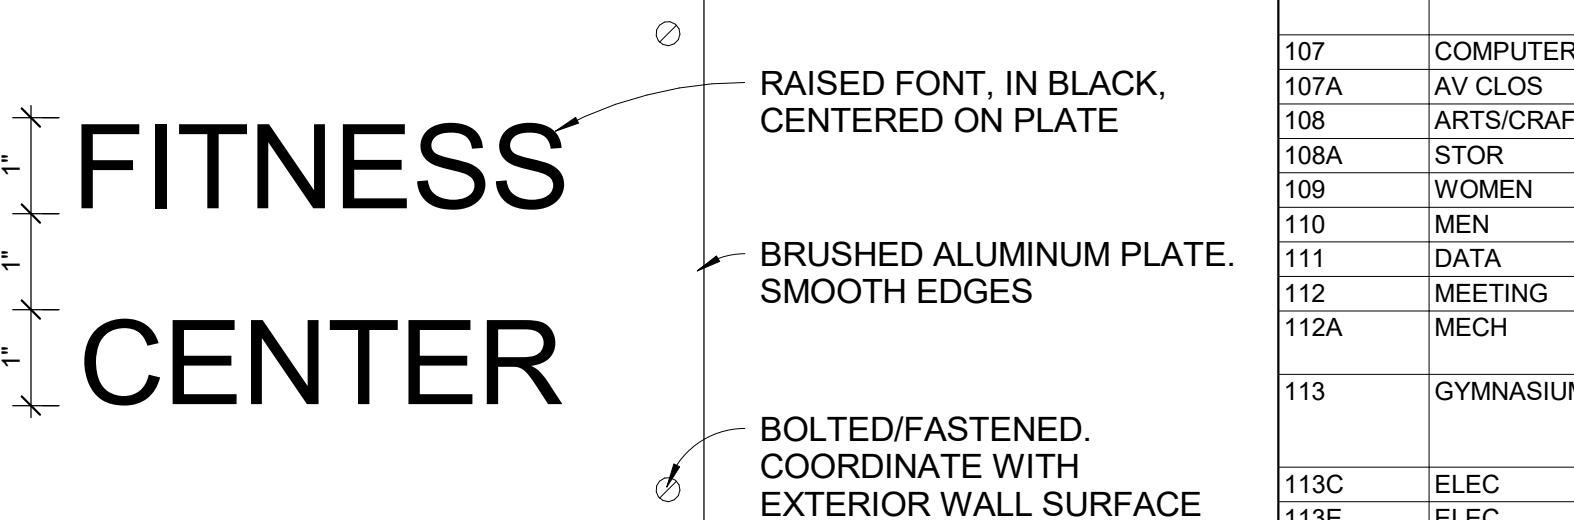


TYPE Y
GENERAL EXTERIOR PLATE SIGN
 (EXTERIOR, METAL PLATE SIGN)

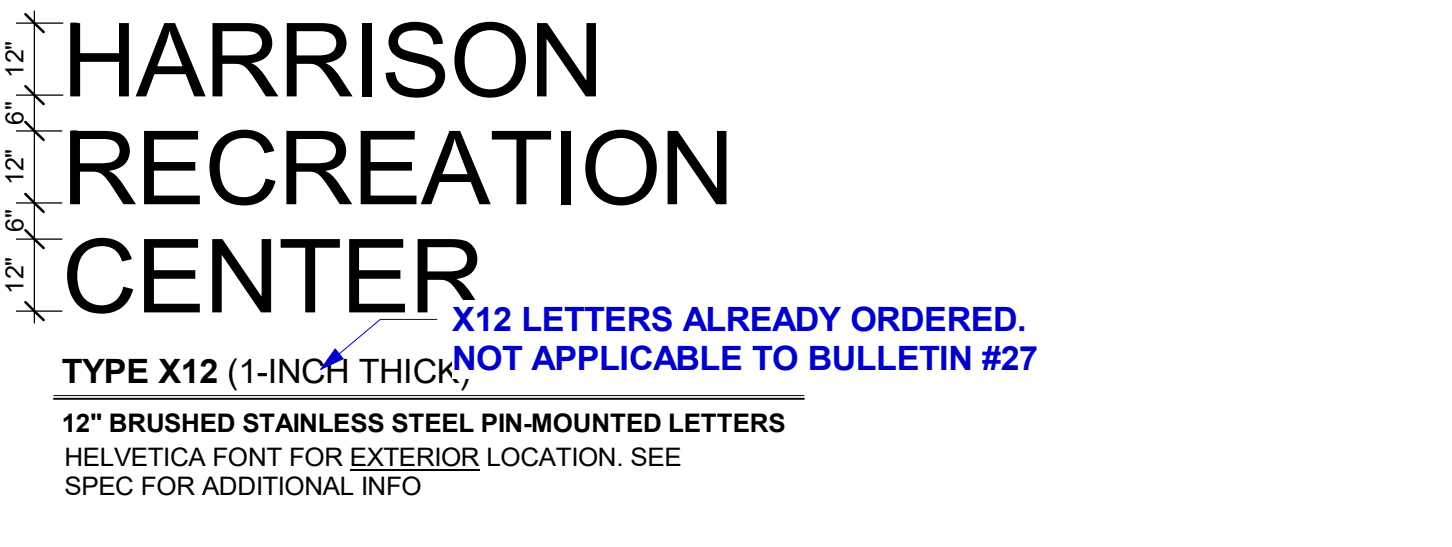

TYPE X12 (1-1/4" THICK)
12" BRUSHED STAINLESS STEEL PIN-MOUNTED LETTERS
 HELVETICA FONT FOR EXTERIOR LOCATION. SEE SPEC FOR ADDITIONAL INFO

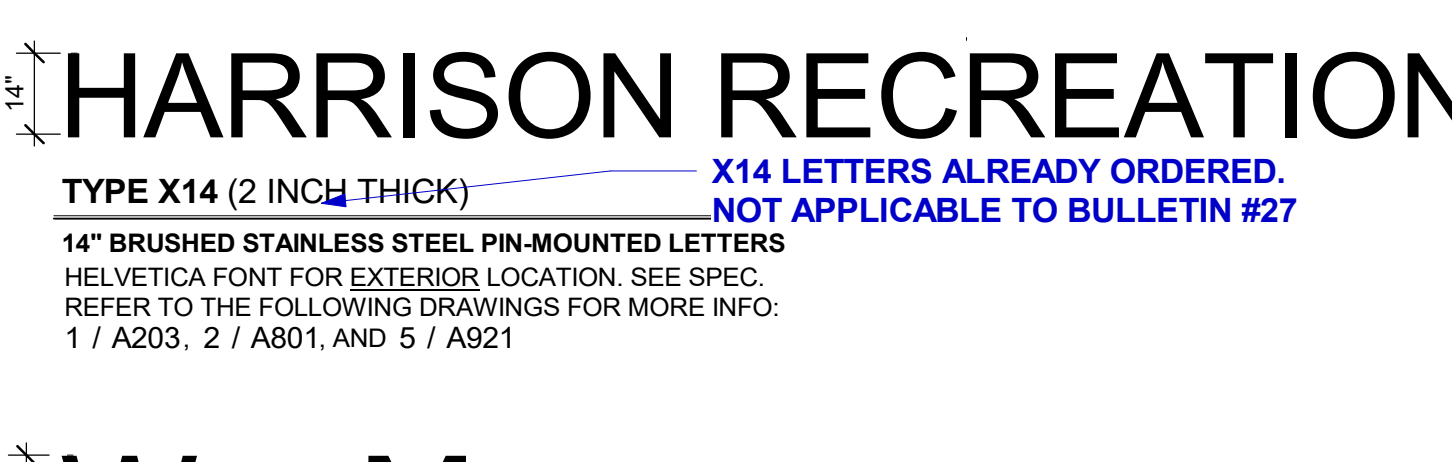

TYPE X14 (2 INCH THICK)
14" BRUSHED STAINLESS STEEL PIN-MOUNTED LETTERS
 HELVETICA FONT FOR EXTERIOR LOCATION. SEE SPEC FOR ADDITIONAL INFO

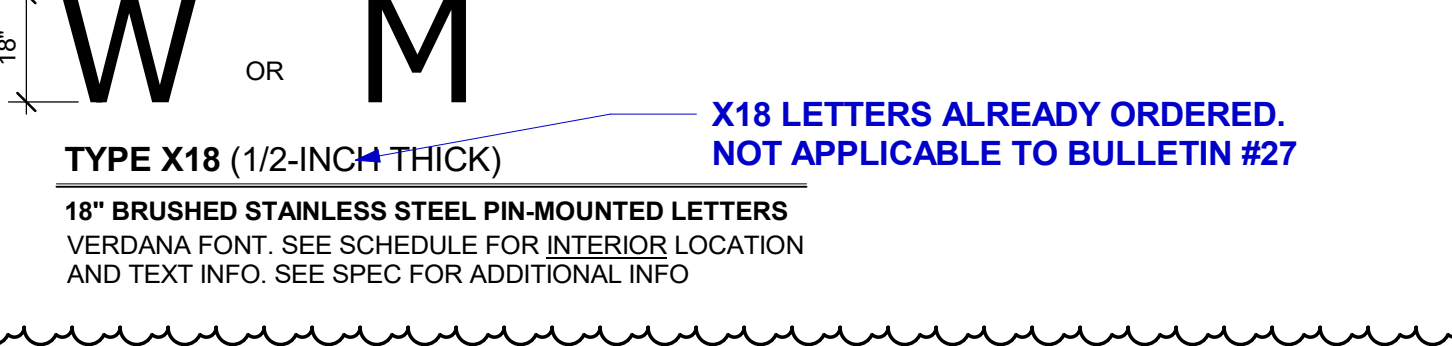

TYPE X18 (1/2-INCH THICK)
18" BRUSHED STAINLESS STEEL PIN-MOUNTED LETTERS
 VERDANA FONT. SEE SCHEDULE FOR INTERIOR LOCATION AND TEXT INFO. SEE SPEC FOR ADDITIONAL INFO

SIGNAGE SCHEDULE - UPDATED

ROOM #	LOCATION	SIGN TYPE	SIGN TEXT (TEXT TO BE CONFIRMED WITH OWNER)	DESCRIPTION	QTY	SIGNAGE COMMENTS
PARKING						
B03	ELEC	C	803 ELECTRICAL AUTHORIZED PERSONNEL ONLY	SEE TYPE C ON A530 FOR MORE DETAILS	1	
B04	STOR	A	B04 STORAGE	SEE TYPE A ON A530 FOR MORE DETAILS	2	
B05	OFFICE	A	B05 CUSTODIAL OFFICE	SEE TYPE A ON A530 FOR MORE DETAILS	1	
B06	MECH	C	B06 MECHANICAL ROOM AUTHORIZED PERSONNEL ONLY	SEE TYPE C ON A530 FOR MORE DETAILS	1	MOUNT SIGN OUTSIDE OF B06A
B07	MECH VEST	C	B07 MECHANICAL ROOM AUTHORIZED PERSONNEL ONLY	SEE TYPE C ON A530 FOR MORE DETAILS	1	MOUNT SIGN OUTSIDE OF B07
B08	ELEC/PIV ROOM	C	B08 ELECTRICAL ROOM AUTHORIZED PERSONNEL ONLY	SEE TYPE C ON A530 FOR MORE DETAILS	1	
B5A	STAIR A	L	STAIRWAY A	SEE TYPE L ON A530 FOR MORE DETAILS	1	
B5B	STAIR B	L	STAIRWAY B	SEE TYPE L ON A530 FOR MORE DETAILS	1	
B5D	STAIR D	L	STAIRWAY D	SEE TYPE L ON A530 FOR MORE DETAILS	1	
No. 1	ELEV	E	ELEVATOR	SEE TYPE E ON A530 FOR MORE DETAILS	3 (ONE @ EACH LEVEL)	
		F	IN CASE OF FIRE USE STAIRS	SEE TYPE F ON A530 FOR MORE DETAILS	3 (ONE @ EACH LEVEL)	
		M	ELEVATOR A (LOCATION) : FLOOR 2 (FLOOR)	SEE TYPE M ON A530 FOR MORE DETAILS	1 (@ 2ND FLOOR ONLY)	
1st FLOOR						
15A	STAIR A	L	STAIRWAY A	SEE TYPE L ON A530 FOR MORE DETAILS	1	
15B	STAIR B	L	STAIRWAY B	SEE TYPE L ON A530 FOR MORE DETAILS	1	
15C	STAIR C	L	STAIRWAY C	SEE TYPE L ON A530 FOR MORE DETAILS	1	
15D	STAIR D	L	STAIRWAY D	SEE TYPE L ON A530 FOR MORE DETAILS	1	
101	LOBBY	P	(TEXT TO BE DETERMINED BY OWNER)	SEE TYPE P ON A530 FOR MORE DETAILS	1	MOUNT SIGN BY STAIR D. REFER TO A202 FOR MOUNTING LOCATION
103	OPEN OFFICE	A	103 MAIN OFFICE	SEE TYPE A ON A530 FOR MORE DETAILS	1	
103B	CONF	A	103B CONFERENCE ROOM	SEE TYPE A ON A530 FOR MORE DETAILS	1	
104	JAN	A	104 JANITORS CLOSET	SEE TYPE A ON A530 FOR MORE DETAILS	1	
105	TOILET	G	SINGLE-USER RESTROOM	SEE TYPE G ON A530 FOR MORE DETAILS	1	
106	RECREATION GAME RM	A	106 REC ROOM	SEE TYPE A ON A530 FOR MORE DETAILS	2	
		D	MAXIMUM OCCUPANCY 78 PERSONS	SEE TYPE D ON A530 FOR MORE DETAILS	1	ADDED SIGN
107	COMPUTER/GAMING	A	107 GAMING ROOM	SEE TYPE A ON A530 FOR MORE DETAILS	1	
107A	AV CLOS	A	107A STORAGE	SEE TYPE A ON A530 FOR MORE DETAILS	1	
108	ARTS/CRAFTS	A	108 ARTS/CRAFTS	SEE TYPE A ON A530 FOR MORE DETAILS	1	
108A	STOR	A	108A STORAGE	SEE TYPE A ON A530 FOR MORE DETAILS	1	
109	WOMEN	H	WOMEN	SEE TYPE H ON A530 FOR MORE DETAILS	1	NO SHOWER SYMBOL
110	MEN	J	MEN	SEE TYPE J ON A530 FOR MORE DETAILS	1	NO SHOWER SYMBOL
111	DATA	A	111 DATA ROOM	SEE TYPE A ON A530 FOR MORE DETAILS	1	
112	MEETING	A	112 MEETING ROOM	SEE TYPE A ON A530 FOR MORE DETAILS	1	
112A	MECH	C	112A MECHANICAL ROOM AUTHORIZED PERSONNEL ONLY	SEE TYPE C ON A530 FOR MORE DETAILS	1	
113	GYMNASIUM	A	113 GYMNASIUM	SEE TYPE A ON A530 FOR MORE DETAILS	2	
		D	MAXIMUM OCCUPANCY 796 PERSONS	SEE TYPE D ON A530 FOR MORE DETAILS	2	QUANTITY CHANGED
113C	ELEC	C	113C ELECTRICAL AUTHORIZED PERSONNEL ONLY	SEE TYPE C ON A530 FOR MORE DETAILS	1	
113E	ELEC	C	113E ELECTRICAL AUTHORIZED PERSONNEL ONLY	SEE TYPE C ON A530 FOR MORE DETAILS	1	
115	LOCKER CORRIDOR	Y	FITNESS CENTER	SEE TYPE Y ON A530 FOR MORE DETAILS	1	MOUNT SIGN OUTSIDE OF DOOR 115. REFER TO A202 FOR MOUNTING LOCATION
116	WOMEN	H2	WOMENS LOCKER ROOM	SEE TYPE H ON A530 FOR MORE DETAILS	1	INCLUDE SHOWER SYMBOL
		X18	W	SEE TYPE X18 ON A 530 FOR MORE DETAILS	1	REFER TO A402 FOR MOUNTING LOCATION
118	FAMILY TOILET	K	FAMILY	SEE TYPE K ON A530 FOR MORE DETAILS	1	
119	JAN	A	119 JANITORS CLOSET	SEE TYPE A ON A530 FOR MORE DETAILS	1	
120	MEN	J2	MENS LOCKER ROOM	SEE TYPE J ON A530 FOR MORE DETAILS	1	INCLUDE SHOWER SYMBOL
		X18	M	SEE TYPE X18 ON A530 FOR MORE DETAILS	1	REFER TO A402 FOR MOUNTING LOCATION
123	FITNESS	A	123 FITNESS CENTER	SEE TYPE A ON A530 FOR MORE DETAILS	1	
		D	MAXIMUM OCCUPANCY 67 PERSONS	SEE TYPE D ON A530 FOR MORE DETAILS	1	ADDED SIGN
123A	STOR	A	123A STORAGE	SEE TYPE A ON A530 FOR MORE DETAILS	1	
2nd FLOOR						
25A	STAIR A	L	STAIRWAY A	SEE TYPE L ON A530 FOR MORE DETAILS	1	
25B	STAIR B	L	STAIRWAY B	SEE TYPE L ON A530 FOR MORE DETAILS	1	
25C	STAIR C	L	STAIRWAY C	SEE TYPE L ON A530 FOR MORE DETAILS	1	
202	MULTI-PURPOSE	A	202 GRAND COMMUNITY ROOM A	SEE TYPE A ON A530 FOR MORE DETAILS	2	
		D	MAXIMUM OCCUPANCY 135 PERSONS	SEE TYPE D ON A530 FOR MORE DETAILS	1	ADDED SIGN
203	MULTI-PURPOSE	A	203 GRAND COMMUNITY ROOM B	SEE TYPE A ON A530 FOR MORE DETAILS	2	
		D	MAXIMUM OCCUPANCY 90 PERSONS	SEE TYPE D ON A530 FOR MORE DETAILS	1	ADDED SIGN
205A	DATA	A	205A DATA ROOM	SEE TYPE A ON A530 FOR MORE DETAILS	1	
205B	STOR	A	205A STORAGE	SEE TYPE A ON A530 FOR MORE DETAILS	1	
206	PANTRY	A	206 PANTRY	SEE TYPE A ON A530 FOR MORE DETAILS	1	
207	WOMEN	H	WOMEN	SEE TYPE H ON A530 FOR MORE DETAILS	1	NO SHOWER SYMBOL
208	MEN	J	MEN	SEE TYPE J ON A530 FOR MORE DETAILS	1	NO SHOWER SYMBOL
209	ELEC	C	209 ELECTRICAL AUTHORIZED PERSONNEL ONLY	SEE TYPE C ON A530 FOR MORE DETAILS	1	
209A	EMR	C	209A MACHINE ROOM AUTHORIZED PERSONNEL ONLY	SEE TYPE C ON A530 FOR MORE DETAILS	1	
210	JAN	A	210 JANITORS CLOSET	SEE TYPE A ON A530 FOR MORE DETAILS	1	
211	TOILET	G	SINGLE-USER RESTROOM	SEE TYPE G ON A530 FOR MORE DETAILS	1	
212	OPEN OFFICE	A	212 SUPERINTENDENT OF RECREATION	SEE TYPE A ON A530 FOR MORE DETAILS	1	
212A	OFFICE	A	212A SUPERINTENDENT OFFICE	SEE TYPE A ON A530 FOR MORE DETAILS	1	

NOTE: ALL IDEAS, DESIGN ARRANGEMENTS AND PLANS INDICATED OR REPRESENTED BY THIS DRAWING ARE OWNED BY AND ARE THE PROPERTY OF KG+D ARCHITECTS, PC. NO OTHER USE OR REPRODUCTION OF THIS PROJECT, NAME OF SUCH IDEAS, DESIGN ARRANGEMENTS OR PLANS SHALL BE USED BY OR FOR ANY OTHER PROJECT WITHOUT THE WRITTEN PERMISSION OF KG+D.

WITHIN DIMENSIONS ON THIS DRAWING SHALL HAVE PRECEDENCE OVER SCHEDULE DIMENSIONS. CONTRACTOR SHALL VERIFY ALL ACTUAL DIMENSIONS AND CONDITIONS ON THE JOB AND THE ARCHITECT MUST BE NOTIFIED OF ANY VARIATIONS FROM DIMENSIONS AND CONDITIONS BEFORE PROCEEDING WITH INSTALLATION.

ALTERATIONS BY ANY PERSON IN ANY WAY OF ANY ITEM CONTAINED ON THIS DOCUMENT, UNLESS ACTING UNDER THE DIRECTION OF THE LICENSED ARCHITECT, ENGINEER, PROFESSIONAL DESIGNER OR ARCHITECT, IS A VIOLATION OF TITLE 16, SECTION 803.05 OF NEW YORK STATE LAW.

ALL RIGHTS RESERVED.

Professional Seal

No.	Date	Issue
13	03/13/2026	BULLETIN #27
17	10/09/2024	CONFORMED SET
4	06/05/2024	ISSUED FOR BID
3	01/16/2024	ISSUED FOR PERMIT
2	06/01/2020	DESIGN DEVELOPMENT
1	03/31/2020	50% DESIGN DEVELOPMENT

Sheet Title

SIGNAGE TYPES AND SCHEDULE

Job No. 2020-1005 Date

Scale AS NOTED Drawn / Checked

Sheet Number

A530.