

BULLETIN # 03

DATE: November 27, 2023

TO: Laura Li Industries, LLC
Attn: Vincent Sessano

FROM: Brian Dunn, AIA
KG+D Architects, PC

PROJECT: Harrison Recreation & Community Center – PHASE 1
Harrison, NY

RE: Revised foundation Insulation- Reference RFI-14

Message:

Per the attached ASK-03 delete the 2” rigid insulation located on the interior side of the foundation wall. Please provide a PCO for the deleted material.


Cc: Town of Harrison Engineering Department
File

Encl: ASK-03



KG+D Architects, PC

285 Main Street, Mount Kisco, New York 10549
914.666.5900 kgdarchitects.com

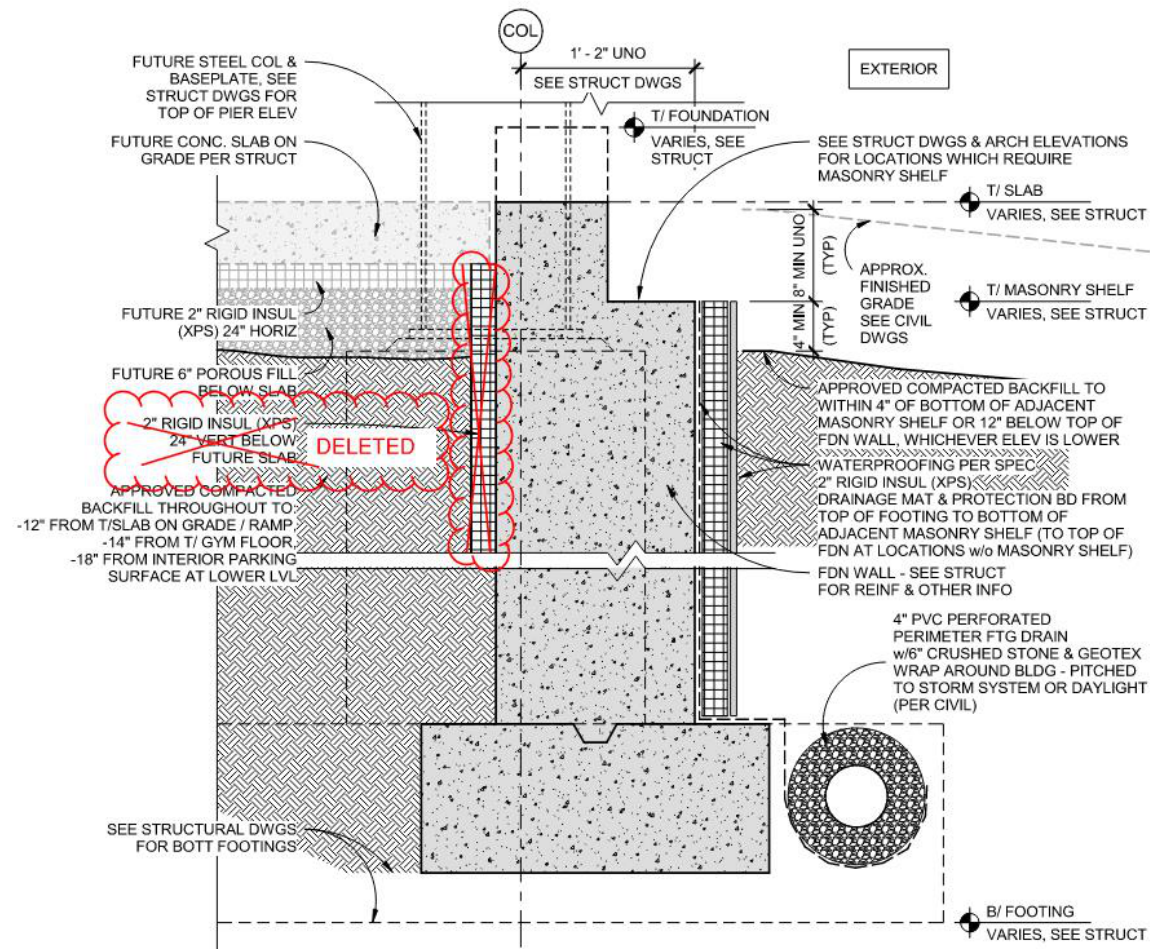

THIS DETAIL IS INTENDED TO SHOW TYPICAL COMPONENTS REQUIRED AT PERIMETER FOUNDATION WALLS. GC SHALL PROVIDE FOUNDATION DRAINAGE, WATERPROOFING, THERMAL CONTROL, PROTECTION BOARD & BACKFILL TO THE EXTENT AS SHOWN & NOTED. ELEVATIONS SHOWN VARY GREATLY THROUGHOUT THE FOUNDATIONS. SEE STRUCTURAL DRAWINGS FOR ACTUAL FOUNDATION WALL CONFIGURATIONS.

1 TYPICAL FOUNDATION SECTION DETAIL
1 1/2" = 1'-0"



HARRISON RECREATION & COMMUNITY CENTER
Town / Village of Harrison
Project Issue Date: JUNE 05, 2023

Sheet Title
REVISED FOUNDATION INSULATION

Job No.
2020-1005
Date
11/27/23
Scale
Drawn / Checked
BD

Sheet No.
ASK-3