



AIA[®] Document G710[™] – 2017

Architect's Supplemental Instructions

PROJECT: *(name and address)*
57-21113-00 - Rebid Dutchess Stadium
New Left Field Clubhouse, Seating Bowl,
& Restroom Building

CONTRACT INFORMATION:
Contract For: General Construction

ASI INFORMATION:
ASI Number: 011

Date:

Date: November 7, 2023

OWNER: *(name and address)*
Dutchess County
22 Market Street
Poughkeepsie, NY 12601

ARCHITECT: *(name and address)*
DLR Group Architecture and Engineering,
P.C., a New York professional corporation
33 East 33rd Street, Suite 401
New York, NY 10016

CONTRACTOR: *(name and address)*
Piazza, Inc.
3 W Stevens Avenue
Hawthorne, NY 10532

The Contractor shall carry out the Work in accordance with the following supplemental instructions without change in Contract Sum or Contract Time. Proceeding with the Work in accordance with these instructions indicates your acknowledgment that there will be no change in the Contract Sum or Contract Time.
(Insert a detailed description of the Architect's supplemental instructions and, if applicable, attach or reference specific exhibits.)

Modify the Contract Documents per the attachments and generally as follows:

1. Sheet G0.00ii - COVER SHEET
 - a. Modifications per the attached sheet.
2. Sheet G0.01ii - INDEX OF DRAWINGS
 - a. Modifications per the attached sheet.
3. Sheet C0.1.ii - CIVIL GENERAL NOTES
 - a. Modifications per the attached sheet.
4. Sheet C0.1.iii - CIVIL UTILITY NOTES
 - a. Modifications per the attached sheet.
5. Sheet C4.1.ii - CIVIL UTILITY PLAN 1
 - a. Modifications per the attached sheet.
6. Sheet C5.1.ii - CIVIL DETAILS
 - a. Modifications per the attached sheet.
7. Sheet C5.1.iii - CIVIL DETAILS 2
 - a. Modifications per the attached sheet.
8. Sheet A1.2A.ii - FLOOR PLAN - AREA A - LEVEL 2
 - a. Modifications per the attached sheet.
9. Sheet A2.1.ii - FIRE PROTECTION PLANS - AREA A
 - a. Modifications per the attached sheet.
10. Sheet FP1.1A.ii - ENLARGED FLOOR PLANS
 - a. Modifications per the attached sheet.
11. Sheet P0.1.ii - GENERAL NOTES, PLUMBING SYMBOLS & ABBREVIATIONS
 - a. Modifications per the attached sheet.
12. Sheet P1.1A.1.ii - UNDERGROUND PLUMBING PLAN - AREA A - DOMESTIC
 - a. Modifications per the attached sheet.
13. Sheet P1.1A.2.ii - UNDERGROUND PLUMBING PLAN - AREA A - DRAINAGE
 - a. Modifications per the attached sheet.
14. Sheet P2.1A.ii - PLUMBING PLAN - AREA A - LEVEL 1
 - a. Modifications per the attached sheet.
15. Sheet P2.1A.1.ii - PLUMBING PLAN - AREA A - LEVEL 1 - DOMESTIC
 - a. Modifications per the attached sheet.
16. Sheet P2.1A.2.ii - PLUMBING PLAN - AREA A - LEVEL 1 - DRAINAGE
 - a. Modifications per the attached sheet.

17. Sheet P2.2A.1.ii - PLUMBING PLAN - AREA A- LEVEL 2 - DOMESTIC
 - a. Modifications per the attached sheet.
18. Sheet P2.2A.2.ii - PLUMBING PLAN - AREA A- LEVEL 2 - DRAINAGE
 - a. Modifications per the attached sheet.
19. Sheet P3.1.ii - ENLARGED PLUMBING PLANS AND SECTIONS
 - a. Modifications per the attached sheet.
20. Sheet P5.1.ii - PLUMBING DETAILS
 - a. Modifications per the attached sheet.
21. Sheet P6.1.ii - PLUMBING SCHEDULES
 - a. Modifications per the attached sheet.


Attachment(s):

Revised Sheet G0.00ii - COVER SHEET
Revised Sheet G0.01ii - INDEX OF DRAWINGS
Revised Sheet C0.1.ii - CIVIL GENERAL NOTES
Revised Sheet C0.1.iii - CIVIL UTILITY NOTES
Revised Sheet C4.1.ii - CIVIL UTILITY PLAN 1
Revised Sheet C5.1.iii - CIVIL DETAILS 2
Revised Sheet A1.2A.ii - FLOOR PLAN - AREA A - LEVEL 2
Revised Sheet A2.1.ii - FIRE PROTECTION PLANS - AREA A
Revised Sheet FP1.1A.ii - ENLARGED FLOOR PLANS
Revised Sheet P0.1.ii - GENERAL NOTES, PLUMBING SYMBOLS & ABBREVIATIONS
Revised Sheet P1.1A.1.ii - UNDERGROUND PLUMBING PLAN - AREA A - DOMESTIC
Revised Sheet P1.1A.2.ii - UNDERGROUND PLUMBING PLAN - AREA A - DRAINAGE
Revised Sheet P2.1A.ii - PLUMBING PLAN - AREA A- LEVEL 1
Revised Sheet P2.1A.1.ii - PLUMBING PLAN - AREA A- LEVEL 1 - DOMESTIC
Revised Sheet P2.1A.2.ii - PLUMBING PLAN - AREA A- LEVEL 1 - DRAINAGE
Revised Sheet P2.2A.1.ii - PLUMBING PLAN - AREA A- LEVEL 2 - DOMESTIC
Revised Sheet P2.2A.2.ii - PLUMBING PLAN - AREA A- LEVEL 2 - DRAINAGE
Revised Sheet P3.1.ii - ENLARGED PLUMBING PLANS AND SECTIONS
Revised Sheet P5.1.ii - PLUMBING DETAILS
Revised Sheet P6.1.ii - PLUMBING SCHEDULES

ISSUED BY THE ARCHITECT:

DLR Group Architecture and Engineering,
P.C., a New York professional corporation

ARCHITECT (*Firm name*)

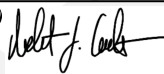

SIGNATURE

Bob Carlson, AIA, LEED AP,
Principal

PRINTED NAME AND TITLE

November 7, 2023


DATE

REBID DUTCHESS STADIUM NEW LEFT FIELD CLUBHOUSE, SEATING BOWL, & RESTROOM BUILDING

1500 ROUTE 9D FISHKILL, NY 12590
TAX PARCEL #133089-6055-01-182629

SINGLE PRIME CONTRACT RFB-DCB-18-22

NOVEMBER 4, 2022

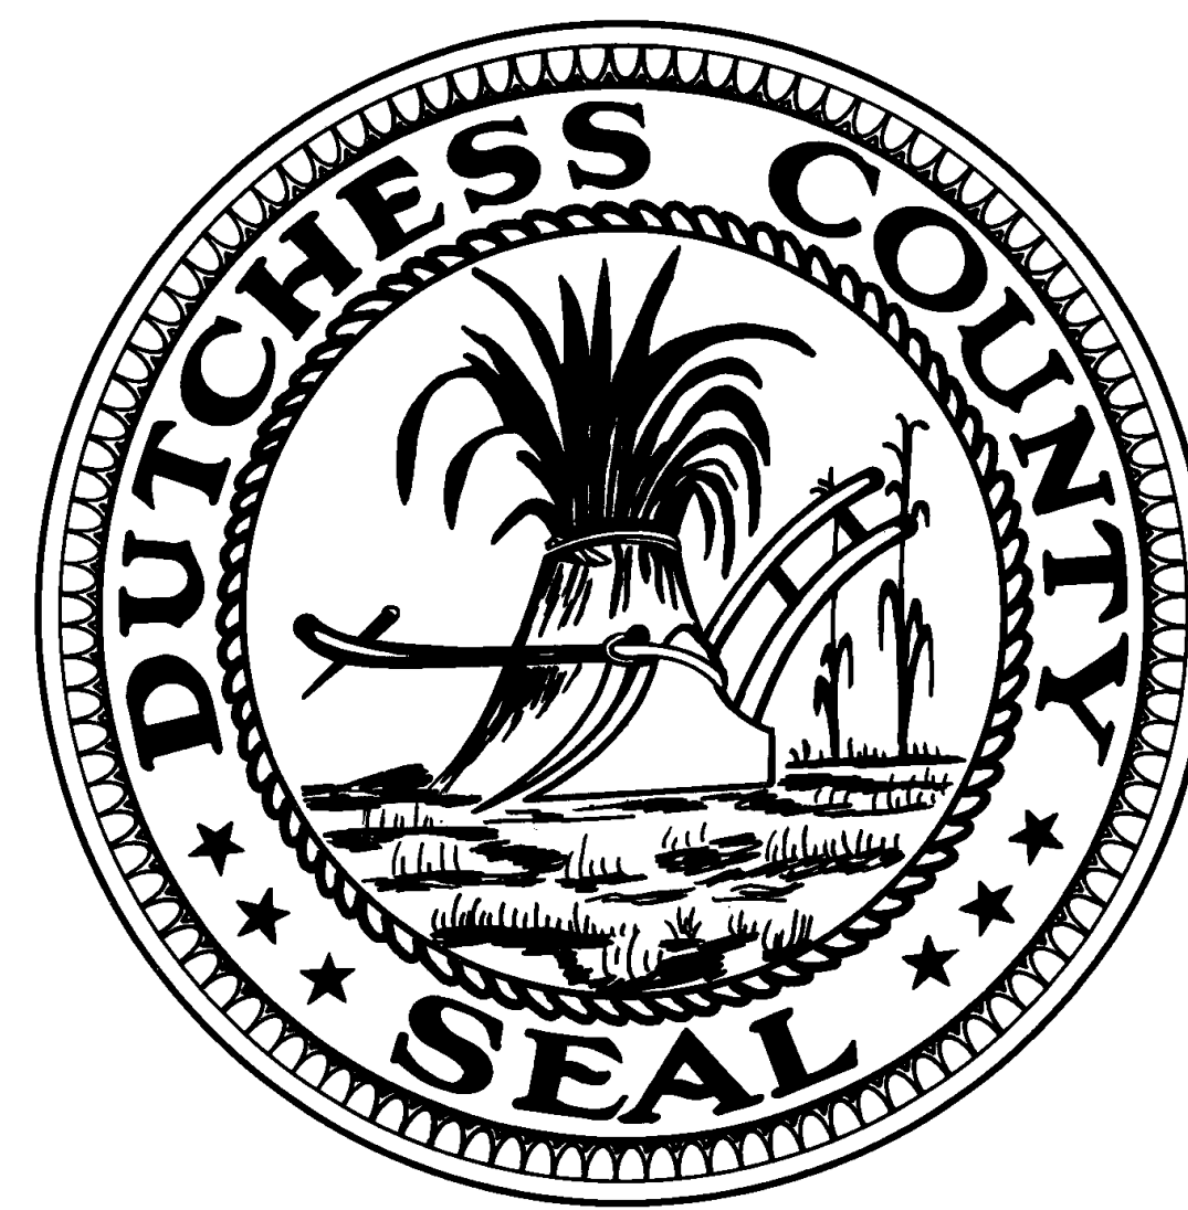

MARCUS J. MOLINARO
DUTCHESS COUNTY EXECUTIVE

ROBERT H. BALKIND, P.E.
DUTCHESS COUNTY DPW COMMISSIONER

OWNER: DUTCHESS COUNTY
22 MARKET STREET POUGHKEEPSIE, NY 12601

PROJECT LOCATION MAP



DLR Group
Architecture Engineering Planning Interiors

ARCHITECTURE & INTERIOR DESIGN
MECHANICAL & PLUMBING ENGINEERING
ELECTRICAL ENGINEERING
AUDIOVISUAL

HVEA
ENGINEERS

CIVIL ENGINEERING

INSITE
ENGINEERING, SURVEYING &
LANDSCAPE ARCHITECTURE, P.C.

LANDSCAPE ARCHITECTURE

FL
FOOD LINES
FOOD SERVICE DESIGN
CONSULTANTS

110 S. 14th Street, Suite 200
Lincoln, NE 68508
Tel 402.475.1787



REBID DUTCHESS STADIUM NEW LEFT FIELD CLUBHOUSE, SEATING BOWL, & RESTROOM BUILDING
OWNER: DUTCHESS COUNTY, 22 MARKET STREET POUGHKEEPSIE, NY 12601

BID SET
11.04.22
REVISIONS
1 CONSTRUCTION DOCS 03.05.23
2 AS NOTED 04.07.23
3 AS NOTED 11.07.23

57-21113-00
COVER SHEET

GO.00.ii

BM 360/67-21113-00_Dutchess Stadium Ph1 (057-21113-00_Dutchess Stadium_Ph1_AR_2020.rvt 11/7/2023 11:48:33 AM)

INDEX OF DRAWINGS

GENERAL	ARCHITECTURAL	FIRE PROTECTION	ELECTRICAL
<ul style="list-style-type: none"> G0.00.i COVER SHEET G0.01.i INDEX OF DRAWINGS G1.00.i CONSTRUCTION PHASING PLAN 	<ul style="list-style-type: none"> A8.20.i DOOR & FRAME DETAILS A8.21.i DOOR & FRAME DETAILS A10.1.i INTERIOR ELEVATIONS A10.2.i INTERIOR ELEVATIONS A11.1.i INTERIOR DETAILS A11.2.i INTERIOR DETAILS A11.3.i INTERIOR DETAILS A11.4.i INTERIOR DETAILS A11.5.i INTERIOR DETAILS A12.01.i FINISH SCHEDULES A12.1A.i FIRST FLOOR FINISH PLAN A12.2A.i SECOND FLOOR FINISH PLAN A13.1.i SEATING PLAN A13.2A.i FIRST FLOOR FF&E PLAN - AREA A A13.3A.i SECOND FLOOR FF&E PLAN - AREA A A14.1.i INTERIOR SIGNAGE ELEVATIONS A14.3.i SIGNAGE PLAN - FIRST FLOOR A14.4.i SIGNAGE PLAN - SECOND FLOOR 	<ul style="list-style-type: none"> FP0.1.i GENERAL NOTES, FIRE PROTECTION SYMBOLS & ABBREVIATIONS FP1.1A.i FIRE PROTECTION PLANS - AREA A FP3.1.i FIRE PROTECTION DETAILS & SCHEDULES 	<ul style="list-style-type: none"> E0.1.i ELECTRICAL SYMBOLS, ABBREVIATIONS & NOTES ESD1.1.i ELECTRICAL SITE DEMOLITION PLAN ES1.1.i ELECTRICAL SITE PLAN E1.1A.i LIGHTING PLAN - AREA A - LEVEL 1 E1.2A.i LIGHTING PLAN - AREA A - LEVEL 2 E2.1A.i POWER PLAN - AREA A - LEVEL 1 E2.2A.i POWER PLAN - AREA A - LEVEL 2 E3.1A.i SPECIAL SYSTEMS PLAN - AREA A - LEVEL 1 E3.2A.i SPECIAL SYSTEMS PLAN - AREA A - LEVEL 2 E4.1.i ENLARGED ELECTRICAL PLANS E5.1.i ELECTRICAL DIAGRAMS E6.1.i ELECTRICAL DETAILS E6.2.i ELECTRICAL DETAILS E6.3.i ELECTRICAL DETAILS E7.1.i ELECTRICAL SCHEDULES E7.2.i ELECTRICAL SCHEDULES E7.3.i ELECTRICAL SCHEDULES
<ul style="list-style-type: none"> CP0.1.i BUILDING CODE ANALYSIS CP1.0.i STADIUM CODE PLAN CP1.1A.i FIRST FLOOR CODE PLAN CP1.2A.i SECOND FLOOR CODE PLAN 	<ul style="list-style-type: none"> A13.1.i SEATING PLAN A13.2A.i FIRST FLOOR FF&E PLAN - AREA A A13.3A.i SECOND FLOOR FF&E PLAN - AREA A 	<ul style="list-style-type: none"> P0.1.i GENERAL NOTES, PLUMBING SYMBOLS & ABBREVIATIONS P1.1A.i UNDERGROUND PLUMBING PLAN - AREA A P1.1A.1.i UNDERGROUND PLUMBING PLAN - AREA A - DOMESTIC P1.1A.2.i UNDERGROUND PLUMBING PLAN - AREA A - DRAINAGE P2.1A.i PLUMBING PLAN - AREA A - LEVEL 1 P2.1A.1.i PLUMBING PLAN - AREA A - LEVEL 1 - DOMESTIC P2.1A.2.i PLUMBING PLAN - AREA A - LEVEL 1 - DRAINAGE P2.2A.i PLUMBING PLAN - AREA A - LEVEL 2 P2.2A.1.i PLUMBING PLAN - AREA A - LEVEL 2 - DOMESTIC P2.2A.2.i PLUMBING PLAN - AREA A - LEVEL 2 - DRAINAGE P2.3.i PLUMBING ROOF PLAN P3.1.i ENLARGED PLUMBING PLANS AND SECTIONS P4.1.i WASTE & VENT ISOMETRIC DIAGRAMS P4.2.i DOMESTIC ISOMETRIC DIAGRAM P4.3.i NATURAL GAS ISOMETRIC DIAGRAM P5.1.i PLUMBING DETAILS P5.2.i PLUMBING DETAILS P6.1.i PLUMBING SCHEDULES P6.2.i PLUMBING SCHEDULES 	<ul style="list-style-type: none"> TA0.01.i AUDIOVISUAL GENERAL NOTES TA1.01A.i AUDIOVISUAL WIRING DEVICE PLAN, FIRST LEVEL - AREA A TA1.02A.i AUDIOVISUAL WIRING DEVICE PLAN, SECOND LEVEL - AREA A TA1.11A.i AUDIOVISUAL EQUIPMENT PLAN, FIRST LEVEL - AREA A TA1.12A.i AUDIOVISUAL EQUIPMENT PLAN, SECOND LEVEL - AREA A TA2.01A.i AUDIOVISUAL RCP, FIRST LEVEL - AREA A TA2.02A.i AUDIOVISUAL RCP, SECOND LEVEL - AREA A TA2.11A.i AUDIOVISUAL EQUIPMENT RCP, FIRST LEVEL - AREA A TA2.12A.i AUDIOVISUAL EQUIPMENT RCP, SECOND LEVEL - AREA A TA4.01.i ELEVATIONS, SECTIONS AND 3D VIEWS TA5.01.i AUDIOVISUAL DETAILS TA5.51.i AUDIOVISUAL WIRING DEVICE DETAILS TA6.02.i SIGNAL BLOCK DIAGRAM, CLUB LEVEL OPTION B TA6.04i AVR-A, AUDIOVISUAL VIDEO SIGNAL BLOCK DIAGRAM TA6.05i AVR-A, SUPPLEMENTAL VIDEO SIGNAL BLOCK DIAGRAM TA6.06i AVR-A, CLUB LEVEL VIDEO SIGNAL BLOCK TERMINALS TA6.07i AVR-A, AUDIO SIGNAL BLOCK DIAGRAM TA7.01.i AUDIOVISUAL SCHEDULES - AREA A TA7.04.i AUDIOVISUAL SCHEDULES - AREA A, PICNIC DECK - SECOND LEVEL




1.i MECHANICAL SCHEDULES M8.2.i MECHANICAL SCHEDULES 	<ul style="list-style-type: none"> TA0.01.i AUDIOVISUAL GENERAL NOTES TA1.01A.i AUDIOVISUAL WIRING DEVICE PLAN, FIRST LEVEL - AREA A TA1.02A.i AUDIOVISUAL WIRING DEVICE PLAN, SECOND LEVEL - AREA A TA1.11A.i AUDIOVISUAL EQUIPMENT PLAN, FIRST LEVEL - AREA A TA1.12A.i AUDIOVISUAL EQUIPMENT PLAN, SECOND LEVEL - AREA A TA2.01A.i AUDIOVISUAL RCP, FIRST LEVEL - AREA A TA2.02A.i AUDIOVISUAL RCP, SECOND LEVEL - AREA A TA2.11A.i AUDIOVISUAL EQUIPMENT RCP, FIRST LEVEL - AREA A TA2.12A.i AUDIOVISUAL EQUIPMENT RCP, SECOND LEVEL - AREA A TA4.01.i ELEVATIONS, SECTIONS AND 3D VIEWS TA5.01.i AUDIOVISUAL DETAILS TA5.51.i AUDIOVISUAL WIRING DEVICE DETAILS TA6.02.i SIGNAL BLOCK DIAGRAM, CLUB LEVEL OPTION B TA6.04i AVR-A, AUDIOVISUAL VIDEO SIGNAL BLOCK DIAGRAM TA6.05i AVR-A, SUPPLEMENTAL VIDEO SIGNAL BLOCK DIAGRAM TA6.06i AVR-A, CLUB LEVEL VIDEO SIGNAL BLOCK TERMINALS TA6.07i AVR-A, AUDIO SIGNAL BLOCK DIAGRAM TA7.01.i AUDIOVISUAL SCHEDULES - AREA A TA7.04.i AUDIOVISUAL SCHEDULES - AREA A, PICNIC DECK - SECOND LEVEL

*DRAWING INCLUDED IN WATER AND SEWER UTILITY PACKAGE TO BE REVIEWED AND APPROVED BY THE TOWN OF FISHKILL AND DUTCHESS COUNTY HEALTH DEPARTMENT

SCHEDULE OF ALTERNATES

ALTERNATE NO.	ALTERNATE DESCRIPTION
DEDUCT ALTERNATE NO. 1	REMOVE LEVEL 02 INDOOR CLUB, KITCHEN, AUXILIARY SPACES, AND OUTDOOR SEATING AREA.
DEDUCT ALTERNATE NO. 2	NOT USED.
DEDUCT ALTERNATE NO. 3	REMOVE CONCOURSE TOILET BUILDING.
DEDUCT ALTERNATE NO. 4	NOT USED.
DEDUCT ALTERNATE NO. 5	ASPHALT MILLINGS PARKING LOT.
DEDUCT ALTERNATE NO. 6	NOT USED.
DEDUCT ALTERNATE NO. 7	REMOVE CONCRETE STADIA SEATING BOWL EXTENSION.
DEDUCT ALTERNATE NO. 8	REMOVE TERRACED CONCRETE STADIA SEATING BOWL.



REBID DUTCHESS STADIUM NEW LEFT FIELD CLUBHOUSE, SEATING BOWL, & RESTROOM BUILDING
 OWNER: DUTCHESS COUNTY, 22 MARKET STREET POUGHKEEPSIE, NY 12601
 1500 ROUTE 90, FISHKILL, NY 12590

BID SET
 11.04.22
 REVISIONS

1	ADD 01	12.09.22
2	CONSTRUCTION DOCS	03.06.23
3	AS 001	05.12.23
4	AS 005	07.14.23
5	AS 011	11.07.23

57-21113-00
 INDEX OF DRAWINGS

G0.01.ii

GENERAL NOTES:

CONSTRUCTION AND MATERIALS SPECIFICATIONS: STANDARD SPECIFICATIONS, CONSTRUCTION AND MATERIALS, NEW YORK STATE DEPARTMENT OF TRANSPORTATION, OFFICE OF ENGINEERING WITH CURRENT ADDITIONS AND MODIFICATIONS.

- 1. THE CONTRACTOR IS TO VISIT THE SITE BEFORE BIDDING TO FAMILIARIZE HIMSELF WITH THE FIELD CONDITIONS AND TO JUDGE FOR HIMSELF THE EXTENT AND NATURE OF THE WORK TO BE DONE UNDER THIS CONTRACT. NO EXTRA COMPENSATION WILL BE PAID TO THE CONTRACTOR BECAUSE OF THE CONTRACTOR'S FAILURE TO INCLUDE IN HIS BID ALL ITEMS AND MATERIALS WHICH HE IS REQUIRED TO FURNISH IN ACCORDANCE WITH THE CONTRACT DOCUMENTS. THE CONTRACTOR IS ADVISED THAT HE MUST HAVE IN HIS POSSESSION, A SET OF CONTRACT PLANS/PROPOSAL FOR IDENTIFICATION PURPOSES WHEN CONDUCTING THIS SITE VISIT.
- 2. THE CONTRACTOR'S ATTENTION IS DIRECTED TO THE FACT THAT DUE TO THE NATURE OF RECONSTRUCTION PROJECTS, THE EXACT EXTENT OF RECONSTRUCTION WORK CANNOT ALWAYS BE ACCURATELY DETERMINED PRIOR TO THE COMMENCEMENT OF WORK. THESE CONTRACT DOCUMENTS HAVE BEEN PREPARED BASED ON FIELD INSPECTION AND INFORMATION AVAILABLE AT THE TIME. ACTUAL FIELD CONDITIONS MAY REQUIRE MODIFICATIONS TO CONSTRUCTION DETAILS AND WORK. THE CONTRACTOR SHALL PERFORM THE WORK IN ACCORDANCE WITH FIELD CONDITIONS.
- 3. THE CONTRACTOR SHALL EXAMINE AND VERIFY IN THE FIELD, ALL CONDITIONS AND DIMENSIONS. DIMENSIONS OF THE EXISTING STRUCTURES SHOWN ON THESE PLANS ARE FOR GENERAL REFERENCE ONLY. THEY HAVE BEEN TAKEN FROM THE ORIGINAL CONSTRUCTION DRAWINGS AND LIMITED FIELD SURVEY AND ARE NOT GUARANTEED. THE CONTRACTOR SHALL TAKE ALL SUCH FIELD MEASUREMENTS TO ASSURE PROPER FIT OF THE FINISHED WORK, AND THE CONTRACTOR SHALL ASSUME FULL RESPONSIBILITY FOR THEIR ACCURACY IF FIELD CONDITIONS AND DIMENSIONS DIFFER FROM THOSE SHOWN ON THE PLANS. THE CONTRACTOR SHALL USE THE FIELD CONDITIONS AND DIMENSIONS AND MAKE THE APPROPRIATE CHANGES TO THOSE SHOWN ON THE PLANS AS APPROVED BY THE ENGINEER. WHEN SHOP DRAWINGS BASED ON FIELD MEASUREMENTS ARE SUBMITTED FOR APPROVAL, THE FIELD MEASUREMENTS MADE SHALL BE INDICATED ON THE SHOP DRAWINGS SUBMITTED FOR REFERENCE OF THE REVIEWER.
- 4. THE CONTRACTOR SHOULD NOTE THAT ADDITIONAL WORK MAY BE REQUIRED AS THE CONTRACT PROGRESSES, WHICH IS NOT SHOWN OR NOTED ON THE PLANS. THIS WORK SHALL BE PERFORMED BY THE CONTRACTOR AS ORDERED BY THE ENGINEER, AND PAID ON A TIME AND MATERIALS BASIS AS APPROVED BY THE OWNER.
- 5. WORK PERTAINING TO MODIFICATIONS, AS MAY BE REQUIRED, DUE TO ANY DIFFERENCE BETWEEN ACTUAL FIELD CONDITIONS AND THOSE SHOWN BY THE DETAILS AND DIMENSIONS ON THE CONTRACT PLANS, WILL BE PAID AT THE UNIT BID PRICE FOR THE ACTUAL QUANTITIES OF MATERIALS USED OR FOR THE WORK PERFORMED, AS INDICATED BY THE VARIOUS ITEMS IN THE CONTRACT.
- 6. THE CONTRACTOR WILL BE HELD RESPONSIBLE FOR ALL DAMAGE TO THE EXISTING FACILITY CAUSED BY HIS OPERATIONS WHICH IS NOT INCLUDED AS PART OF THE INTENDED WORK. ALL DAMAGE TO THE EXISTING FACILITY WHICH IS NOT PART OF THE INTENDED WORK SHALL BE REPAIRED BY THE CONTRACTOR WITHOUT COST TO THE OWNER, AND TO THE SATISFACTION OF THE ENGINEER.
- 7. THE CONTRACTOR SHALL RESTORE LAWNS, DRIVEWAYS, CULVERTS, SIGNS AND OTHER PUBLIC OR PRIVATE PROPERTY DAMAGED OR REMOVED TO AT LEAST AS GOOD A CONDITION AS BEFORE BEING DISTURBED AS DETERMINED BY THE ENGINEER. ANY DAMAGED TREES, SHRUBS, AND/OR HEDGES NOT SPECIFICALLY CALLED OUT TO BE REMOVED ON THE PLANS SHALL BE REPLACED AT THE CONTRACTOR'S EXPENSE.
- 8. THE CONTRACTOR WILL PROTECT EXISTING PROPERTY LINE ORNAMENTATION. ANY MONUMENTATION DISTURBED OR DESTROYED, AS JUDGED BY THE ENGINEER OR OWNER, SHALL BE REPLACED AT THE CONTRACTOR'S EXPENSE UNDER SUPERVISION OF A NEW YORK STATE LICENSED LAND SURVEYOR.
- 9. THE PARKING LOT DRIVEWAY LOCATIONS SHOWN REPRESENTS THEIR DESIRED LOCATION. THE CONTRACTOR SHALL LAY OUT THE PARKING LOT AND DRIVEWAYS TO FOLLOW THE GIVEN ALIGNMENTS. MODIFICATIONS HORIZONTALLY AND/OR VERTICALLY WILL BE PERMITTED AS APPROVED BY THE ENGINEER. ONCE THE PARKING LOT AND TRAILHEAD LAYOUT IS COMPLETED THE CONTRACTOR SHALL COORDINATE A MEETING WITH THE ENGINEER FOR THE APPROVAL OF THE ALIGNMENT PRIOR TO THE BEGINNING OF ANY WORK OR THE ORDERING OF MATERIALS.
- 10. LOCATION OF PUBLIC AND/OR PRIVATE UTILITIES, INDICATED AS EXISTING AND/OR TO BE CONSTRUCTED AS SHOWN ON THE PLANS ARE APPROXIMATE ONLY. THEIR EXACT LOCATION SHALL BE DETERMINED IN THE FIELD. ADDITIONAL UTILITY LINES, WHETHER ABANDONED OR IN SERVICE, MAY EXIST, AND IT SHALL BE THE CONTRACTOR'S RESPONSIBILITY TO CONDUCT HIS OPERATIONS AND TAKE THE NECESSARY PRECAUTIONS TO PREVENT INTERFERENCE WITH OR DAMAGE TO THESE OR OTHER FACILITIES DURING THE COURSE OF CONSTRUCTION.
- 11. IN THE EVENT THAT THE CONTRACTOR DAMAGES AN EXISTING UTILITY SERVICE CAUSING AN INTERRUPTION IN SAID SERVICE, HE SHALL IMMEDIATELY COMMENCE WORK TO RESTORE SERVICE AND MAY NOT CEASE HIS WORK OPERATION UNTIL SERVICE IS RESTORED.
- 12. THE METHOD OF EXCAVATION AND/OR DEMOLITION IN THE IMMEDIATE VICINITY OF UNDERGROUND UTILITIES SHALL BE SUBJECT TO THE APPROVAL OF THE ENGINEER. HAND DIGGING MAY BE REQUIRED.

- 13. THE CONTRACTOR SHALL PROTECT HIS WORKERS AT ALL TIMES IN CONFORMANCE WITH APPLICABLE OSHA REGULATIONS.
- 14. THE CONTRACTOR IS ADVISED THAT ADDITIONAL NOTES WILL BE FOUND ON SUBSEQUENT SHEETS OF THE CONTRACT PLANS AND SUCH NOTES, WHILE PERTAINING TO THE SPECIFIC SHEETS THEY ARE PLACED ON, ALSO SUPPLEMENT THE GENERAL NOTES USED HEREIN.
- 15. THE HORIZONTAL COORDINATE SYSTEM IS BASED ON NEW YORK STATE PLANE.
- 16a. ALL WORK TO BE PERFORMED UNDER THIS CONTRACT WILL BE WITHIN THE PUBLIC RIGHT-OF- WAY (ROW) AND STADIUM PROPERTY. THE CONTRACTOR IS TO ASSURE HIMSELF THAT ALL WORK IS BEING PERFORMED WITHIN THE ROW AND PROPERTY, INCLUDING BUT NOT LIMITED TO VEHICLE ACCESS; STORAGE OF EQUIPMENT, MATERIALS, DEBRIS AND WASTE; LANDSCAPING; VEGETATION REMOVAL AND MANAGEMENT; GRADING, SEEDING AND THE INSTALLATION OF TURF; AND THE INSTALLATION OF ANY FENCES OR PROTECTIVE BARRIER.
- 16b. IF THE CONTRACTOR IS UNABLE TO IDENTIFY THE LIMITS OF THE PROPERTY AND/OR RIGHT-OF-WAY WHEN THE CONTRACT CALLS FOR WORK IN THOSE VICINITIES, THE CONTRACTOR MUST IDENTIFY AND CERTIFY THOSE LIMITS WITH THE ASSISTANCE OF A LICENSED LAND SURVEYOR BEFORE ANY WORK MAY BE INITIATED AT THOSE LOCATIONS. NO ADDITIONAL PAYMENT WILL BE MADE FOR THIS SURVEY.
- 16c. RELEASES FOR ANY NON-ESSENTIAL CONTRACT WORK OUTSIDE OF THE EXISTING PROPERTY OR RIGHT-OF-WAY, INCLUDING PLANTINGS, LANDSCAPING OR DRIVEWAY ENHANCEMENT, WILL BE PROVIDED BY THE PROJECT ENGINEER AND IN NO INSTANCE ARE TO BE SECURED BY THE CONTRACTOR. THE CONTRACTOR SHALL NOT INVADE UPON PRIVATE PROPERTIES, LANDS OR BUILDINGS FOR ANY REASON WITHOUT FIRST SECURING WRITTEN PERMISSION FROM THE PROPERTY OWNER.
- 16d. THE CONTRACTOR WILL BE HELD LIABLE FOR ANY DAMAGES DONE. ANY SUCH INJURIES OR DAMAGES SHALL BE SATISFACTORILY REPAIRED OR ITEMS REPLACED AT THE CONTRACTOR'S EXPENSE.
- 17. ANY SILT FENCE AND VEGETATION PROTECTION BARRIER SHOWN BEYOND THE PROPERTY OR RIGHT-OF-WAY LINE IS FOR PLAN CLARITY ONLY. ALL SILT FENCE AND VEGETATION PROTECTION BARRIER WILL BE PLACED WITHIN THE PROPERTY.
- 18. ENDANGERED SPECIES NOTES:

TREE PROTECTION FOR ENDANGERED SPECIES

THE AREA BENEATH THE DRIP LINE OF ALL TREES WITH A TRUNK DIAMETER OF 3 INCHES OR GREATER LOCATED OUTSIDE OF THE PROJECT CLEARING LIMITS OR IN PROXIMITY TO STAGING AND STOCKPILING AREAS SHALL NOT BE DISTURBED. DISTURBANCE INCLUDES REMOVING TREES, STOCKPILING MATERIAL, STORING EQUIPMENT, OR DRIVING AND PARKING VEHICLES BENEATH THE DRIP LINE OF TREES. ADDITIONAL TREES REQUIRING PROTECTION MAY BE DESIGNATED BY THE ENGINEER. THE CONTRACTOR SHALL SUBMIT A PLAN FOR APPROVAL SHOWING THE PROPOSED STAGING, STORAGE AND STOCKPILE AREAS FOR EACH SITE PRIOR TO PLACEMENT OF ANY EQUIPMENT OR MATERIALS AT THE SUBJECT AREA.
- 19. TREE REMOVAL PROHIBITION

REMOVAL OF TREES NOT SPECIFIED FOR REMOVAL WITH A TRUNK DIAMETER OF 3 INCHES OR GREATER IS PROHIBITED, UNLESS COORDINATED AND APPROVED.
- 20. TIME OF YEAR CUTTING RESTRICTIONS FOR INDIANA BAT AND NORTHERN LONG-EARED BAT.

IN ORDER TO PREVENT ANY DIRECT TAKINGS OF INDIANA BAT (MYOTIS SODALIS), A FEDERAL AND STATE LISTED ENDANGERED SPECIES AND NORTHERN LONG-EARED BAT (MYOTIS SEPTENTRIONALIS), A FEDERAL AND STATE LISTED THREATENED SPECIES, THE CONTRACTOR'S ATTENTION IS HEREBY DIRECTED TO THE FACT THAT TREE CUTTING SHALL ONLY BE PERFORMED FROM NOVEMBER 1 THROUGH MARCH 31. TIME OF YEAR TREE CUTTING RESTRICTIONS APPLY TO TREES THAT ARE 3 INCHES OR GREATER DIAMETER AT BREST HEIGHT (DBH).

- 21. MIGRATORY BIRD PROTECTION NOTE UNDER THE MIGRATORY BIRD TREATY ACT (MBTA), IT IS UNLAWFUL BY ANY MEANS OR MANNER TO INTENTIONALLY TAKE, CAPTURE, OR KILL ANY MIGRATORY BIRD UNLESS A PERMIT IS FIRST SECURED. VIOLATIONS OF MBTA REGULATIONS ARE SUBJECT TO PENALTIES OF UP TO \$15,000 AND SIX MONTHS IMPRISONMENT.

PROTECTED MIGRATORY BIRDS INCLUDE ALL WATERFOWL, HERONS, HAWKS, OWLS, EAGLES AND SONGBIRDS, INCLUDING SWALLOWS ROBINS, AND EASTERN PHOEBES. THEIR FEATHERS, NESTS, AND EGGS ARE ALSO PROTECTED UNDER THE MBTA.

EXEMPT FROM THE MBTA ARE ROCK DOVES (DOMESTIC PIGEONS), HOUSE SPARROWS (ENGLISH SPARROWS), EUROPEAN STARLINGS, AND MONK PARAKEETS. NON-NATIVE HUMAN-INTRODUCED BIRD SPECIES ARE NOT PROTECTED BY MBTA. ALTHOUGH THESE SPECIES ARE NOT PROTECTED UNDER THE MBTA, THEY SHOULD STILL BE TREATED AS HUMANELY AS POSSIBLE. IF ANY BIRD NESTS ARE ENCOUNTERED PRIOR TO OR DURING WORK CONTACT THE ENGINEER-IN-CHARGE (EIC) IMMEDIATELY.

AREAS SCHEDULED FOR WORK FROM APRIL 15 TO AUGUST 15 (THE PERIOD IN WHICH NESTS ARE TYPICALLY FOUND WITH EGGS OR UNFLEDGED CHICKS) SHALL BE INSPECTED FOR BIRD NESTING ACTIVITY PRIOR TO COMMENCING ANY WORK ACTIVITY. IF THE NEST(S) IS DETERMINED TO BE OCCUPIED, AVOID DISTURBING, DAMAGING OR REMOVING THE NEST UNTIL THE YOUNG ARE FLEDGED (LEAVE THE NEST). AT NO TIME SHOULD THE NESTS OF HAWKS, FALCONS OR EAGLES BE DESTROYED, AS THESE SPECIES RETURN TO THE SAME NEST SITE YEAR AFTER YEAR AND REUSE THE SAME NEST AFTER FLEDGING OCCURS (OF SPECIES OTHER THAN HAWKS, FALCONS OR EAGLES), AND ALL NESTING ACTIVITY IS BELIEVED TO HAVE CEASED (TYPICALLY INDICATED BY ADULT BIRDS MOVING TO AND FROM THE NEST), THEN THE NEST(S) CAN BE PRESUMED TO BE UNOCCUPIED AND CAN BE REMOVED SO THAT WORK MAY PROCEED. UNOCCUPIED NEST(S) SHOULD BE REMOVED AS QUICKLY AS POSSIBLE TO PREVENT BIRDS FROM BEGINNING A SECOND NEST BROOD AT THE SAME LOCATION.

FROM AUGUST 16 TO APRIL 14 NESTS CAN BE PRESUMED TO BE UNOCCUPIED AND CAN BE REMOVED AFTER CONFIRMING THAT THE NEST IS INDEED INACTIVE.

IF THERE ARE ANY QUESTIONS REGARDING HOW TO PROCEED WITH NESTING MIGRATORY BIRDS, IMMEDIATELY CONTACT THE ENGINEER. NO NESTS OF PROTECTED MIGRATORY BIRDS SHALL BE REMOVED OR DISTURBED IN ANY WAY WITHOUT PERMISSION FROM THE ENGINEER.

22. UTILITY COORDINATION

THE CONTRACTOR IS RESPONSIBLE FOR ALL COORDINATION WITH APPLICABLE UTILITY OWNERS IN ORDER TO PROVIDE AND INSTALL PROPOSED UTILITY CONNECTIONS.

UTILITY QUALITY LEVEL DESCRIPTION:


QUALITY LEVEL A - THE HIGHEST DEGREE OF ACCURACY; THE UTILITY INFORMATION ON THE CONTRACT PLANS HAS BEEN LOCATED AND VERIFIED BY EXCAVATION, WHEN APPROPRIATE. (SHOWN AS QLA)

QUALITY LEVEL B - SUBSURFACE GEOPHYSICAL LOCATING TECHNIQUES (IE. UNDERGROUND CAMERAS, RADAR, SONAR, TONE OUTS, ETC.) AND EXISTING RECORD PLANS HAVE BEEN USED TO LOCATE UTILITIES. NO EXCAVATIONS WERE PERFORMED. (SHOWN AS QLB)

QUALITY LEVEL C - RECORD INFORMATION PROVIDED BY UTILITY OWNERS WAS PLOTTED ON THE CONTRACT PLANS. DEPTHS WERE NOT FIELD VERIFIED. PHYSICAL SURFACE FEATURES LIKE MANHOLES, VALVE BOXES, AND HYDRANTS HAVE BEEN FIELD LOCATED. (SHOWN AS QLC)

QUALITY LEVEL D - EXISTING CITY AND UTILITY COMPANY RECORDS WERE USED TO LOCATE SUBSURFACE UTILITIES. (SHOWN AS QLD)

THE UTILITY QUALITY LEVEL FOR THE PROJECT AREA IS QUALITY LEVEL D.

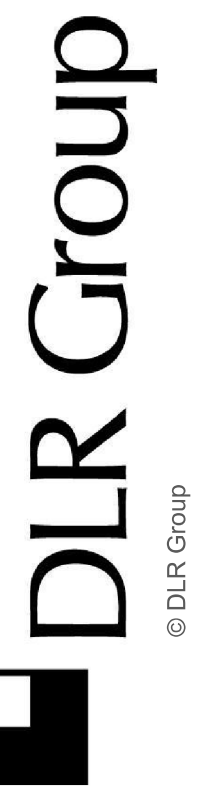

REBID DUTCHESS STADIUM NEW LEFT FIELD CLUBHOUSE, SEATING BOWL, & RESTROOM BUILDING
OWNER: DUTCHESS COUNTY, 22 MARKET STREET Poughkeepsie, NY 12601
1600 ROUTE 60, FISHKILL, NY 12530

BID SET
11.04.22
REVISIONS
1 CONSTRUCTION DOCS 03.06.23

57-21113-00

CIVIL GENERAL NOTES

UTILITY NOTES

- THE DESIGN, CONSTRUCTION AND INSTALLATION SHALL BE IN ACCORDANCE WITH THIS PLAN AND GENERALLY ACCEPTED STANDARDS IN EFFECT AT THE TIME OF CONSTRUCTION WHICH INCLUDE:

"NEW YORK STATE DESIGN STANDARDS FOR INTERMEDIATE SIZED WASTEWATER TREATMENT SYSTEMS", NYSDEC
"RECOMMENDED STANDARDS FOR SEWAGE TREATMENT WORKS, (TEN STATES)," "RECOMMENDED STANDARDS FOR WATER WORKS, (TEN STATES)," "NEW YORK STATE DEPARTMENT OF HEALTH AND DUTCHESS COUNTY ENVIRONMENTAL HEALTH SERVICES DIVISION POLICIES, PROCEDURES AND STANDARDS." "DUTCHESS COUNTY AND NEW YORK STATE SANITARY CODES." "DUTCHESS COUNTY ENVIRONMENTAL HEALTH SERVICES DIVISION CERTIFICATE OF APPROVAL LETTER."
- THIS PLAN IS APPROVED AS MEETING THE APPROPRIATE AND APPLIED TECHNICAL STANDARDS, GUIDELINES, POLICIES AND PROCEDURES FOR ARRANGEMENT OF SEWAGE DISPOSAL AND WATER SUPPLY FACILITIES.
- UPON COMPLETION OF THE FACILITIES, THE FINISHED WORKS SHALL BE INSPECTED, TESTED, AND CERTIFIED COMPLETE TO THE DC EHSB BY THE NEW YORK STATE LICENSED PROFESSIONAL ENGINEER SUPERVISING CONSTRUCTION. NO PART OF THE FACILITIES SHALL BE PLACED INTO SERVICE UNTIL ACCEPTED BY THE DC EHSB.
- APPROVAL OF ANY PLAN(S) OR AMENDMENT THERETO SHALL BE VALID FOR A PERIOD OF FIVE (5) YEARS FROM THE DATE OF APPROVAL. FOLLOWING THE EXPIRATION OF SAID APPROVAL, THE PLAN(S) SHALL BE RE-SUBMITTED TO THE COMMISSIONER OF HEALTH FOR CONSIDERATION FOR RE-APPROVAL. RE-SUBMISSION OR REVISED SUBMISSION OF PLANS AND/OR ASSOCIATED DOCUMENTS SHALL BE SUBJECT TO COMPLIANCE WITH THE TECHNICAL STANDARDS, GUIDELINES, POLICIES AND PROCEDURES IN EFFECT AT THE TIME OF THE RE-SUBMISSION.
- NO CELLAR, FOOTING, FLOOR, GARAGE, COOLER OR ROOF DRAINS SHALL BE DISCHARGED INTO THE SEWAGE COLLECTION SYSTEM.
- ALL BUILDINGS SHALL BE CONSTRUCTED AT AN ELEVATION HIGH ENOUGH TO ENSURE GRAVITY FLOW TO THE SEWAGE COLLECTION SYSTEM.
- ALL REQUIRED EROSION & SEDIMENT CONTROL AND STORMWATER POLLUTION PREVENTION WATER QUALITY & QUANTITY CONTROL STRUCTURES, PERMANENT AND TEMPORARY, ARE SHOWN ON THE PLANS.
- THE DC EHSB SHALL BE NOTIFIED SIXTY DAYS PRIOR TO ANY CHANGE IN USE; USE CHANGES MAY REQUIRE REAPPROVAL BY THE DC EHSB.
- NO BUILDINGS ARE TO BE OCCUPIED AND THE NEW WATER SYSTEM SHALL NOT BE PLACED INTO SERVICE, UNTIL A "COMPLETED WORKS APPROVAL" IS ISSUED UNDER SECTION 5-1.22(D) OF PART 5 OF THE NEW YORK STATE SANITARY CODE (10NYCRR5).
- NO BUILDINGS ARE TO BE OCCUPIED AND THE NEW WASTEWATER COLLECTION SYSTEM SHALL NOT BE PLACED INTO SERVICE UNTIL, A "CERTIFICATE OF CONSTRUCTION COMPLIANCE" IS ISSUED UNDER SECTION 19.7 OF ARTICLE 19 OF THE DUTCHESS COUNTY SANITARY CODE.
- ALL SERVICE LINES ARE THE RESPONSIBILITY OF THE OWNER UP TO THE PROPERTY LINE. THE WATER AND SEWER COMPANIES SHALL BE RESPONSIBLE FOR ALL VALVES AND PIPES WHICH ARE NOT ON THE OWNER'S PROPERTY.
- THE UNDERSIGNED OWNERS OF THE PROPERTY HEREON STATE THAT THEY ARE FAMILIAR WITH THIS MAP, ITS CONTENTS AND ITS LEGENDS AND HEREBY CONSENT TO ALL SAID TERMS AND CONDITIONS AS STATED HEREON.

SEWER TESTING NOTES

TESTING REQUIREMENTS FOR THE SEWER COLLECTION SYSTEM:

10 STATE STANDARDS FOR DEFLECTION TESTING

AFTER THE SANITARY SEWER PIPES AND MANHOLES HAVE BEEN INSTALLED AND BACKFILLED, THE CONTRACTOR SHALL TEST THE COMPLETED WORKS IN THE PRESENCE AND TO THE SATISFACTION OF THE ENGINEER. THE FOLLOWING TESTING PROCEDURES SHALL BE USED TO TEST THE COMPLETED WORKS.

DEFLECTION TEST

DEFLECTION TESTS SHALL BE PERFORMED ON ALL FLEXIBLE PIPE. THE TEST SHALL BE CONDUCTED AFTER THE FINAL BACKFILL HAS BEEN IN PLACE AT LEAST 30 DAYS TO PERMIT STABILIZATION OF THE SOIL-PIPE SYSTEM.

NO PIPE SHALL EXCEED A DEFLECTION OF 5 PERCENT. IF DEFLECTION EXCEEDS 5 PERCENT, THE PIPE SHALL BE EXCAVATED. REPLACEMENT OR CORRECTION SHALL BE ACCOMPLISHED IN ACCORDANCE WITH REQUIREMENTS IN THE APPROVED SPECIFICATIONS.

THE RIGID BALL OR MANDREL USED FOR THE DEFLECTON TEST SHALL HAVE A DIAMETER NOT LESS THAN 95 PERCENT OF THE BASE INSIDE DIAMETER OR AVERAGE INSIDE DIAMETER OF THE PIPE DEPENDING ON WHICH IS SPECIFIED IN THE ASTM SPECIFICATION, INCLUDING THE APPENDIX, TO WHICH THE PIPE IS MANUFACTURED. THE TEST SHALL BE PREFORMED WITHOUT MECHANICAL PULLING DEVICES.

NYSDEC - SEWER AND MANHOLE LEAKAGE TESTS

SEWER TESTING NOTES (CONT.)

LOW-PRESSURE AIR AND VACUUM TESTING

THE PROPER PROCEDURE FOR LOW-PRESSURE AIR TESTING OF SANITARY SEWERS IS DESCRIBED IN ASTM C828 FOR VITRIFIED CLAY PIPE, ASTM C924 FOR CONCRETE PIPE, AND ASTM F1417 FOR PLASTIC PIPE. THE GENERAL PROCEDURE DESCRIBED IN THE ASTM C828 FOR LOW-PRESSURE AIR TESTING OF VITRIFIED CLAY PIPE MAY BE USED FOR OTHER SANITARY SEWER PIPE MATERIAL NOT MENTIONED ABOVE AND IS NOT LIMITED TO A MAXIMUM DIAMETER OF 12 INCHES. THE PARAMETER TO BE MEASURED IS THE RATE OF AIR LOSS BASED ON THE AVERAGE TEST PRESSURE OF 3.0 PSIG ABOVE ANY HYDROSTATIC PRESSURE DUE TO ANY GROUNDWATER THAT MAY BE OVER THE PIPE. IT IS EXTREMELY IMPORTANT THE VARIOUS TEST PLUGS BE PROPERLY INSTALLED AND BRACED TO PREVENT BLOWOUTS. IT IS ALSO IMPORTANT TO MAINTAIN ADEQUATE PRESSURE RELIEF VALVES TO PREVENT OVER-PRESSURIZING THE SYSTEM. A MAXIMUM RELIEF PRESSURE OF 10 PSI IS SUGGESTED IN MOST LITERATURE.

ALTHOUGH LINE TESTING MAY BE DONE AT ANY TIME DURING THE CONSTRUCTION PHASE, THERE ARE TWO PERIODS WHEN TESTING IS OF SPECIAL VALUE:

- PRIOR TO PLACEMENT OF PAVING MATERIALS, TO AVOID UNNECESSARY EXPENSE IN LOCATION AND REPAIRING LEAKS
- AFTER WORK HAS BEEN COMPLETED AND SOME SETTLEMENT HAS HAD A CHANCE TO OCCUR THIS LATER PERIOD IS THE APPROPRIATE TIME FOR THE FINAL LINE ACCEPTANCE TEST, BECAUSE SIGNIFICANT DAMAGE CAN OCCUR AFTER BACKFILL FROM SUBSEQUENT SETTLING.

ALL PORTIONS OF A NEW SEWAGE SYSTEM SHOULD BE TESTED, INCLUDING ANY BUILDING SEWERS THAT MAY BE CONSTRUCTED IN CONJUNCTION WITH THE MAIN LINES.

AIR TESTING FOR CONCRETE SEWER MANHOLES SHOULD CONFORM TO EITHER THE TEST PROCEDURES DESCRIBED IN ASTM C1244 - STANDARD TEST METHOD FOR CONCRETE SEWER MANHOLES BY THE NEGATIVE AIR PRESSURE (VACUUM) TEST PRIOR TO BACKFILL OR THE VACUUM TESTING SPECIFICATIONS GIVEN THE TR-16. MANHOLES WHICH CANNOT BE PROPERLY AIR (VACUUM) TESTED BY THE ASTM OR TR-16 PROCEDURE SHOULD BE VISUALLY INSPECTED AND LEAKAGE TESTED USING INTERNAL OR EXTERNAL HYDROSTATIC PRESSURE.

HYDROSTATIC PRESSURE

ALL CONVENTIONAL GRAVITY SEWERS, MANHOLES AND CLEANOUTS SHOULD BE TESTED BY ANY STANDARD METHOD AFTER BEING FLUSHED AND BEFORE BEING USED. ONE PROCEDURE FOR HYDROSTATIC TESTING OF SANITARY SEWERS IS DESCRIBED IN AWWA C600, HYDROSTATIC TESTING. DEPENDING UPON THE GROUNDWATER TABLE ELEVATION, EITHER AN INFILTRATION OR EXFILTRATION METHOD MAY BE USED. THE MAXIMUM RATE OF INFILTRATION/EXFILTRATION SHOULD NOT EXCEED 100 GALLONS PER INCH DIAMETER PER MILE PER DAY, UNDER A MINIMUM POSITIVE HEAD OF TWO FEET AS GIVEN IN TEN STATES STANDARDS. MANHOLE SHOULD BE CONSTRUCTED TO BE WATER TIGHT AND TESTED FOR TIGHTNESS IN ACCORDANCE WITH TEN STATES STANDARDS OR TR-16.

AIR TEST - ASTM F1417 FOR PLASTIC PIPE

DETERMINE THE DURATION OF THE TEST BY USING THE FORMULA FOUND BELOW OR BY CONSULTING THE ACCOMPANYING TABLES AT THE END OF THE SECTION.

$$T=0.085 DK/Q$$

WHERE: T = SHORTEST TIME IN SECONDS ALLOWED FOR THE AIR PRESSURE TO DROP 1.0 PSIG (OR .5 PSIG IN CIRCUMSTANCES WHERE A SHORTED TEST DURATION IS DESIRED)
K = .000419 DL, BUT NOT LESS THAN 1.0
Q = .0015 CUBIC FEET/MINUTE/SQUARE FOOT INTERNAL PIPE SURFACE AREA
D = NOMINAL PIPE DIAMETER IN INCHES
L = LENGTH OF PIPE BEING TESTED IN FEET

- BEGIN THE TEST BY CONNECTING THE AIR SOURCE TO THE INLET TAP. SLOWLY ADD AIR UNTIL THE INTERNAL PRESSURE OF THE TEST SECTION REACHES A PRESSURE 4.0 PSIG GREATER THAN THE AVERAGE BACK PRESSURE OF ANY GROUNDWATER ABOVE THE PIPE AS LONG AS THE INTERNAL PRESSURE DOES NOT EXCEED 9.0 PSIG. IF GROUND WATER BACK PRESSURE EXISTS, IT MUST BE QUANTIFIED BY THE ENGINEER PRIOR TO TESTING.
- AFTER THE CONSTANT PRESSURE OF 4.0 PSIG (GREATER THAN THE ABOVE GROUND WATER BACK PRESSURE) IS ATTAINED, THE AIR SUPPLY SHOULD BE CONTROLLED TO KEEP THE PRESSURE AT 4.0 PSIG (GREATER THAN THE AVERAGE GROUND WATER BACK PRESSURE) FOR AT LEAST TWO MINUTES ALLOWING THE ENTERING AIR'S TEMPERATURE TO REACH EQUILIBRIUM WITH THE TEMPERATURE OF THE PIPE WALL.
- ONCE THE PRESSURE HAS STABILIZED TO 4.0 PSIG (GREATER THAN THE AVERAGE GROUND WATER BACK PRESSURE) DISCONNECT THE AIR SUPPLY ROM THE CONTROL PANEL. OBSERVE THE CONTINUOUS MONITORING GAGE AND DECREASE THE INTERNAL PRESSURE TO NO LESS THAN 3.5 PSIG (GREATER THAN THE AVERAGE GROUND WATER BACK PRESSURE). AT A READING OF 3.5 PSIG OR WITHIN THE RANGE OF 3.5 TO 4.0 PSIG, STOP DECREASING THE PRESSURE AND COMMENCE TIMING WITH A STOPWATCH OR ANY OTHER TIMING DEVICE CAPABLE OF BEING 99.8 PERCENT ACCURATE.
- ONCE THE PREDETERMINED TIME PERIOD FROM THE FORMULA OR TABLE ABOVE HAS ELAPSED, OBSERVE THE CONTINUOUS MONITORING GAGE TO OBTAIN THE AMOUNT OF PRESSURE LOST DURING THE TEST DURATION. IF THE PRESSURE DROP IS FOUND TO BE LESS THAN 1.0 PSIG (OR 0.5 PSIG IN CIRCUMSTANCES WHERE A SHORTER TEST DURATION IS DESIRED), THE SECTION IS PRESUMED TO BE FREE OF ANY LEAKS OR DEFECTIVE JOINTS. IF THE PRESSURE DROP IS 1.0 PSIG OR GREATER (OR 0.5 PSIG IN CIRCUMSTANCES WHERE A SHORTER TEST DURATION IS DESIRED), THE TEST SECTION HAS FAILED DUE TO EXCESSIVE PRESSURE LOSS, WHEN LOW-PRESSURE AIR TESTING OF A SEWER LINE RESULTS IN A FAILURE THE CONTRACTOR, AT HIS/HER OWN EXPENSE, SHALL DETECT THE LEAK OR DEFECT AND REPAIR OR REPLACE WHATEVER IS NECESSARY TO REMEDY SUCH DEFECT IN A MANNER ACCEPTABLE TO THE OWNER.

WATER TESTING NOTES:

WATER MAIN TESTING

THE CONTRACTOR SHALL PROVIDE ALL NECESSARY EQUIPMENT AND SHALL PERFORM ALL WORK REQUIRED IN CONNECTION WITH ALL TESTING AS SPECIFIED HERIN. ALL PIPE SHALL BE TESTED BY HYDROSTATIC PRESSURE, FIFTY (50) PERCENT IN EXCESS OF NORMAL PSI WORKING PRESSURE BUT NOT LESS THAN 150 PSI OR MORE THAN THE DESIGN RATING OF THE PIPE OR APPURTENANCE, IN ACCORDANCE WITH AWWA SPECIFICATION C-600-05. THE TEST PRESSURE SHALL BE DETERMINED BY THE WATER AUTHORITY AND/OR OWNER'S FIELD REPRESENTATIVE. EACH SECTION TESTED SHALL BE SLOWLY FILLED WITH WATER, CARE BEING TAKEN TO EXPEL ALL AIR FROM THE PIPES. IF NECESSARY, THE PIPES SHALL BE TAPPED AT HIGH POINTS TO VENT THE AIR. REQUIRED PRESSURE, AS MEASURED AT THE POINT OF LOWEST ELEVATION, SHALL BE APPLIED FOR NOT LESS THAN TWO (2) HOURS, AND ALL PIPE FITTINGS, VALVES, HYDRANTS AND JOINTS SHALL BE CAREFULLY EXAMINED FOR DEFECTS. LEAKY JOINTS SHALL BE MADE WATERTIGHT.

A LEAKAGE TEST SHALL ALSO BE CONDUCTED IN ACCORDANCE WITH AWWA SPECIFICATION C-600-05. PERMISSIBLE LEAKAGE SHAL BE IN ACCORDANCE WITH AWWA C-600-05

TESTING ALLOWANCE SHALL BE DEFINED AS THE MAXIMUM QUANTITY OF MAKEUP WATER THAT IS ADDED INTO A PIPELINE UNDERGROUND HYDROSTATIC PRESSURE TESTING, OR ANY VALVED SECTION THERE OF, IN ORDER TO MAINTAIN PRESSURE WITHIN ±5 PSI OF THE SPECIFIC TEST PRESSURE (AFTER THE PIPELINE HAS BEEN FILLED WITH WATER AND THE AIR HAS BEEN EXPELLED). NO PIPE INSTALLATION WILL BE ACCEPTED IF THE QUANTITY OF MAKEUP WATER IS GREATER THAN THE DETERMINED BY THE FOLLOWING FORMULA:

$$Q = LDP^{1/2} / 148,000$$

WHERE:

L = TESTING ALLOWANCE (MAKEUP WATER), IN GALLONS PER HOUR

S = LENGTH OF PIPE TESTED, IN FEET

D = NOMINAL DIAMETER OF THE PIPE, IN INCHES

P = AVERAGE TEST PRESSURE DURING THE HYDROSTATIC TEST, IN POUNDS PER SQUARE INCH (GAUGE)

A 48 HOUR ADVANCE NOTICE MUST BE GIVEN TO THE WATER AUTHORITY AND HEALTH DEPARTMENT PRIOR TO PRESSURE TESTING OF WATER LINES.

IF THE SECTION BEING TESTED SHALL FAIL TO PASS THE PRESSURE TEST OR THE LEAKAGE TEST, OR BOTH, THE CONTRACTOR SHALL LOCATE, UNCOVER, AND REPAIR OR REPLACE THE DEFECTIVE PIPE, FITTING OR JOINTS, AND ALL SUCH WORK SHALL BE DONE AT HIS EXPENSE AND AT NO ADDITIONAL COST TO THE OWNER.


IN THE EVENT OF CONFLICT BETWEEN THE TESTS SPECIFIED HEREIN AND THE TEST REQUIREMENTS OF THE TOWN OF FISHKILL ROMBOUT WATER DISTRICT, HEALTH DEPARTMENT OR ANY OTHER AUTHORITY HAVING JURISDICTION OVER ALL OR ANY PORTION OF THE WATER LINES INSTALLED UNDER THIS CONTRACT, THE MORE RESTRICTIVE REQUIREMENTS SHALL GOVERN.

WATER MAIN DISINFECTING

(A) AFTER THE WATER LINE HAS PASSED THE REQUIRED PRESSURE AND LEAKAGE TESTS AND BEFORE BEING PLACED INTO SERVICE, THE ENTIRE LINE SHALL BE DISINFECTED IN ACCORDANCE WITH AWWA C651 STANDARDS, EXCLUDING THE TABLET METHOD. ALL DISINFECTING OPERATIONS AND PROCEDURES SHALL MEET WITH THE APPROVAL OF THE WATER AUTHORITY AND HEALTH DEPARTMENT.

(B) IF THE INITIAL BACTERIOLOGICAL TESTS ARE NOT SATISFACTORY, THE CONTRACTOR SHALL OBTAIN SATISFACTORY BACTERIOLOGICAL TESTS INCLUDING MAKING PROVISIONS TO ISOLATE SHORTER SECTIONS OF THE LINE IF NECESSARY. ALL WORK REQUIRED TO OBTAIN SATISFACTORY BACTERIOLOGICAL TESTS SHALL BE AT THE CONTRACTOR'S EXPENSE AND AT NO ADDITIONAL COST TO THE OWNER.

(C) IN THE EVENT OF A CONFLICT BETWEEN TESTS SPECIFIED HEREIN AND THE TEST REQUIREMENTS OF THE WATER AUTHORITY, HEALTH DEPARTMENT OR ANY OTHER AUTHORITY HAVING JURISDICTION OVER ALL OR ANY PORTION OF THE WATER LINES INSTALLED UNDER THIS CONTRACT, THE MORE RESTRICTIVE REQUIREMENTS SHALL GOVERN.

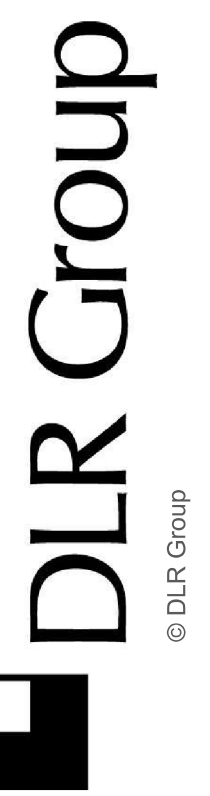


REBID DUTCHESS STADIUM NEW LEFT FIELD CLUBHOUSE, SEATING BOWL, & RESTROOM BUILDING
OWNER: DUTCHESS COUNTY, 22 MARKET STREET POUGHKEEPSIE, NY 12601
1600 ROUTE 60, FISHKILL, NY 12530

BID SET
11.04.22
REVISIONS
1 CONSTRUCTION DOCS 03.06.23
2 A81011 11.07.23




57-21113-00

CIVIL UTILITY NOTES

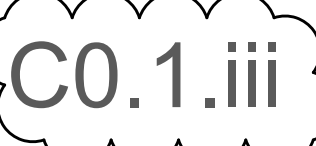

- THE DESIGN, CONSTRUCTION AND INSTALLATION SHALL BE IN ACCORDANCE WITH THIS PLAN AND GENERALLY ACCEPTED STANDARDS IN EFFECT AT THE TIME OF CONSTRUCTION, WHICH INCLUDE:
 - RECOMMENDED STANDARDS FOR WATER (TEN STATES)
 - RURAL WATER SUPPLY, NEW YORK STATE DEPARTMENT OF HEALTH
 - NEW YORK STATE DEPARTMENT OF HEALTH AND DUTCHESS COUNTY DEPARTMENT OF HEALTH POLICIES, PROCEDURES, AND STANDARDS
 - DUTCHESS COUNTY DEPARTMENT OF HEALTH SANITARY CODE, ARTICLE XI AND ARTICLE V
 - DUTCHESS COUNTY DEPARTMENT OF HEALTH CERTIFICATE OF APPROVAL

- UPON COMPLETION OF THE FACILITIES, THE FINISHED WORK SHALL BE INSPECTED, TESTED, AND CERTIFIED COMPLETE TO THE DUTCHESS COUNTY HEALTH DEPARTMENT BY THE NEW YORK STATE LICENSED PROFESSIONAL ENGINEER SUPERVISING CONSTRUCTION. NO PART OF THE FACILITIES SHALL BE PLACED INTO SERVICE UNTIL ACCEPTED BY THE DUTCHESS COUNTY HEALTH DEPARTMENT. THE NEW WATER SUPPLY SYSTEM SHALL NOT BE PLACED INTO SERVICE UNTIL A COMPLETED WORK APPROVAL IS ISSUED UNDER SECTION 5-1.22(d) OF PART 5 OF THE NEW YORK STATE SANITARY CODE (10NYCRRS).
- DISINFECTION AND TESTING OF WATER MAIN SHALL COMPLY WITH THE SPECIFICATIONS.
- THE RESULTS OF THE BACTERIOLOGICAL SAMPLING AND LEAKAGE TESTS SHALL BE SUBMITTED TO THE DUTCHESS COUNTY DEPARTMENT OF HEALTH AS PART OF THE CERTIFICATION BY A NEW YORK STATE LICENSED PROFESSIONAL ENGINEER.
- THRUST RESTRAINTS SHALL BE INSTALLED PER THE SPECIFICATIONS AND AS DETAILED ON THE NYSDOT STANDARD SHEETS 663-02 AND 663-03.
- THE CONTRACTOR SHALL LOCATE THE EXISTING WATER MAIN TO CONFIRM ELEVATION, SIZE, AND MATERIAL PRIOR TO CONSTRUCTION AND PRIOR TO ORDERING ANY MATERIALS. ANY ADJUSTMENTS TO THE ALIGNMENT OF THE NEW WATER LINE SHALL BE SUBMITTED TO THE ENGINEER FOR APPROVAL.
- UTILITY WORK ACROSS ROUTE 9D SHALL BE PER NYSDOT HIGHWAY WORK PERMIT REQUIREMENTS.
- IF THE INSTALLATION OF SANITARY SEWER CROSSING 9D IS TO BE PERFORMED BY DIRECTIONAL BORING, THE EXISTING GAS LINE ON ROUTE 9D SHALL BE EXPOSED AND MONITORED DURING BORING OPERATIONS.
- ALL TRAFFIC CONTROL SHALL BE PER THE 619 SERIES NYSDOT STANDARD SHEETS AND CAN BE ALTERED AT ANY TIME BY NYSDOT. ALLOWABLE TIMES FOR LANE CLOSURES WILL BE DETERMINED BY NYSDOT. NO ADDITIONAL PAYMENT WILL BE MADE FOR ANY CHANGES TO THE TRAFFIC CONTROL SCHEME(S) AS ORDERED BY NYSDOT OR LOCAL MUNICIPALITY.

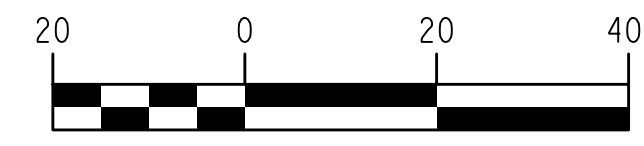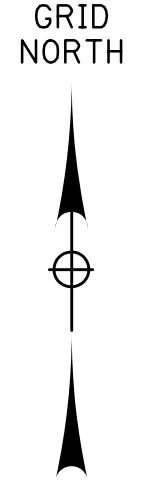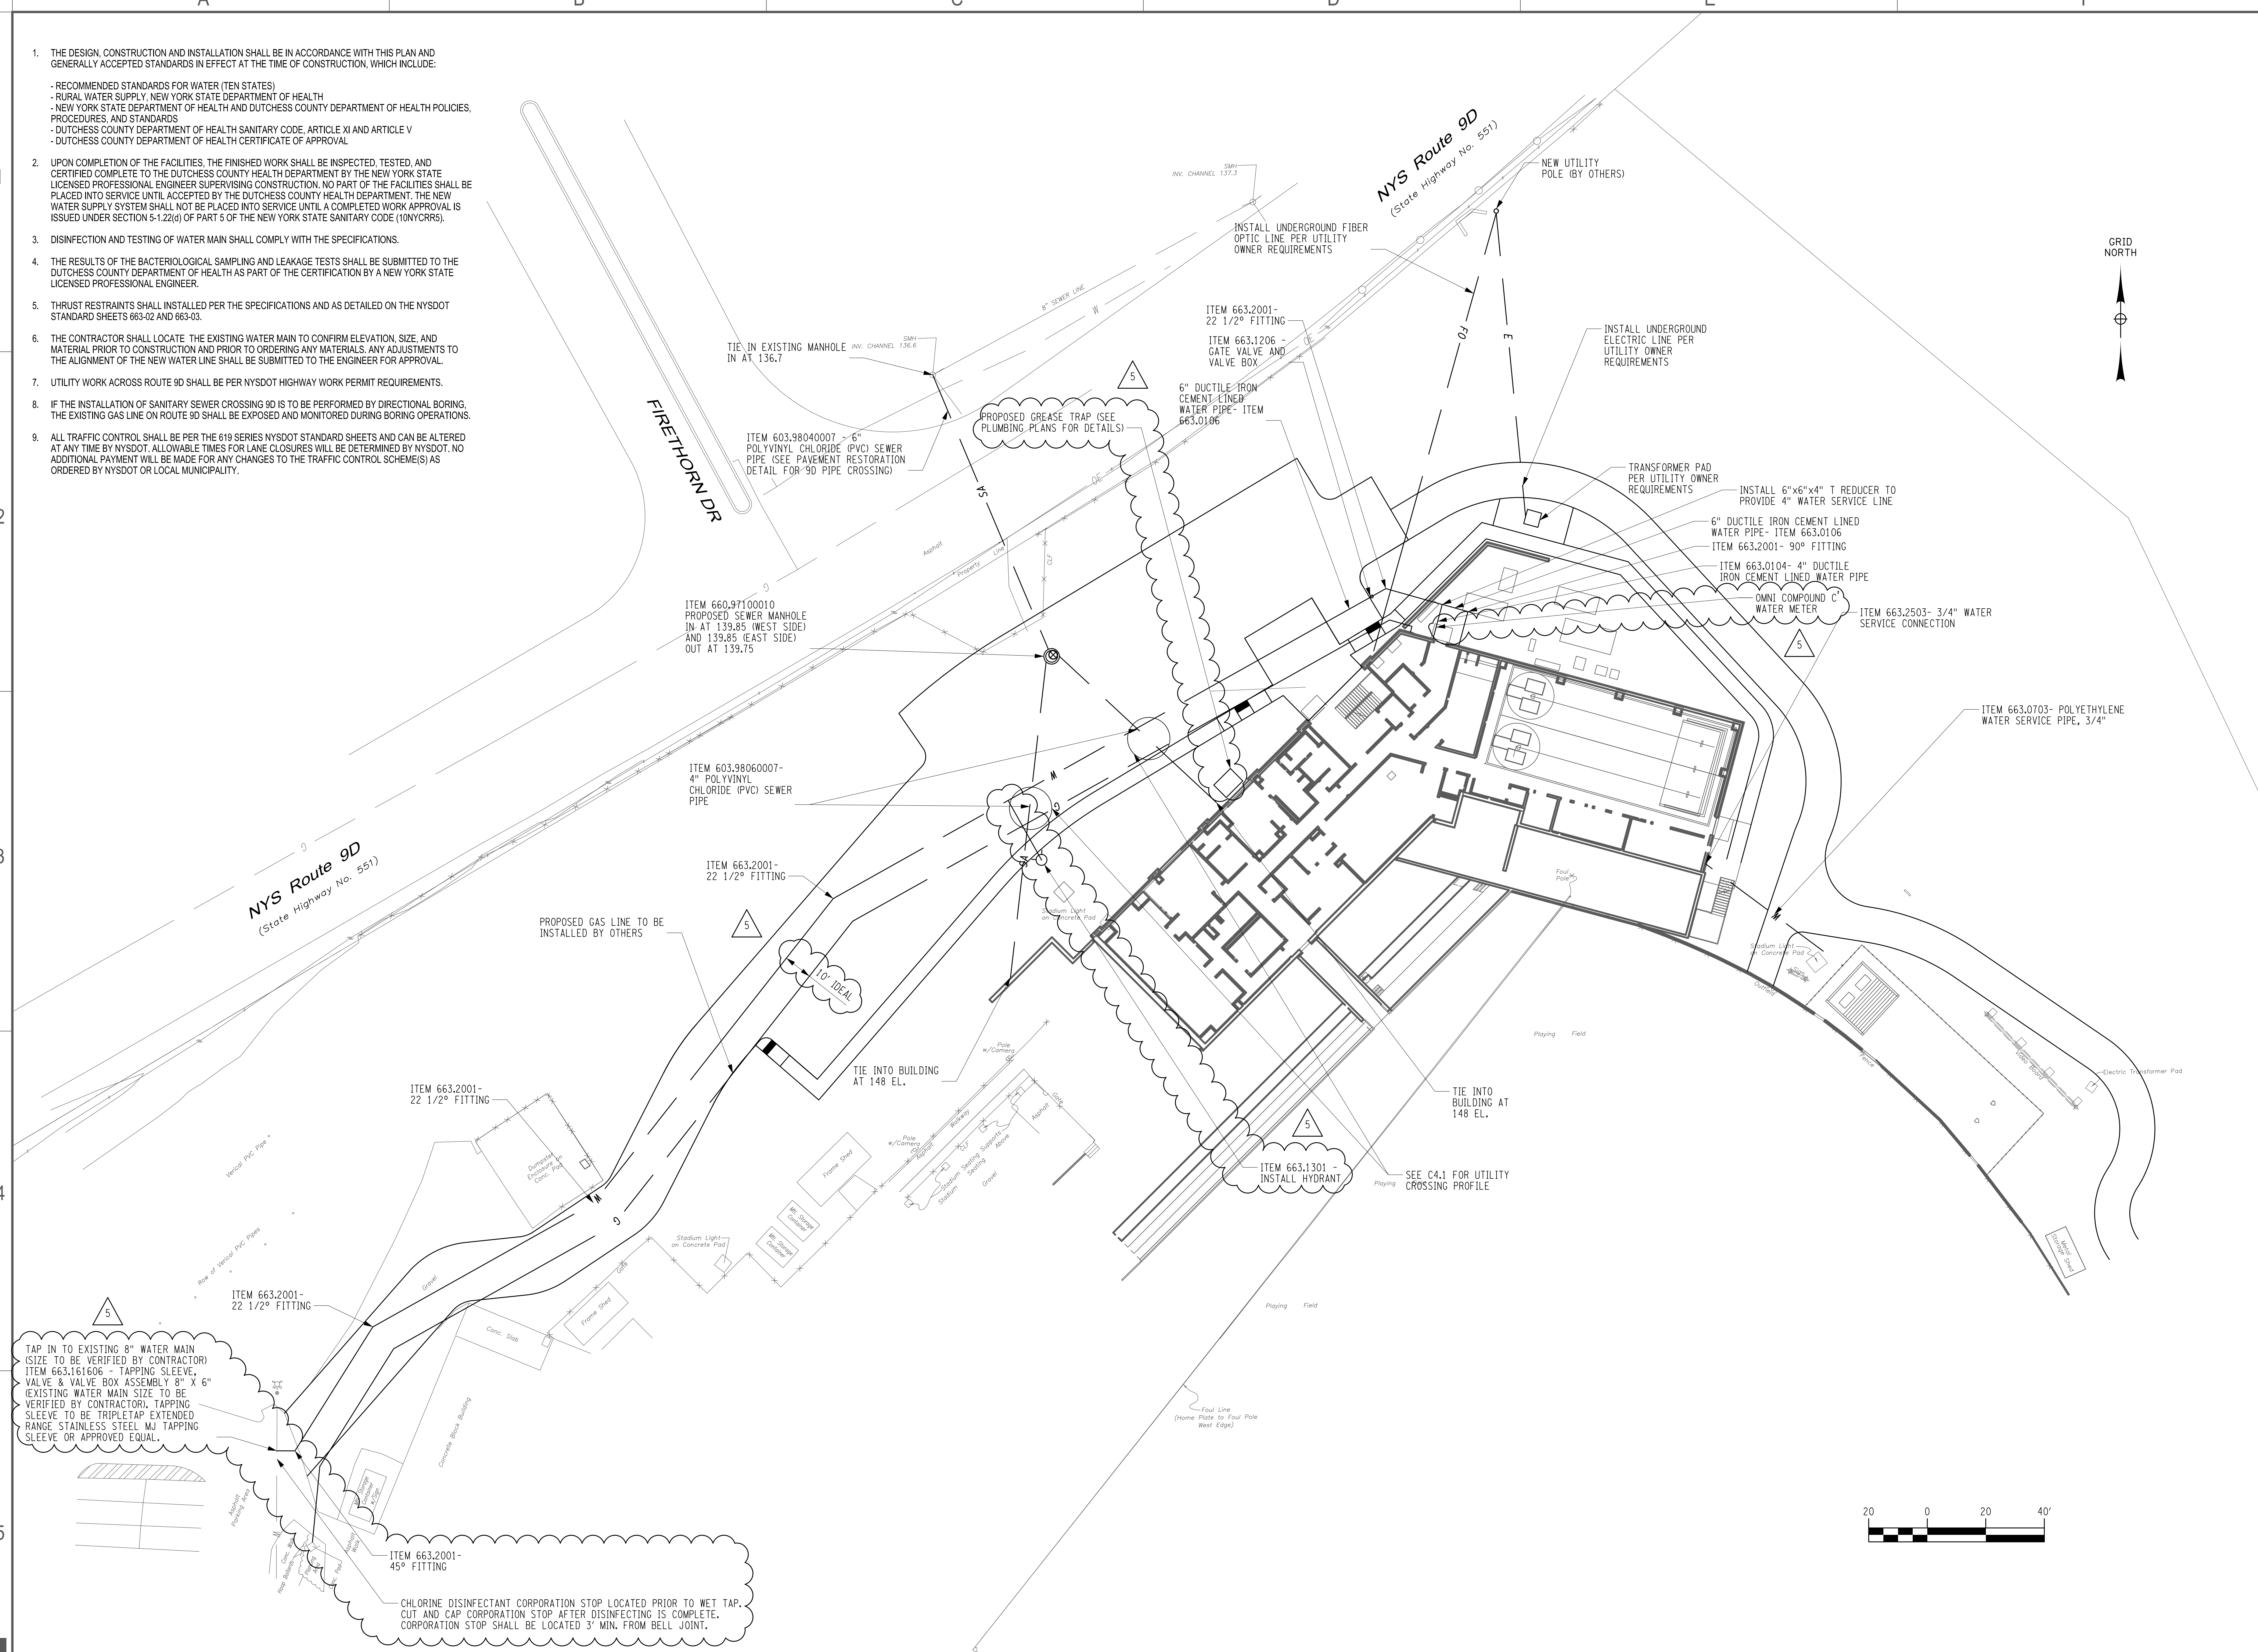

BID SET
 11.04.22






REVISIONS

1	CONSTRUCTION DOCS	03.06.23
2	ASB04	06.06.23
3	ASB06	07.16.23
4	ASB07	08.07.23
5	ASB11	11.07.23




BID SET
11.04.22
REVISIONS




1	CONSTRUCTION DOCS	03.06.23
2	ASB04	08.02.23
3	ASB06	07.18.23
4	ASB11	11.07.23

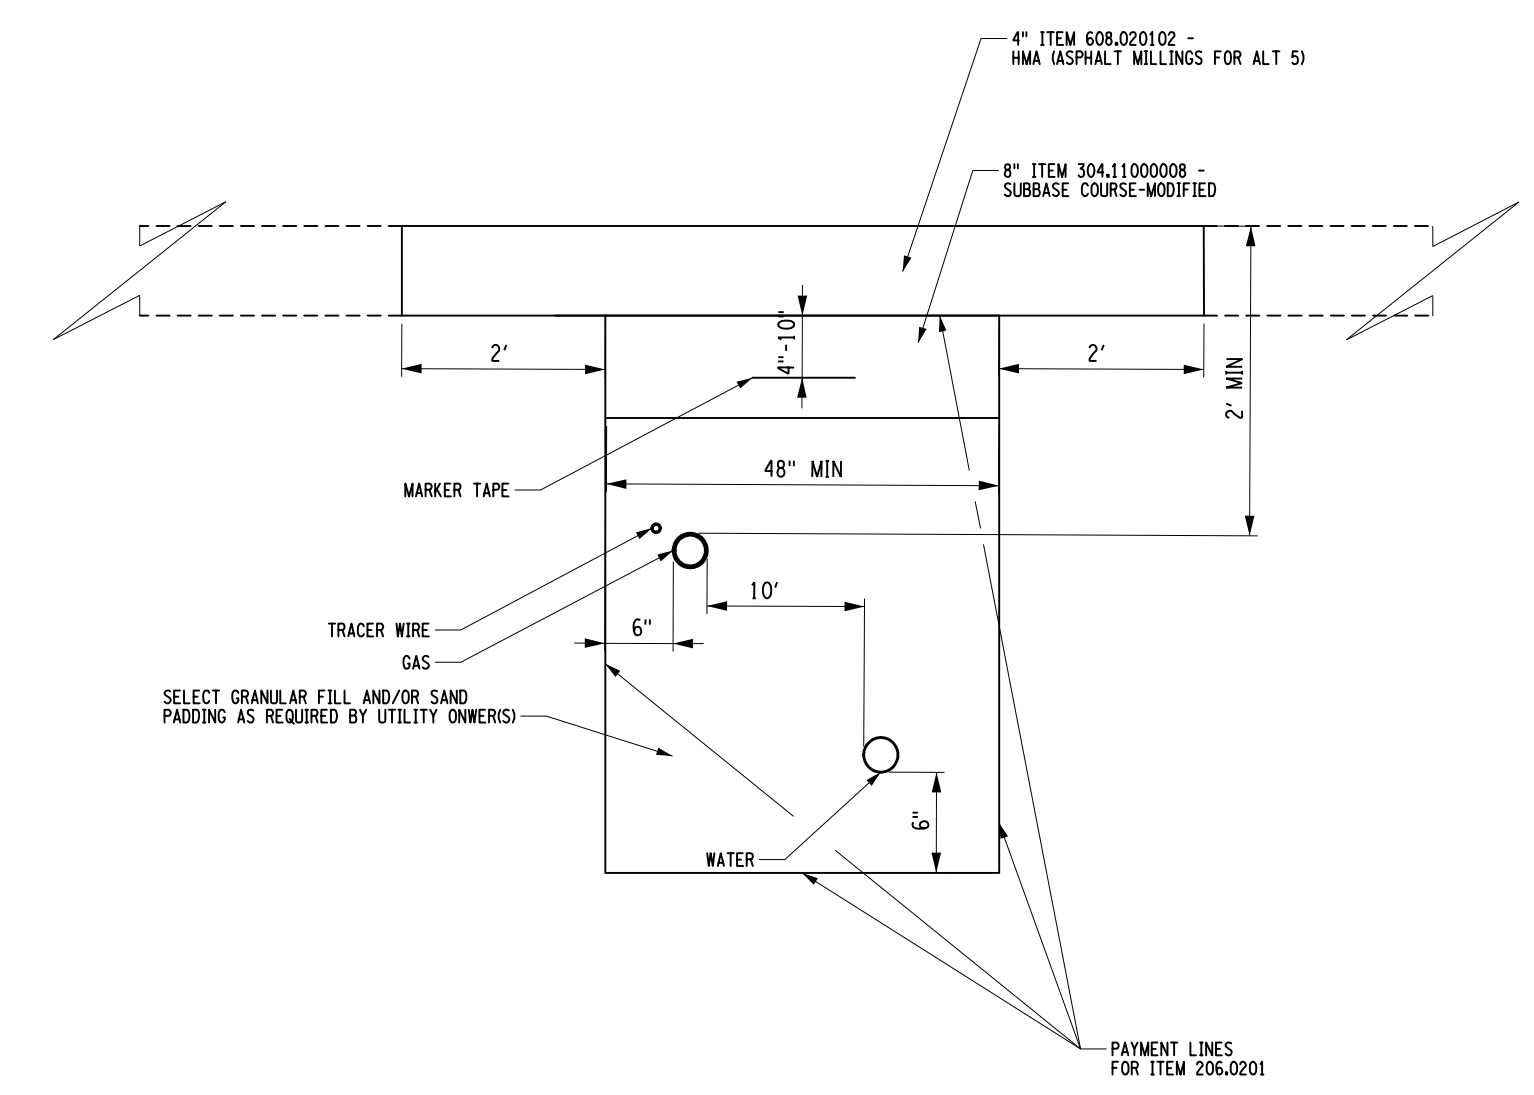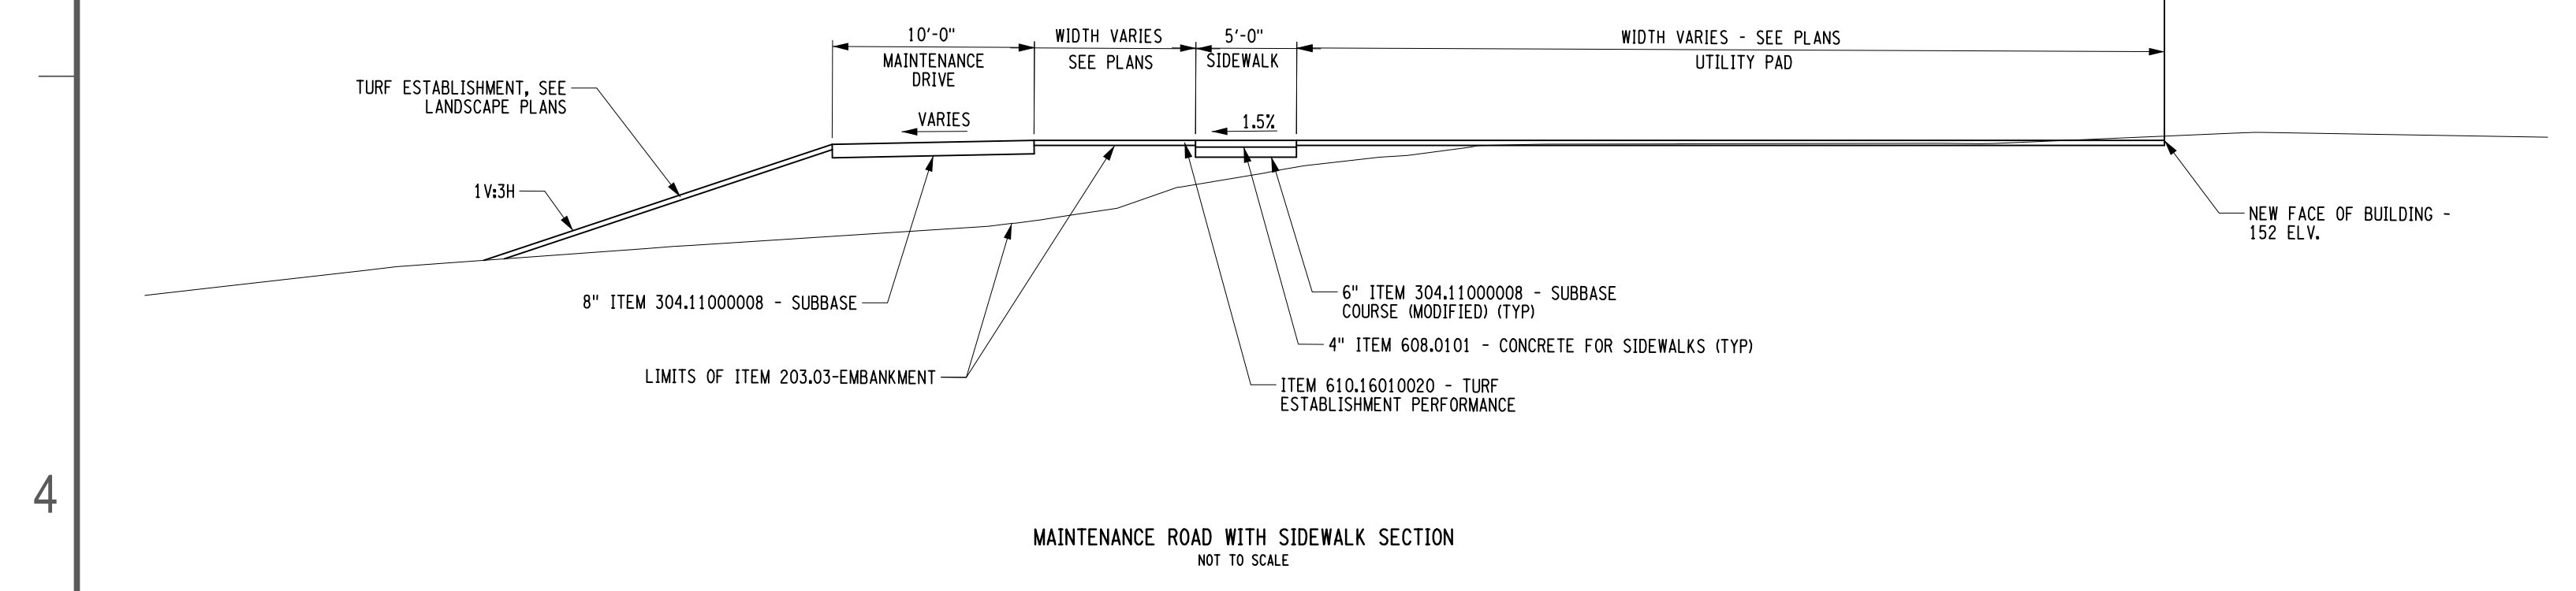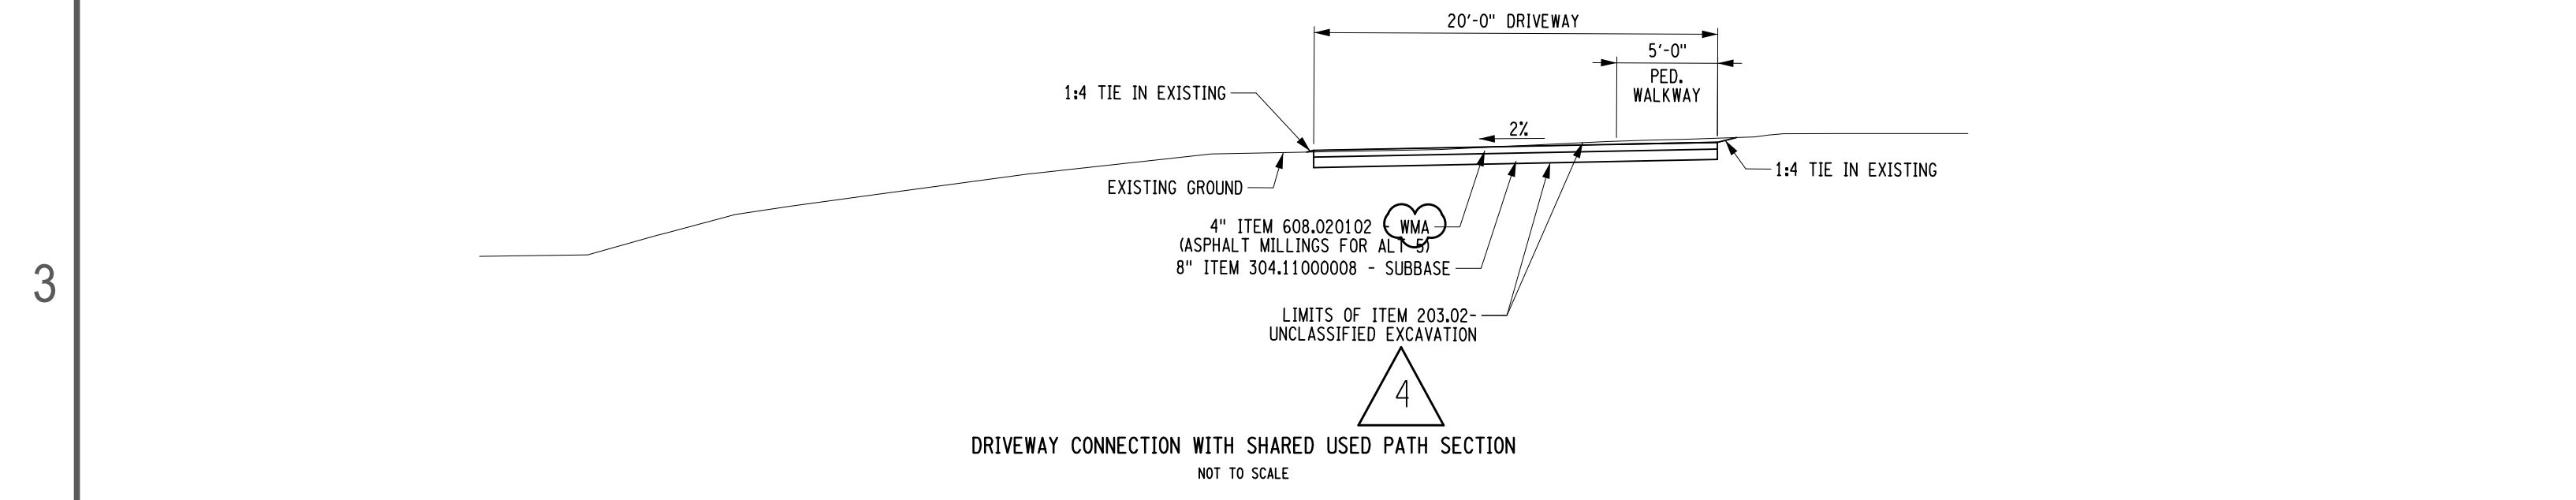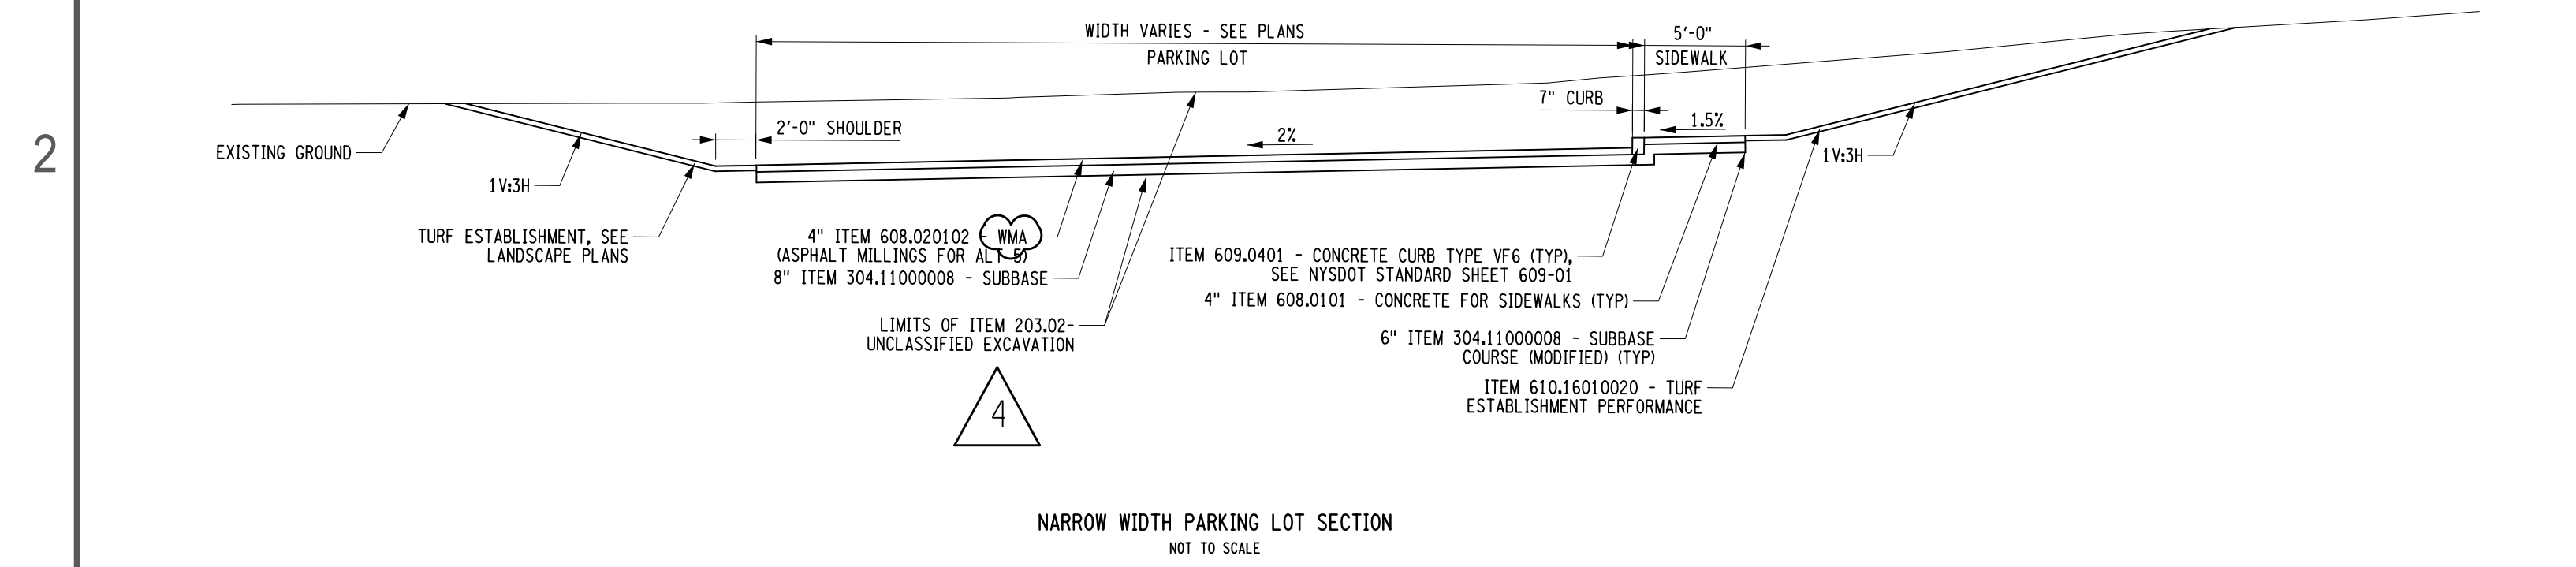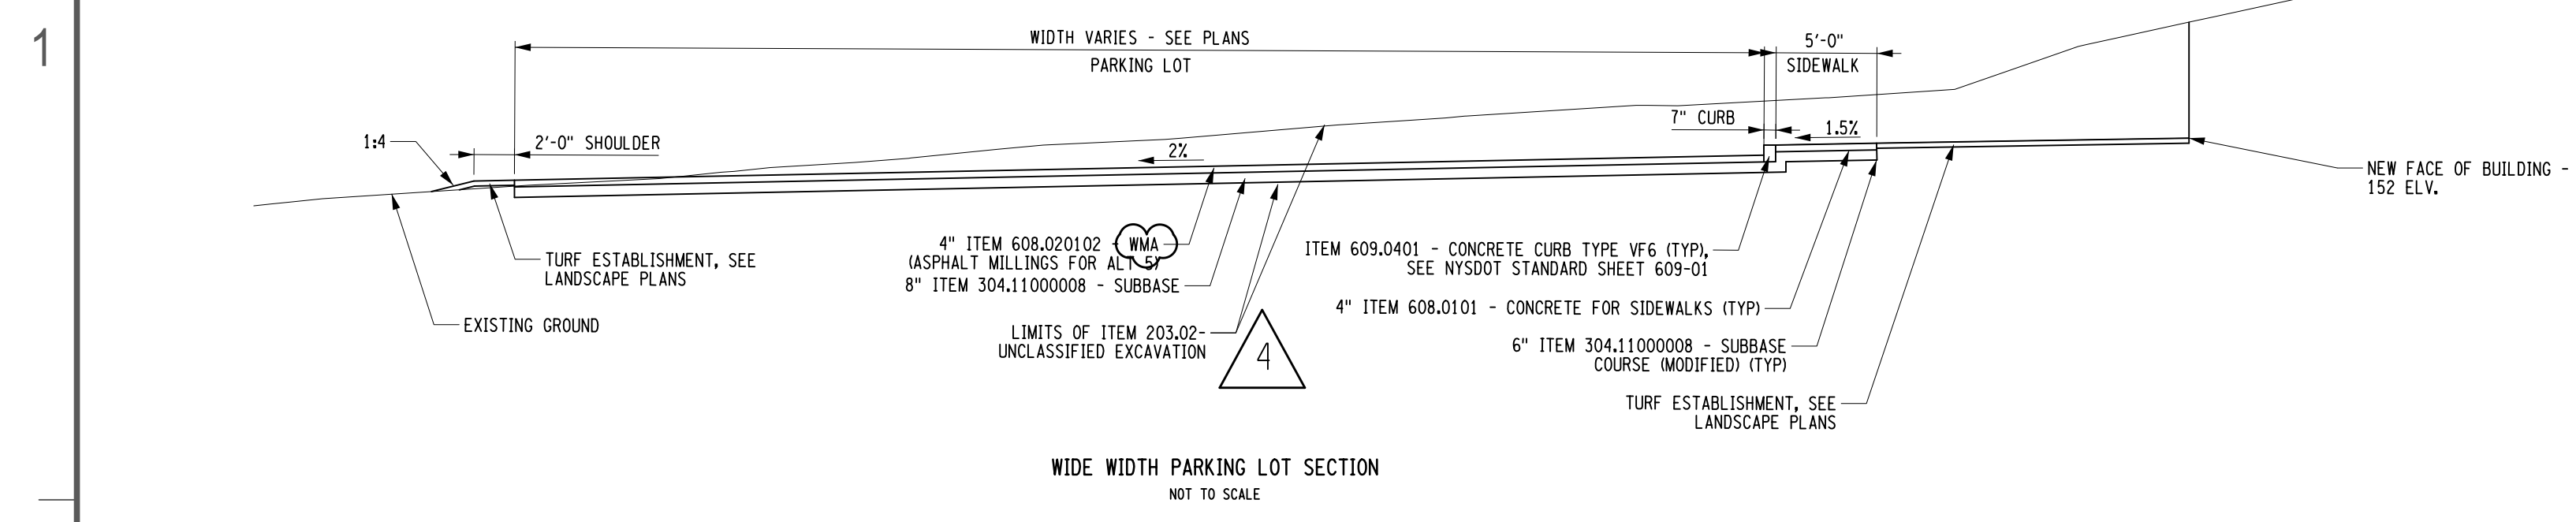

- NOTES:**
- THE TRENCH SHALL BE BACKFILLED ABOVE ITEM 203.07 LIMIT WITH SUITABLE MATERIAL. IF MATERIAL EXCAVATED FROM THE TRENCH IS DEEMED "UNSUITABLE" BY THE ENGINEER, IT SHALL BE DISPOSED OF AS PER SECTION 203-3.01. BACKFILL OF THE TRENCH SHALL BE DONE WITH SUITABLE MATERIAL CONFORMING TO SECTION 203-3.010. THE COST OF THIS MATERIAL, REGARDLESS OF THE SOURCE, SHALL BE INCLUDED IN ITEM 206.0201.
 - ITEM 407.0103 - STRAIGHT TACK COAT WILL BE USED BETWEEN ALL LAYERS/LIFTS OF ASPHALT AND ON VERTICAL FACE OF SAWCUT IN ACCORDANCE WITH TABLE 407-1 OF THE NYSDOT STANDARD SPECIFICATIONS.
 - SUPPORT OF THE EXCAVATION SHALL BE DESIGNED BY THE CONTRACTOR AND SUBMITTED TO THE ENGINEER AND NYSDOT FOR REVIEW AND APPROVAL. THE SUPPORT SHALL ENSURE THAT VEHICLE LOADING CAN BE CARRIED WITHOUT FAILURE OF THE SIDE SLOPES. IF STEEL PLATES ARE TO BE USED TO COVER THE TRENCH WHEN REOPENING THE ROAD TO TRAFFIC, THEY SHALL BE APPROVED BY THE ENGINEER AND NYSDOT.

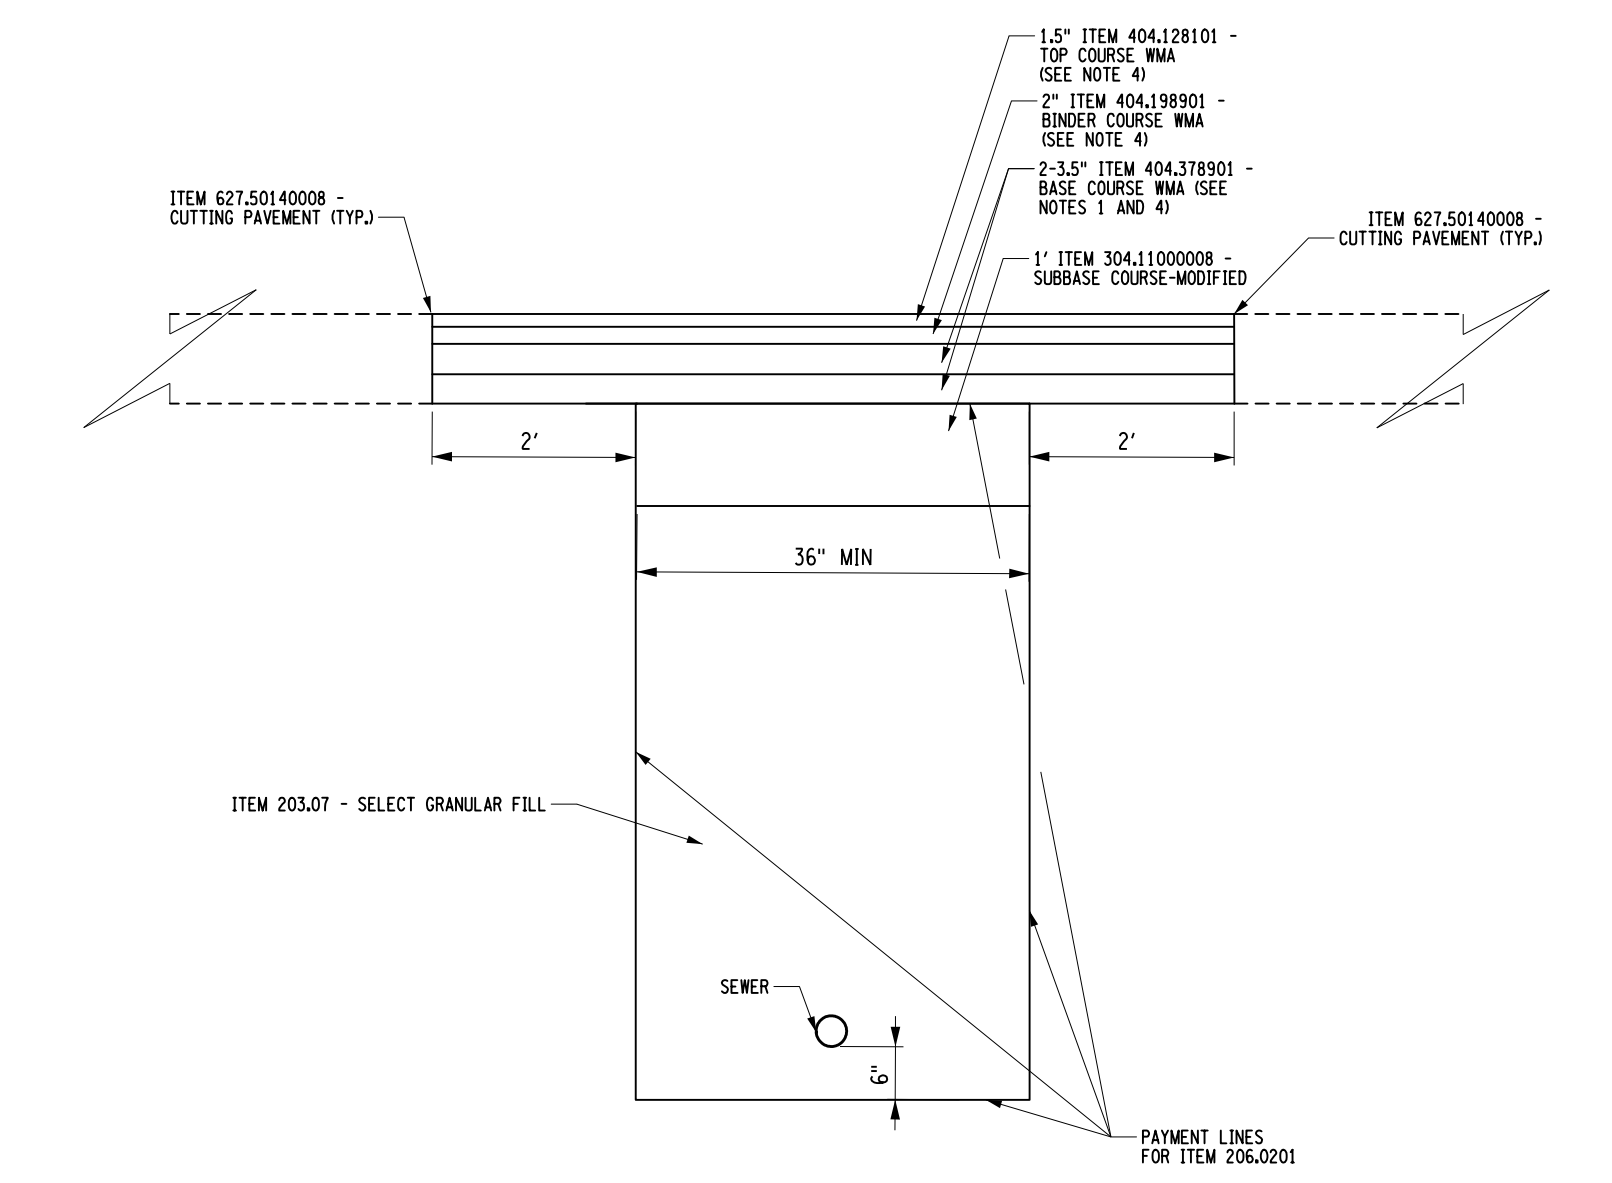


- NOTES:**
- REPLACED PAVEMENT SHALL MATCH EXISTING FULL DEPTH ASPHALT THICKNESS.
 - REPLACED SUBBASE SHALL MATCH EXISTING FULL DEPTH SUBBASE THICKNESS.
 - THE TRENCH SHALL BE BACKFILLED ABOVE ITEM 203.07 LIMIT WITH SUITABLE MATERIAL. IF MATERIAL EXCAVATED FROM THE TRENCH IS DEEMED "UNSUITABLE" BY THE ENGINEER, IT SHALL BE DISPOSED OF AS PER SECTION 203-3.01. BACKFILL OF THE TRENCH SHALL BE DONE WITH SUITABLE MATERIAL CONFORMING TO SECTION 203-3.010. THE COST OF THIS MATERIAL, REGARDLESS OF THE SOURCE, SHALL BE INCLUDED IN ITEM 206.0201.
 - ITEM 407.0103 - STRAIGHT TACK COAT WILL BE USED BETWEEN ALL LAYERS/LIFTS OF ASPHALT AND ON VERTICAL FACE OF SAWCUT IN ACCORDANCE WITH TABLE 407-1 OF THE NYSDOT STANDARD SPECIFICATIONS.
 - SUPPORT OF THE EXCAVATION SHALL BE DESIGNED BY THE CONTRACTOR AND SUBMITTED TO THE ENGINEER AND NYSDOT FOR REVIEW AND APPROVAL. THE SUPPORT SHALL ENSURE THAT VEHICLE LOADING CAN BE CARRIED WITHOUT FAILURE OF THE SIDE SLOPES. IF STEEL PLATES ARE TO BE USED TO COVER THE TRENCH WHEN REOPENING THE ROAD TO TRAFFIC, THEY SHALL BE APPROVED BY THE ENGINEER AND NYSDOT.

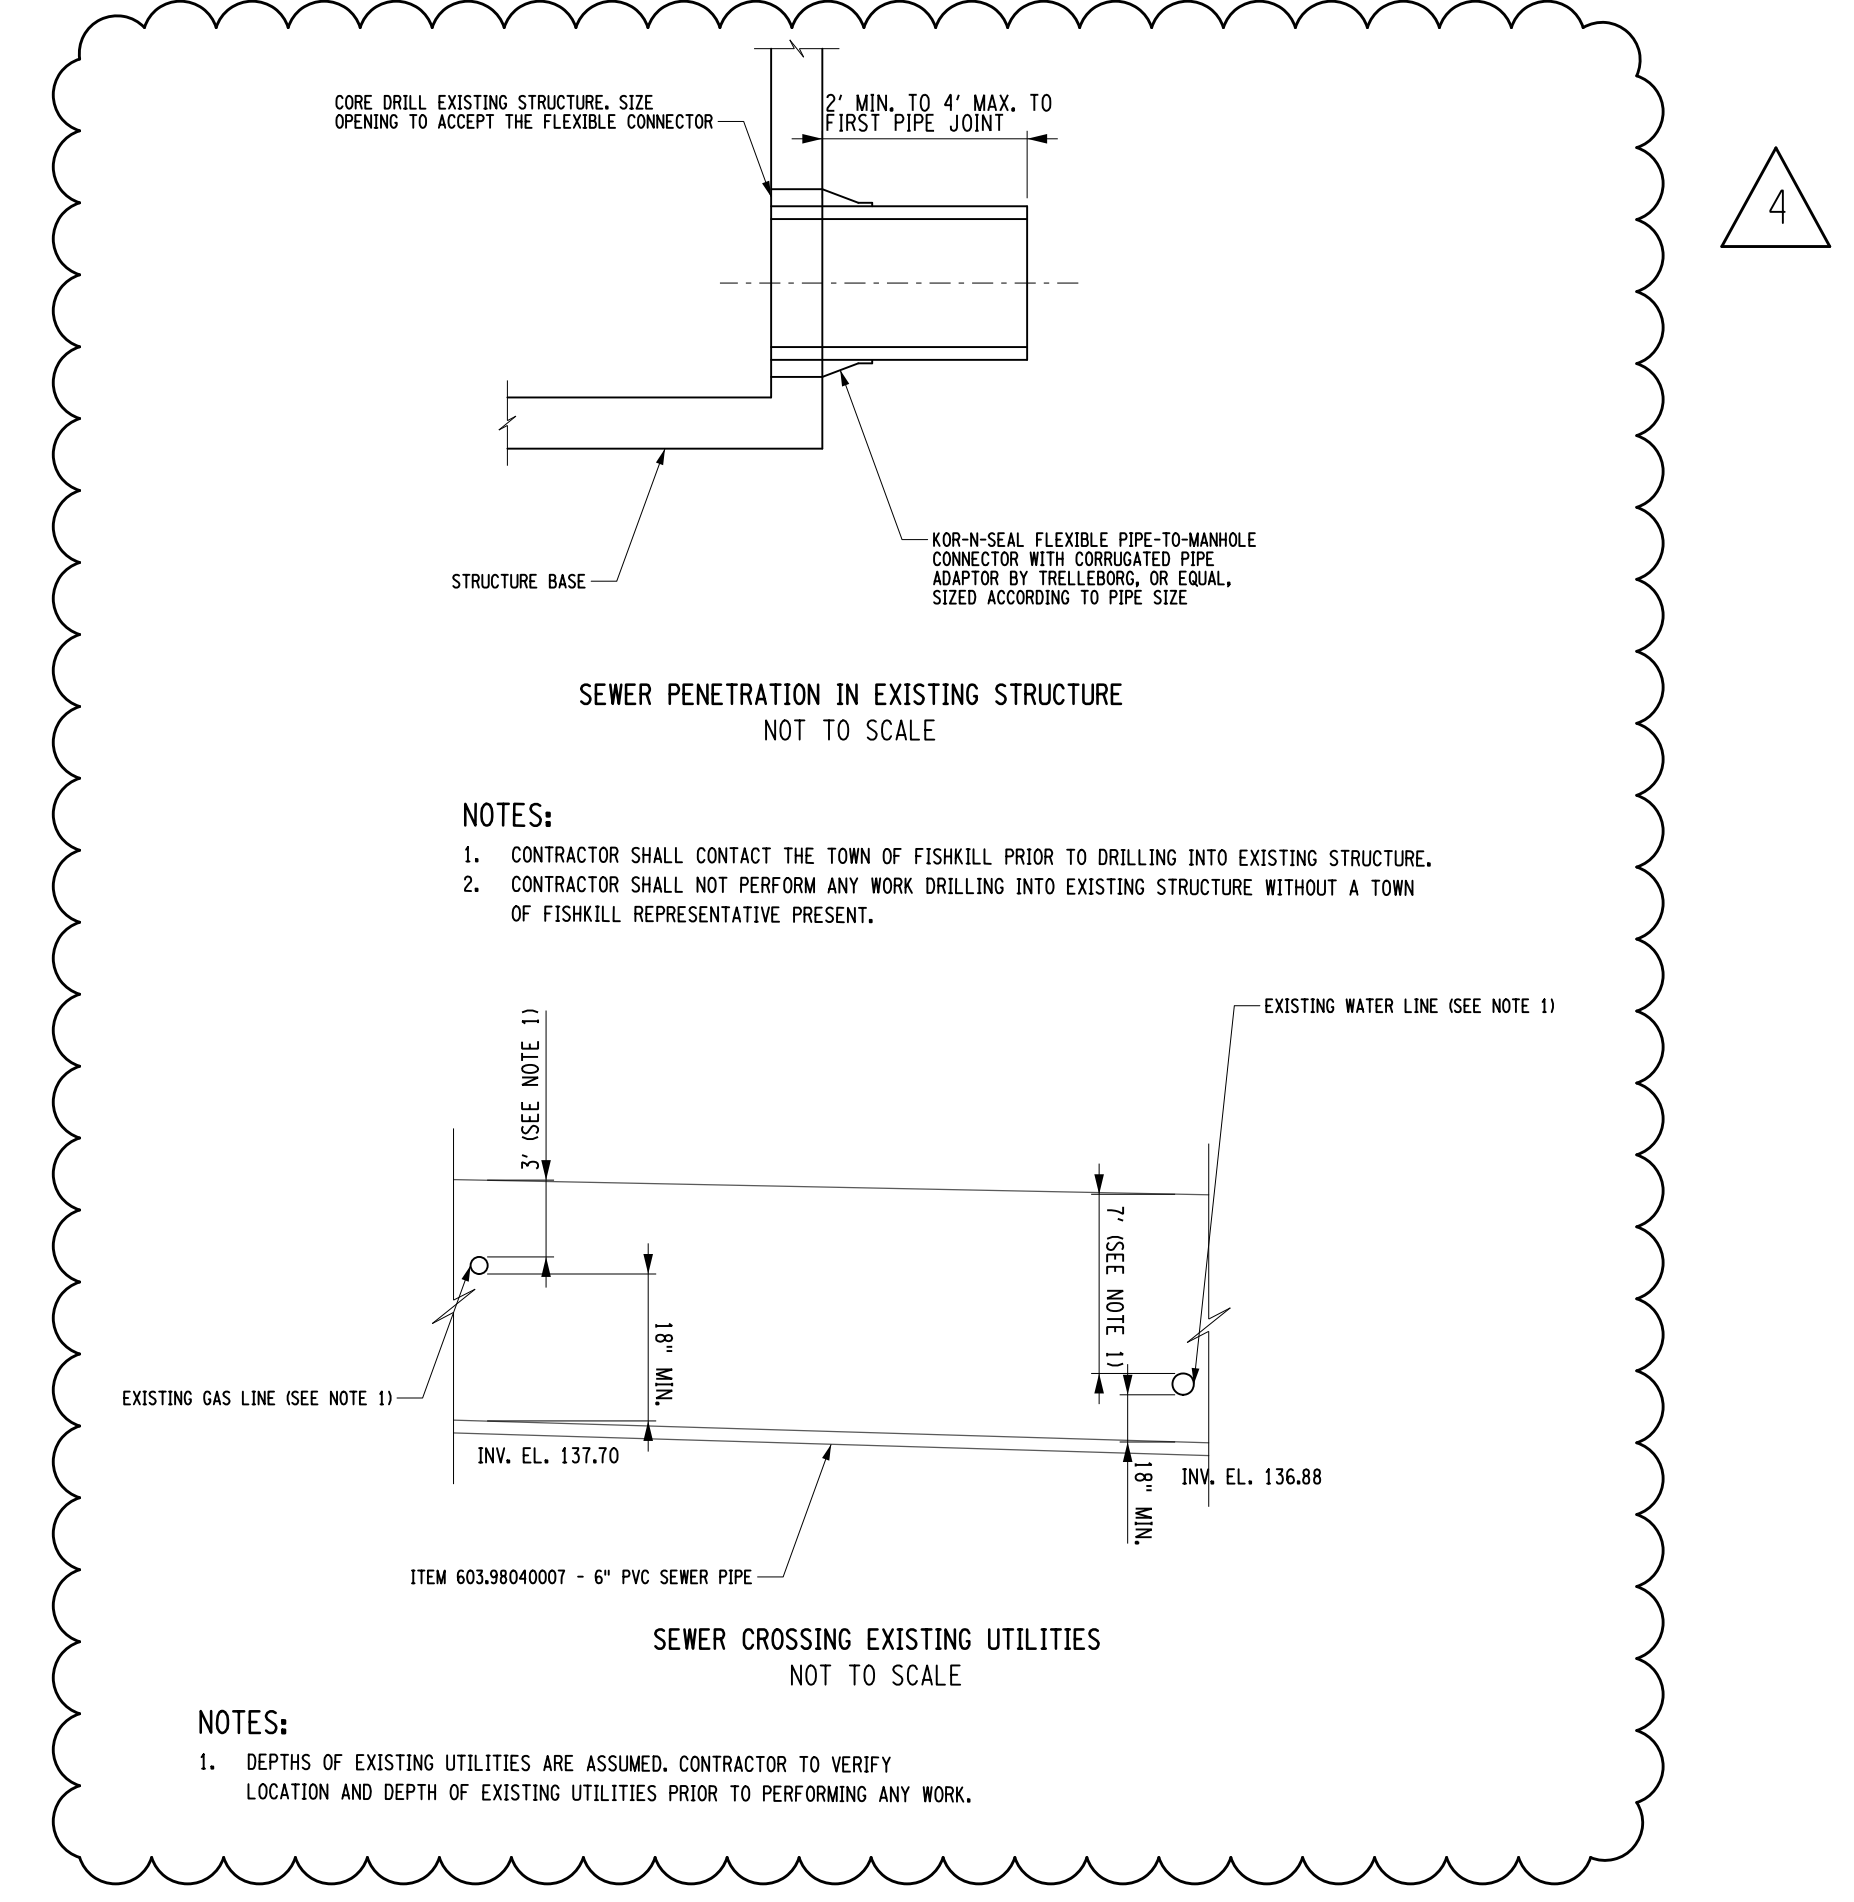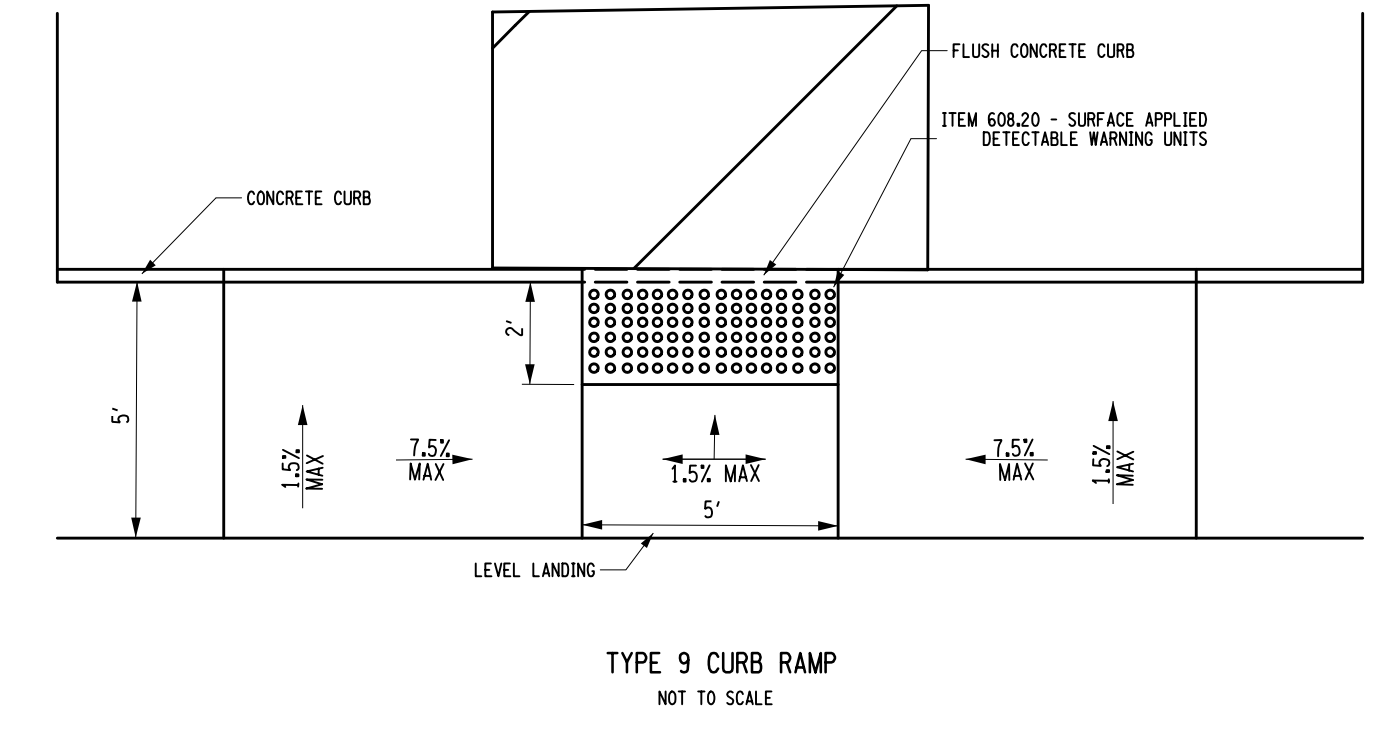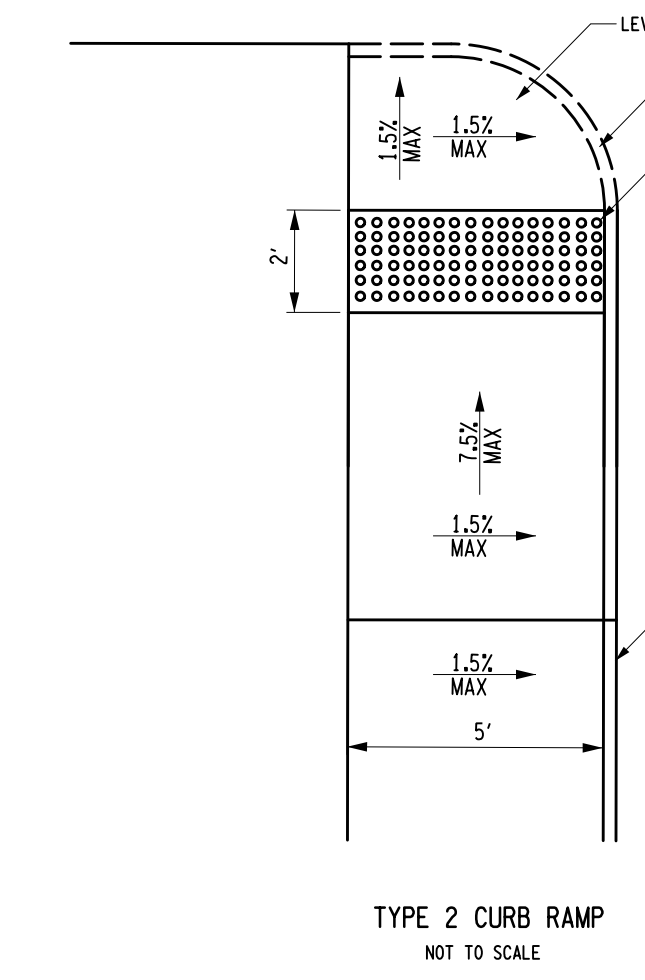


- NOTES:**
- CONTRACTOR SHALL CONTACT THE TOWN OF FISHKILL PRIOR TO DRILLING INTO EXISTING STRUCTURE.
 - CONTRACTOR SHALL NOT PERFORM ANY WORK DRILLING INTO EXISTING STRUCTURE WITHOUT A TOWN OF FISHKILL REPRESENTATIVE PRESENT.


WATER LINE PROFILE
NOT TO SCALE

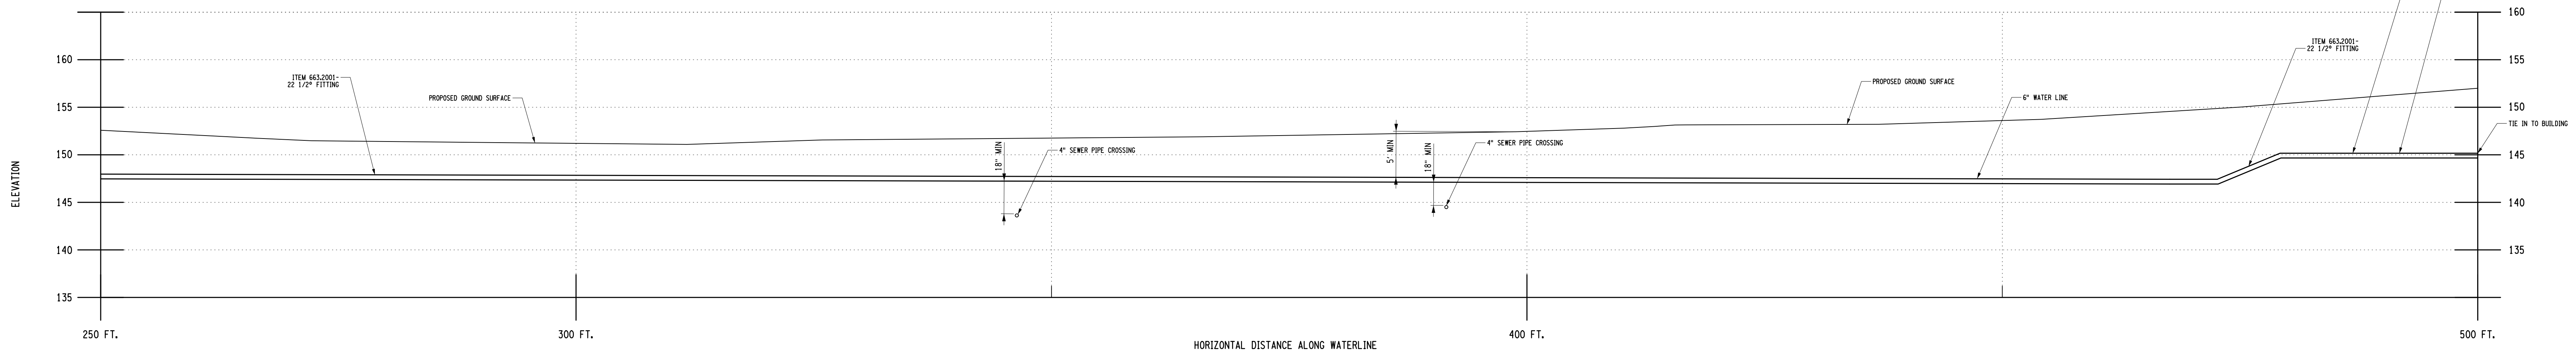


1
2
3
4
5

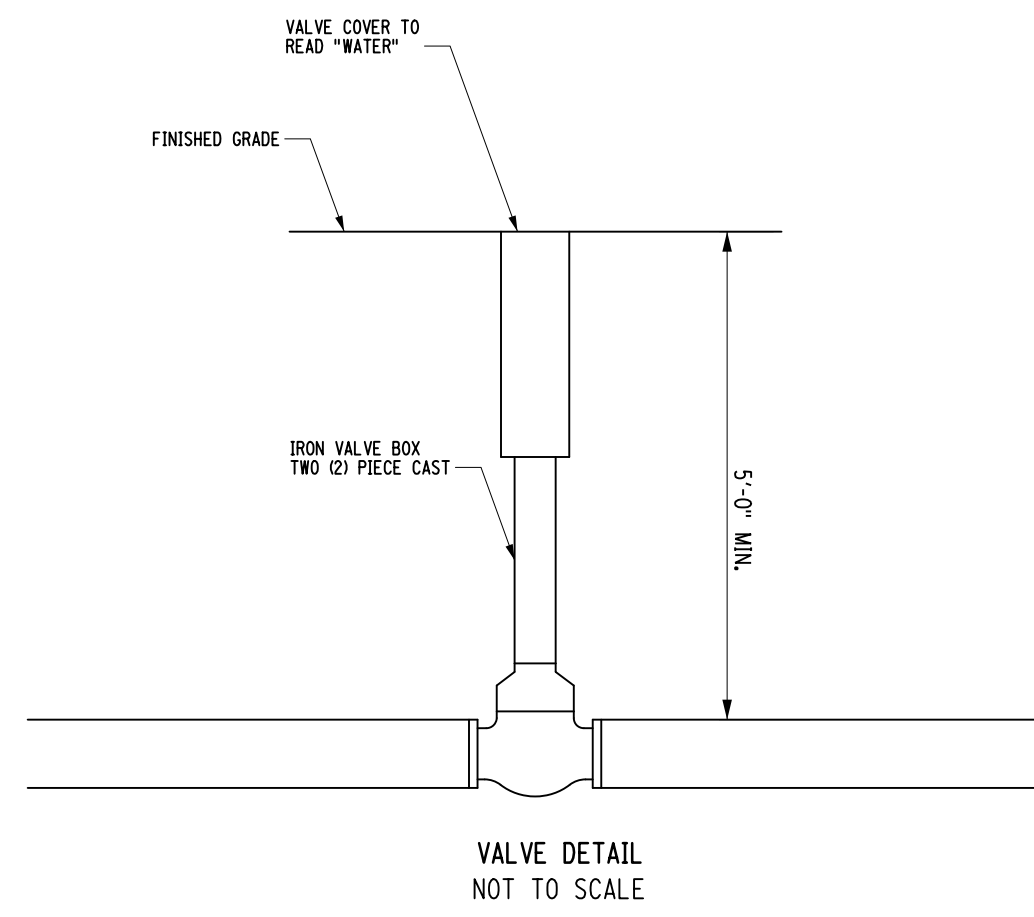


- NOTES:**
1. NON-REISING STEM GATE VALVE, OPERATING DIRECTION SHALL BE COUNTERCLOCKWISE TO OPEN.
 2. MINIMUM DISTANCE TO JOINTS, FITTINGS OR OTHER CORPORATION STOPS SHALL BE 3 FEET.
 3. IF VALVE IS TO BE ROODED, PROVIDE VALVE WITH ROODING FLANGES OR EYEBOLTS. TWO 3/4" GALVANIZED STEEL RODS WITH MAILABLE IRON NUTS AT 180 DEGREE SPACING SHALL BE USED FOR ROODING VALVES.
 4. VALVES AND FITTINGS SHALL CONFORM TO ANWA C500 LATEST EDITION SPECIFICATIONS.
 5. ALL VALVES SHALL OPEN COUNTERCLOCKWISE AND BE PROVIDED WITH STANDARD WRENCH NUT.
 6. EACH VALVE SHALL BE PROVIDED WITH A TWO PIECE SLICE TYPE VALVE BOX.
 7. GATE VALVE SHALL BE IRON BODY, BRONZE MOUNTED, INSIDE SCREW, DOUBLE DISC, PARALLEL SEAT.

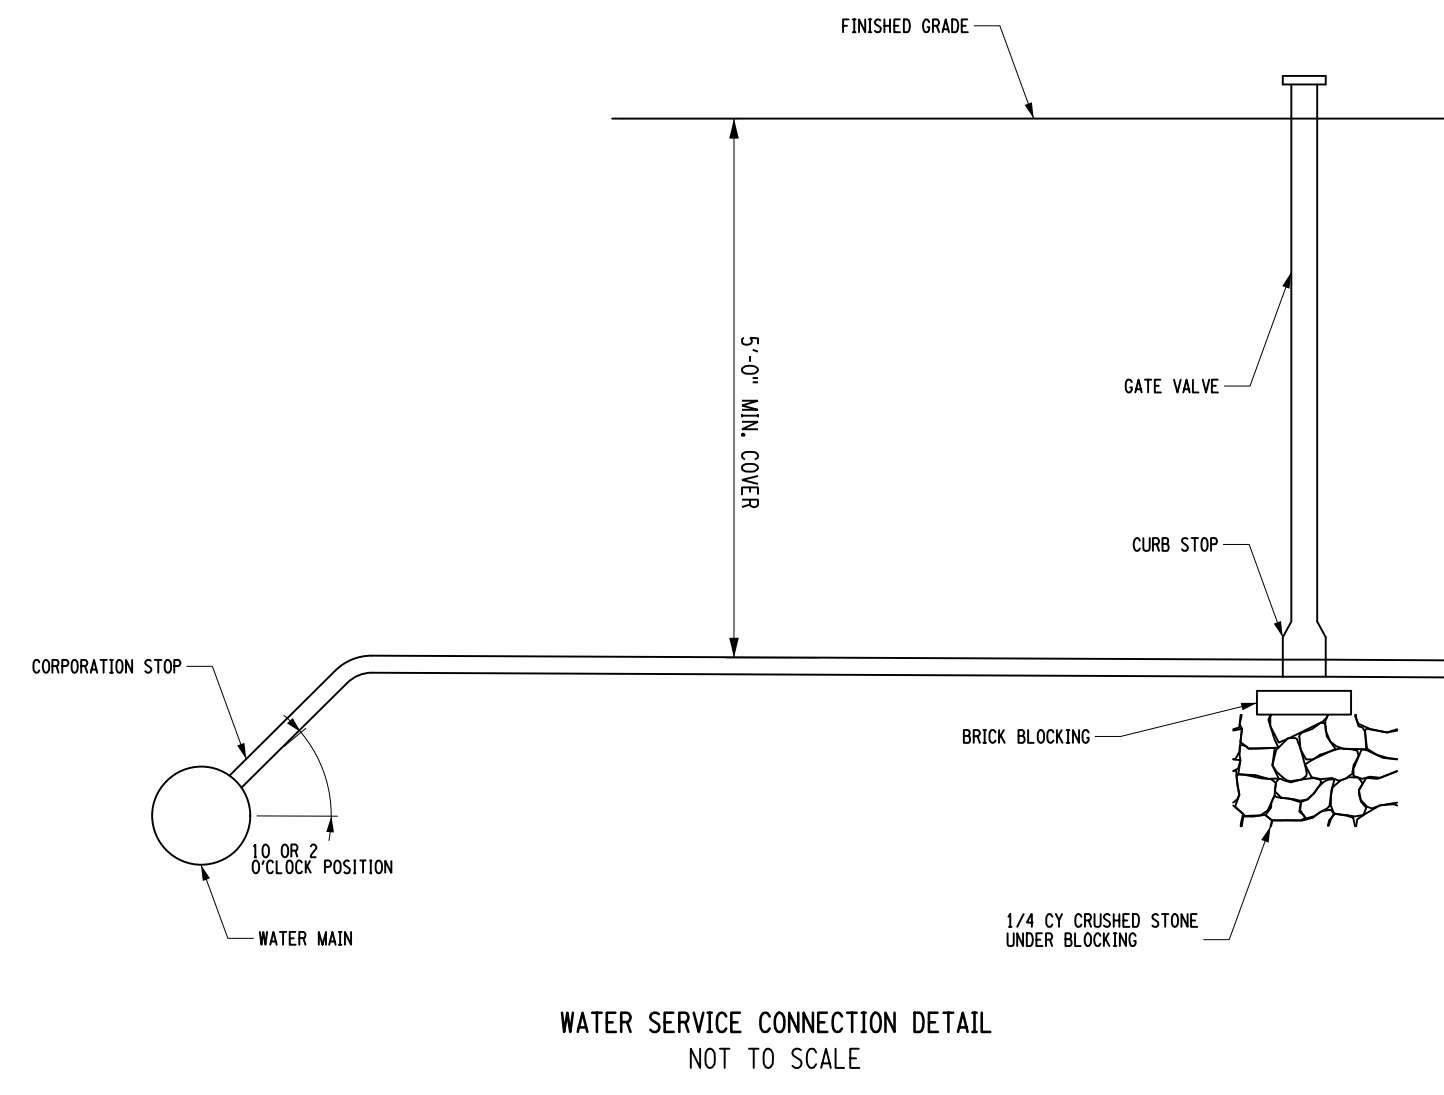


- NOTES:**
1. INSTALLATION OF MILLER WET TAP(2 O'CLOCK POSITION).
 2. SERVICE TAPS SHALL CONFORM TO ANWA C500, SECTION 7 LATEST EDITION.
 3. BACKFILLING SHALL CONFORM TO ANWA C500, SECTION 5.5 LATEST EDITION.
 4. REFER TO PLAN FOR SERVICE SIZE DIA. AND LOCATIONS.
 5. VALVES AND FITTINGS SHALL CONFORM TO ANWA C500 LATEST EDITION.
 6. SERVICE LINES TO BE DISINFECTED IN ACCORDANCE AS PER ANWA 655 LATEST EDITION.
 7. SERVICE LINES SHALL BE VISIBLY TESTED FOR LEAKS PRIOR TO BACKFILLING ENTIRE PIPE. ALL FITTINGS SHALL BE CHECKED.
 8. A WATER METER (REMOTE STYLE) CONFORMING TO ANWA STANDARDS AND WATER DISTRICT REQUIREMENTS SHALL BE INSTALLED.
 9. ALL PRESSURE TESTING TO BE WITNESSED BY REPRESENTATIVES OF THE WATER DISTRICT.
 10. WATER TAPS SHOULD BE LESS THAN 45 DEGREES AND MORE THAN 0 DEGREES IN THE TOP QUADRANT OF THE MAIN.

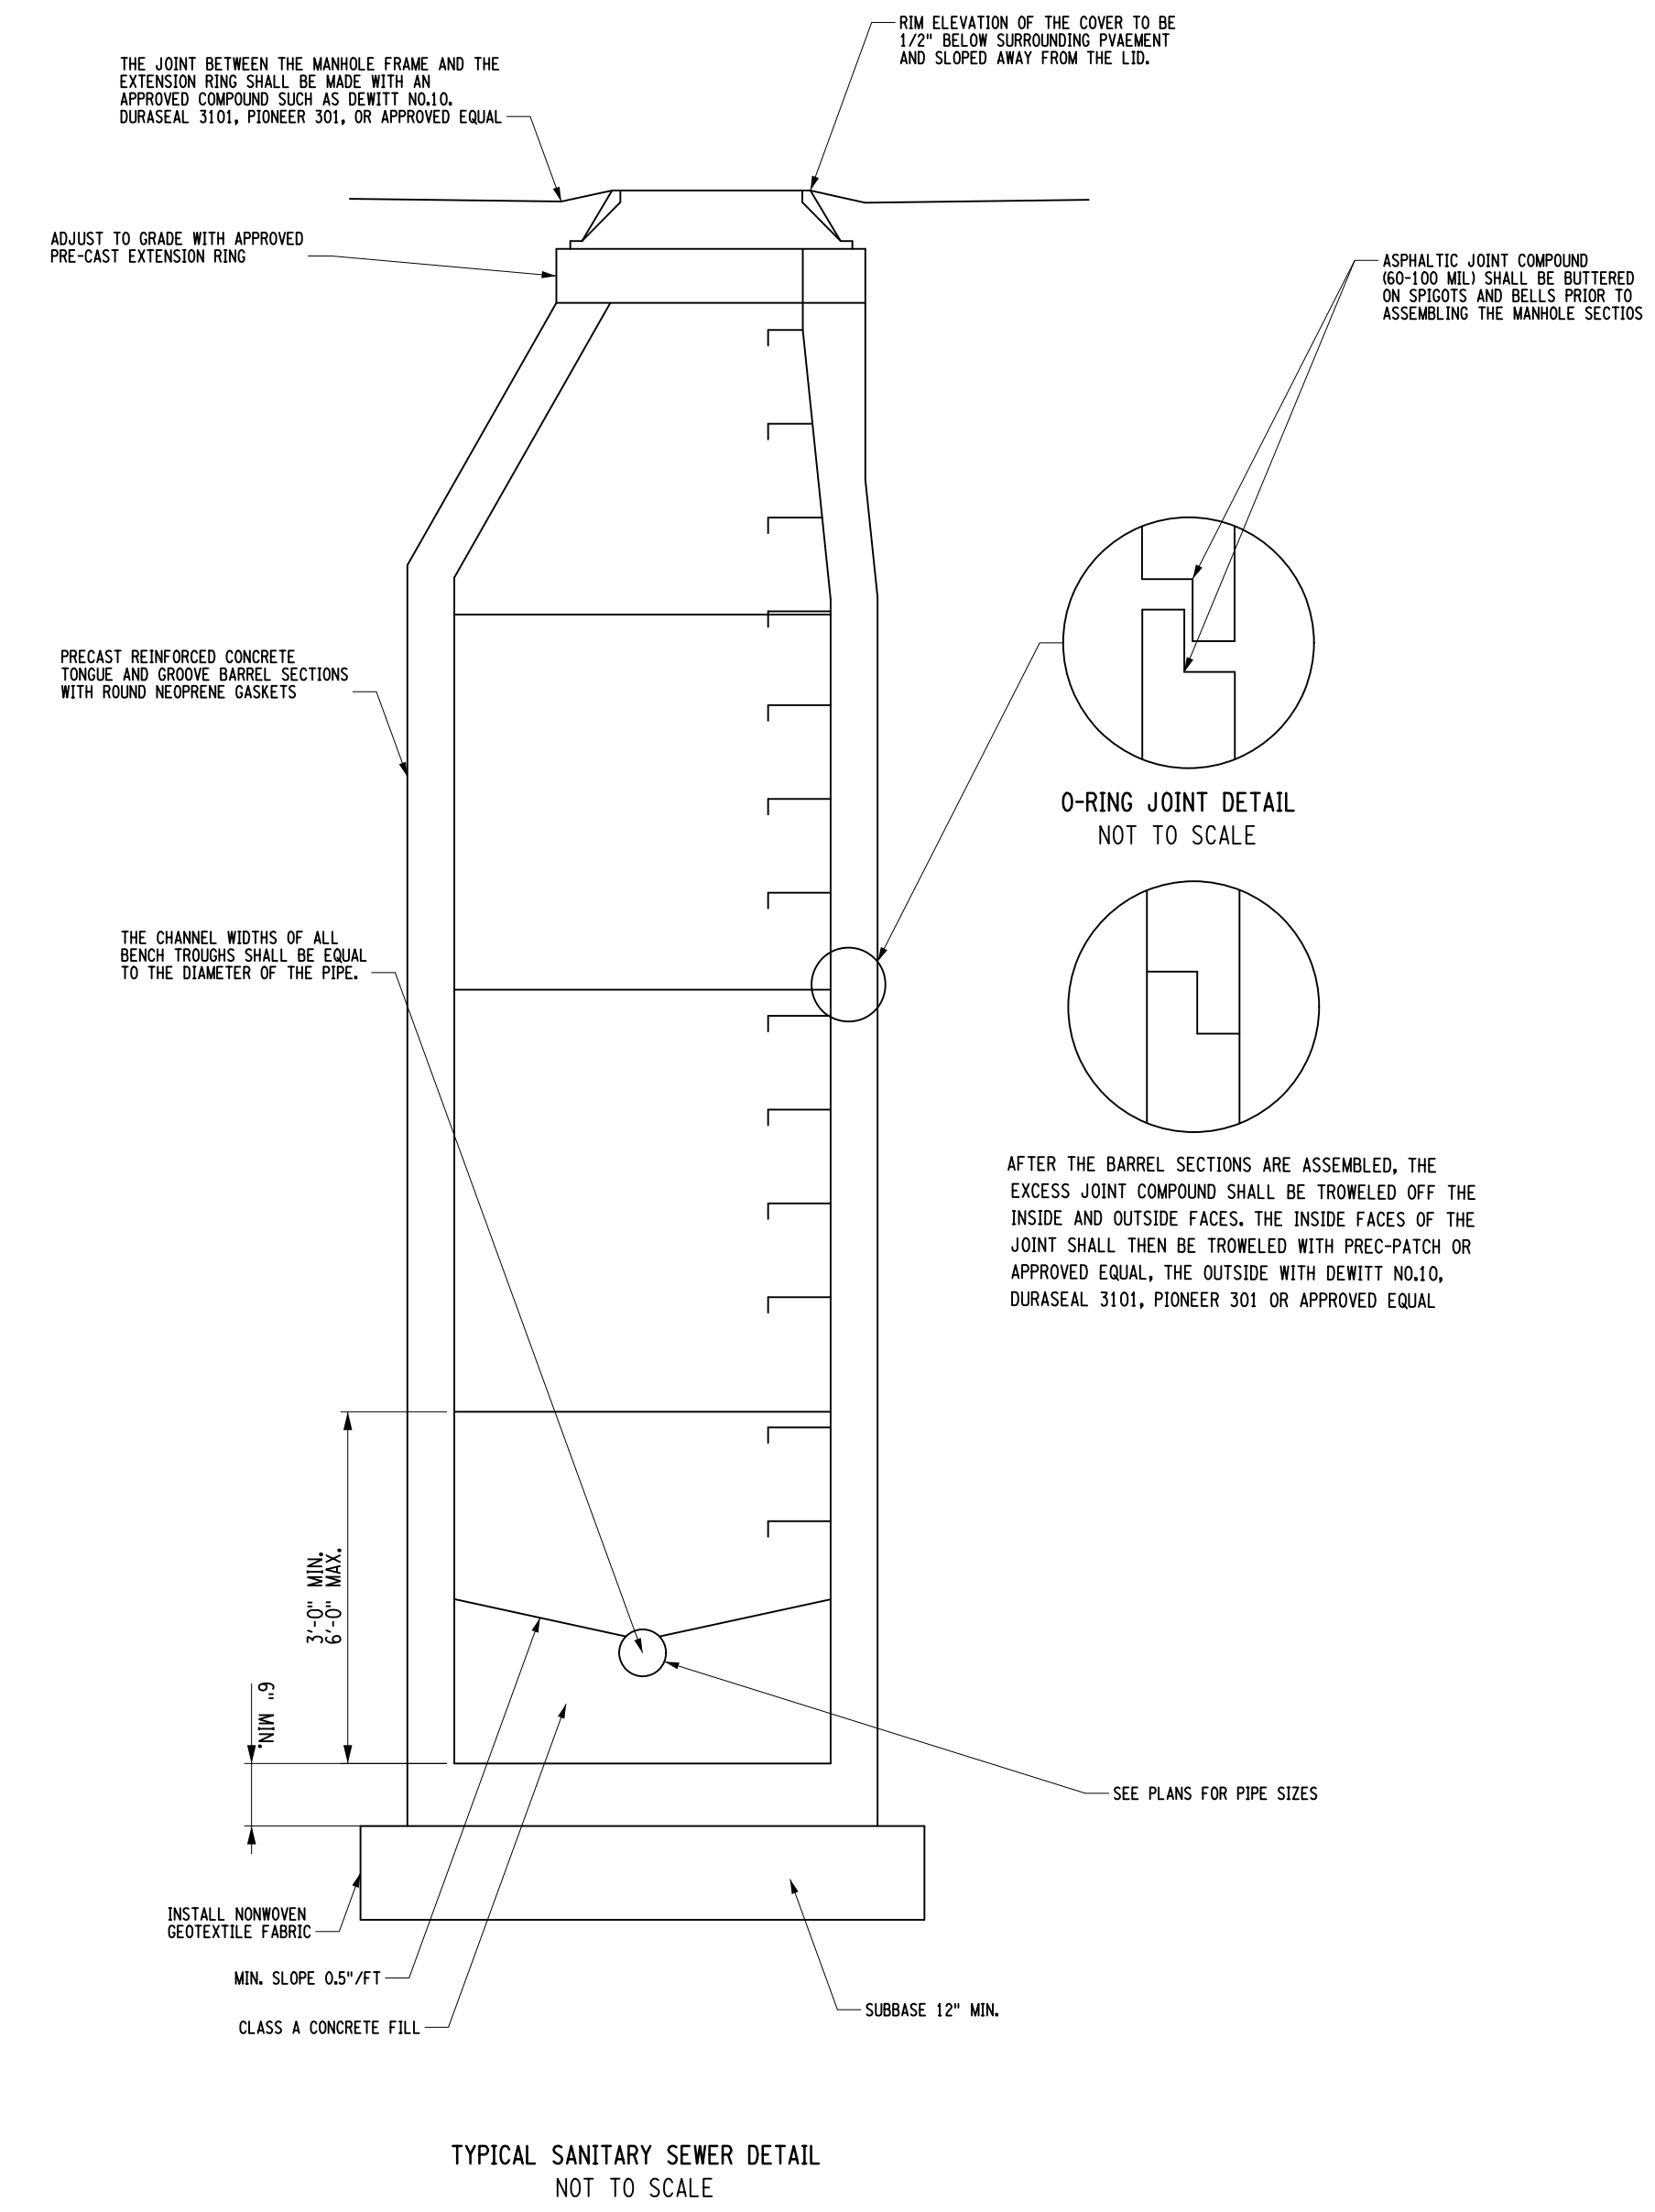

TYPICAL SANITARY SEWER DETAIL
NOT TO SCALE

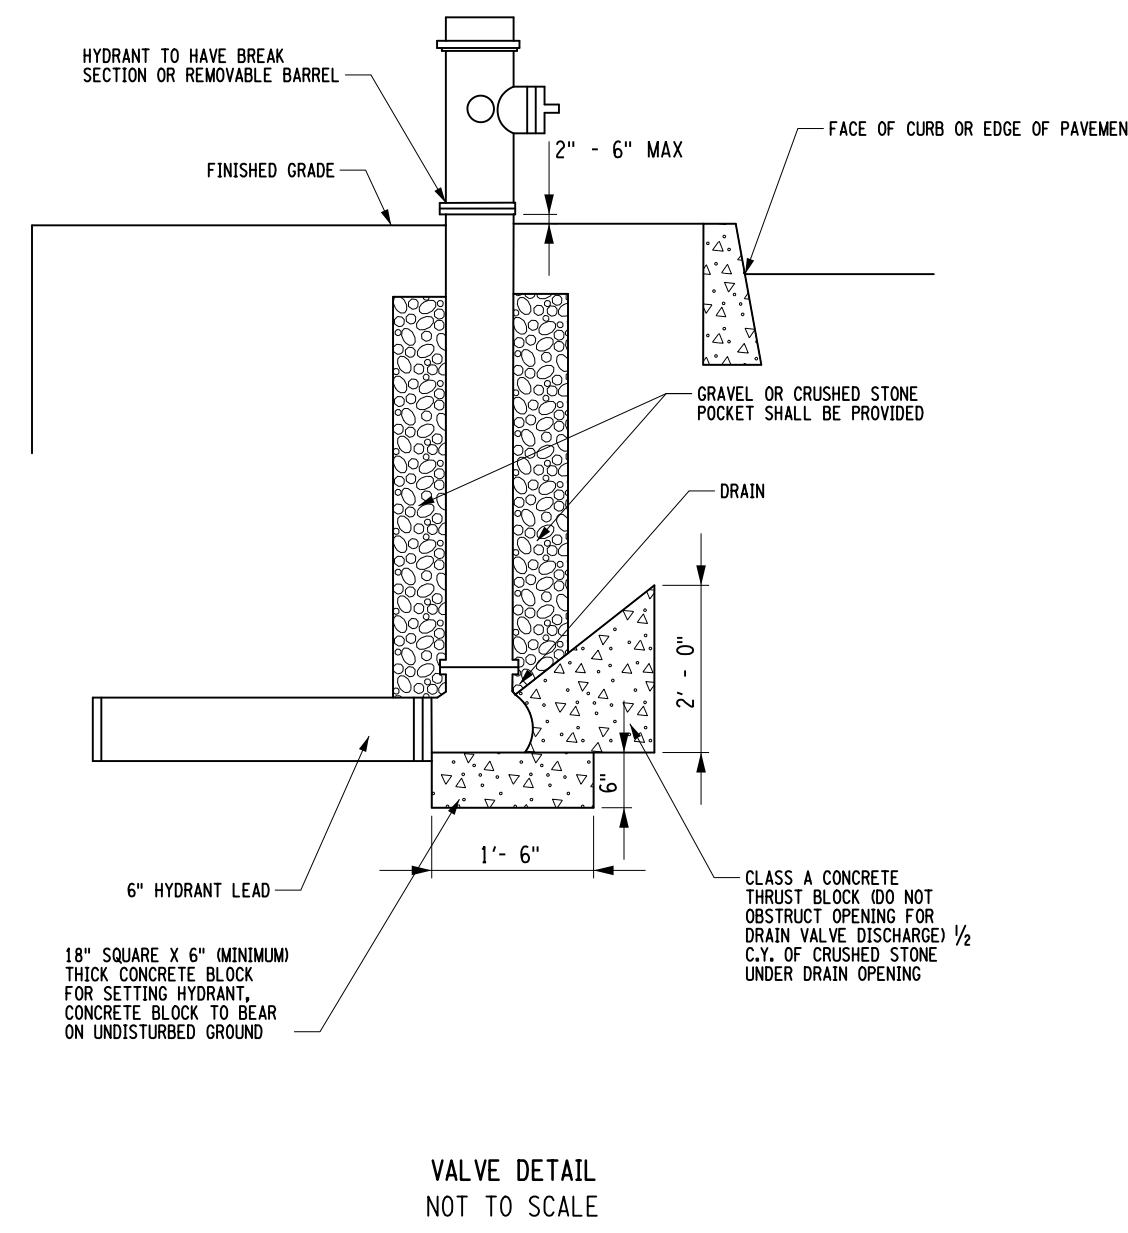


- NOTES:**
1. ALL CONCRETE THRUST BLOCKS SHALL BEAR ON UNDISTURBED GROUND.
 2. ROODING SHALL CONSIST OF TWO 3/4" THREADED STEEL TIE RODS WITH NUTS AND WASHERS COMPLETE WITH ALL NECESSARY AND REQUIRED CLAMPS. CAREFULLY AND THOROUGHLY COVERED WITH ASPHALT OR OTHER ACCEPTABLE CORROSION RESISTING MATERIAL. IN GENERAL, THE METHOD AND TYPES OF MATERIAL REQUIRED IN THE INSTALLATION OF CLAMPS AND THE RODS SHALL BE IN ACCORDANCE WITH THE LATEST NATIONAL FIRE PROTECTION STANDARDS.
 3. HYDRANT DRAINS SHALL NOT BE CONNECTED TO OR WITHIN TEN (10) FEET OF ANY SANITARY SEWERS OR STORM DRAINS.
 4. IF GROUND WATER IS FOUND WITHIN SEVEN (7) FEET OF THE SURFACE, HYDRANT DRAINS ARE TO BE PLUGGED. WHEN DRAINS ARE TO BE PLUGGED, THE BARRELS MUST BE PUMPED DRY AFTER USE DURING FREEZING WEATHER. SUCH HYDRANTS SHALL BE IDENTIFIED WITH A VISIBLE MARKING AS APPROVED BY THE WATER AUTHORITY.

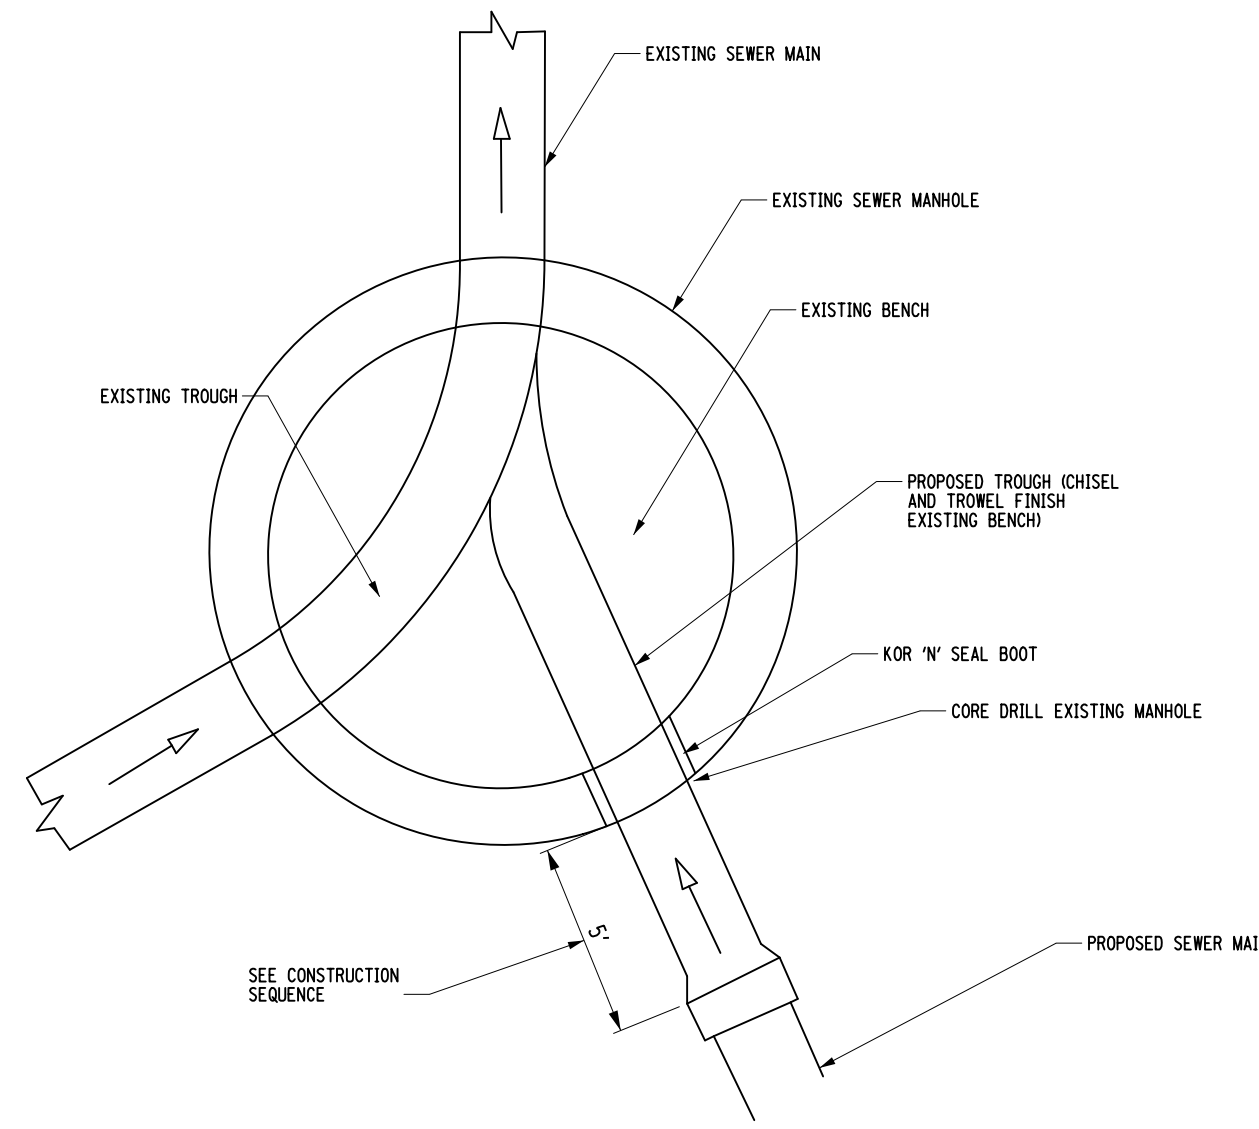


CONNECTION TO EXISTING SEWER MANHOLE CONSTRUCTION SEQUENCE
NOT TO SCALE

- CONNECTION TO EXISTING SEWER MANHOLE CONSTRUCTION SEQUENCE**
1. INSTALL PROPOSED SEWER MAIN PIPING TO WITHIN 5' OF THE EXISTING SEWER MANHOLE.
 2. PERFORM REQUIRED ACCEPTANCE TESTING OF SEWER MAIN.
 3. AFTER TESTING OF NEW SEWER MAIN, CORE DRILL EXISTING MANHOLE AND CONNECT PROPOSED PIPING TO EXISTING MANHOLE.
 4. ONCE THE NEW SEWER MAIN HAS BEEN CONNECTED TO THE EXISTING SEWER MANHOLE FROM NEW TROUGH BY CHISELING AND TREMEL FINISH EXISTING BENCH AND TROUGH.
- PROPOSED SEWER CONNECTION TO EXISTING SEWER MANHOLE DETAIL (OUTSIDE)**

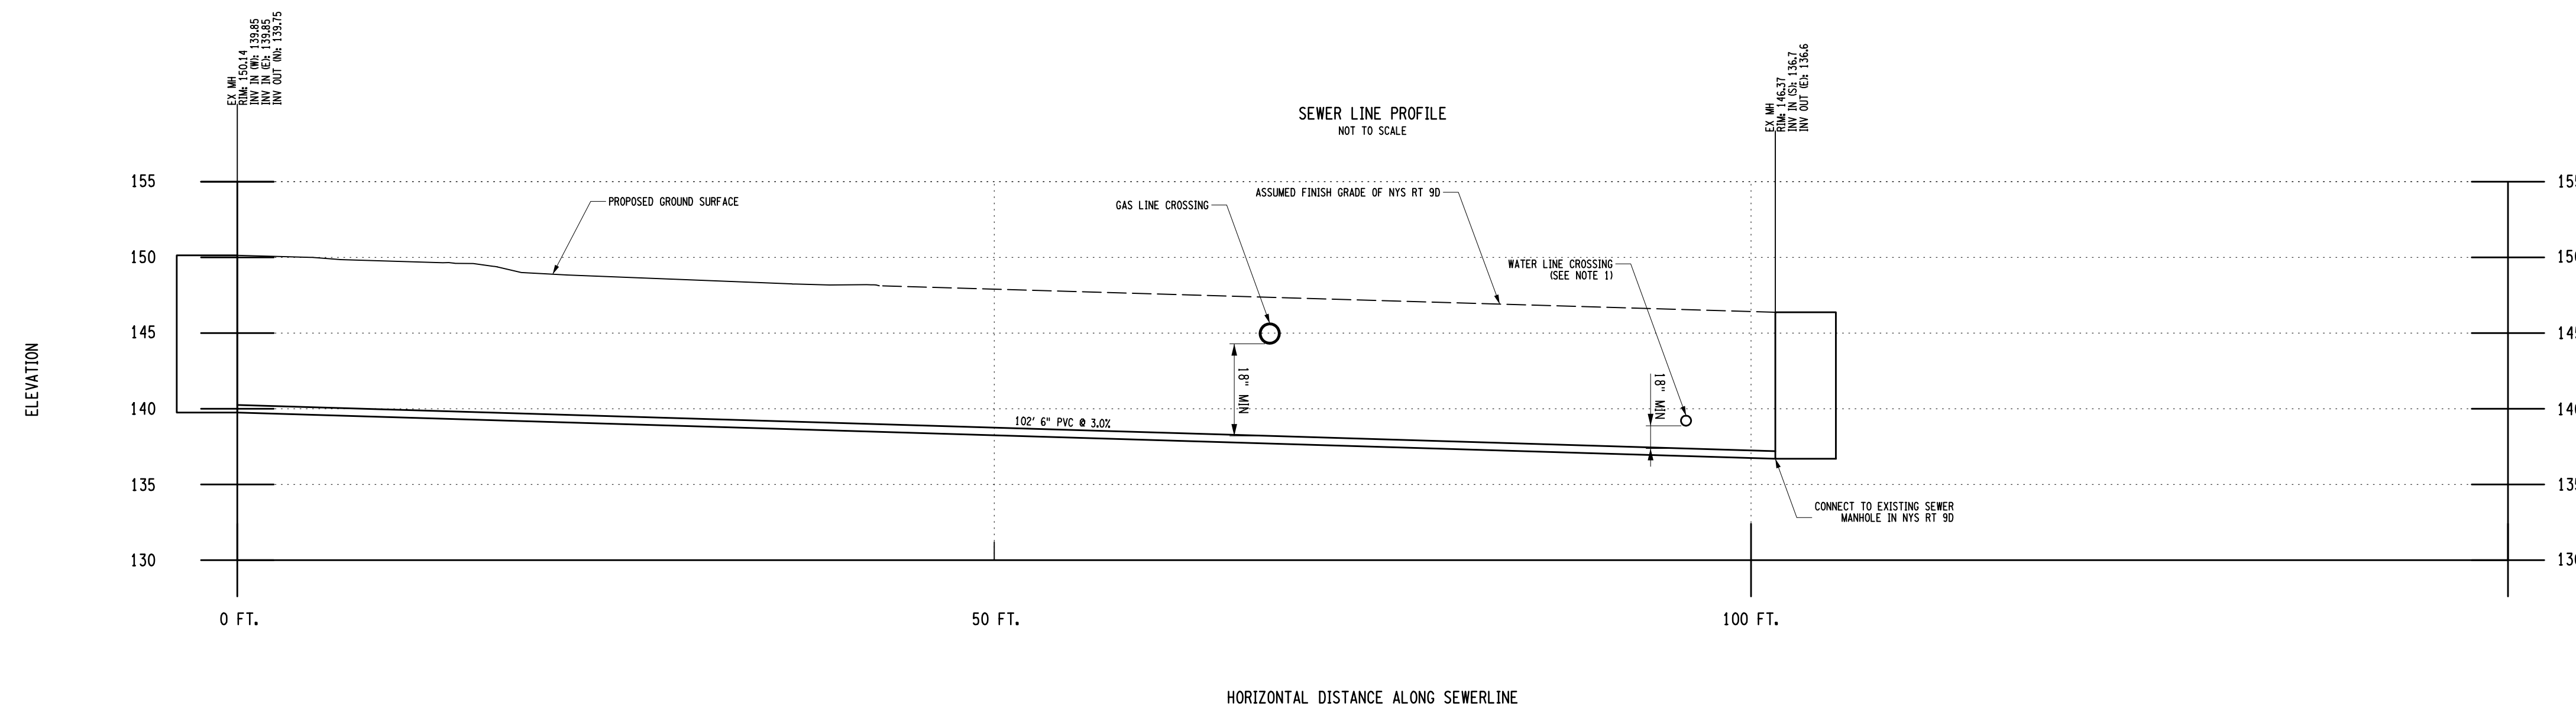

- NOTES:**
1. WATER LINE SHALL BE SUPPORTED DURING THE DURATION OF WORK. SUPPORT SHALL BE INSTALLED PRIOR TO SANITARY SEWER TIE-IN.



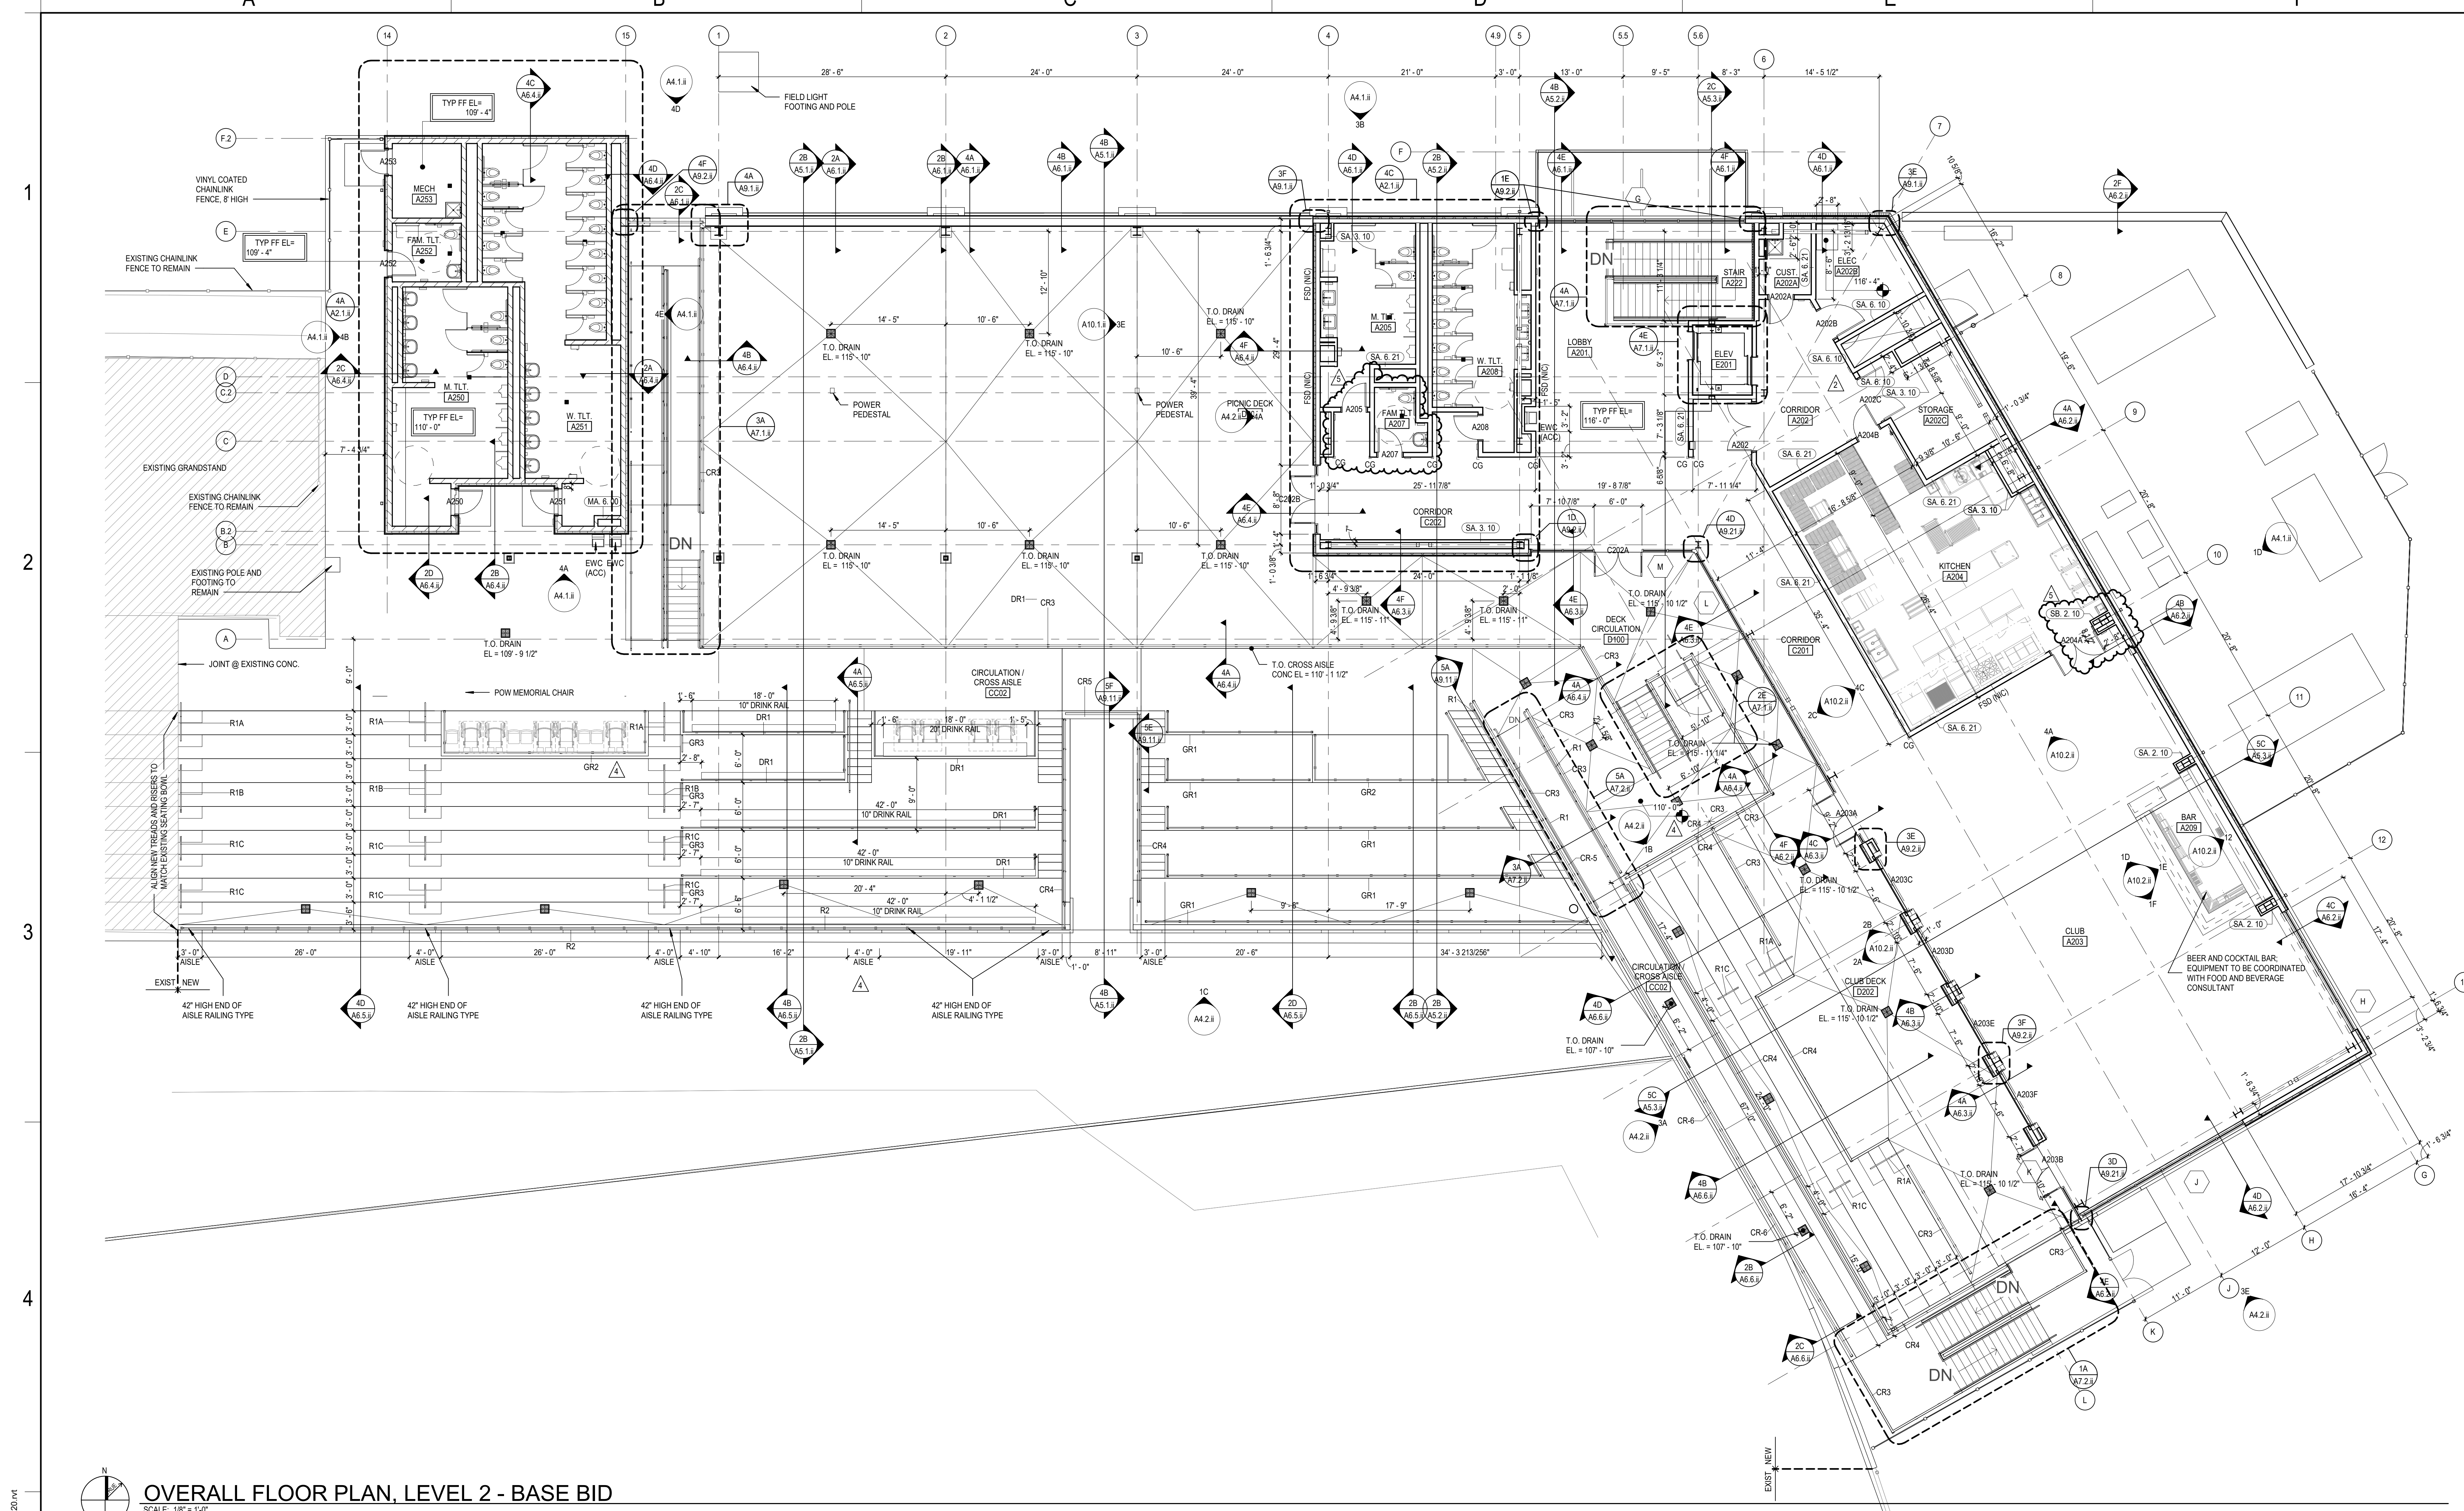



OVERALL FLOOR PLAN, LEVEL 2 - BASE BID
SCALE: 1/8" = 1'-0"

REFERENCE KEYNOTES

SHEET NOTES

- 1 INFILL OR PATCH AND REPAIR CONCRETE SLAB AREA
- 2 PATCH AND REPAIR WALL
- 3 REFERENCE FINISH PLANS FOR CONCRETE JOINTING PATTERN
- 4 FULLY-GROUT COLLAR JOINT.

KEY PLAN

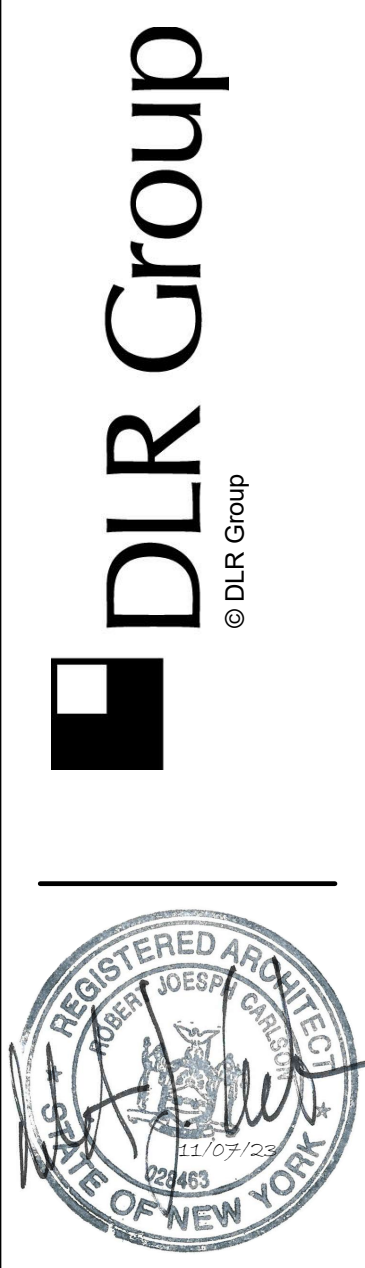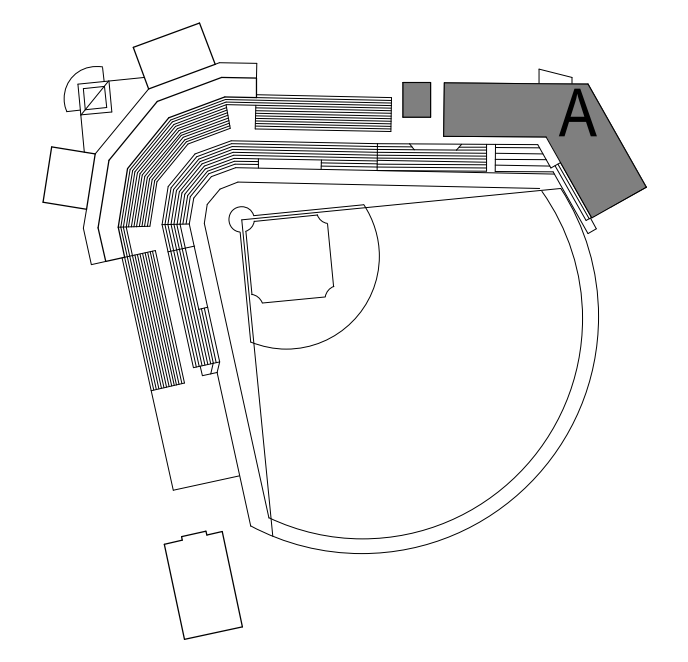

REBID DUTCHESS STADIUM NEW LEFT FIELD CLUBHOUSE, SEATING BOWL, & RESTROOM BUILDING
OWNER: DUTCHESS COUNTY, 22 MARKET STREET Poughkeepsie, NY 12601
1500 ROUTE 90, FISHKILL, NY 12901

BID SET
11.04.22





REVISIONS

1	CONSTRUCTION DOCS	03.06.23
2	AS 100	06.07.23
3	AS 109	06.08.23
4	AS 109	08.15.23
5	AS 011	11.07.23

57-21113-00
FLOOR PLAN - AREA A - LEVEL 2

A1.2A.ii

BM 360/02-21113-00_Dutchess Stadium Ph II 57-21113-00_Dutchess Stadium_Ph II_AR_2020.rvt
 11/07/2023 3:55:17 PM

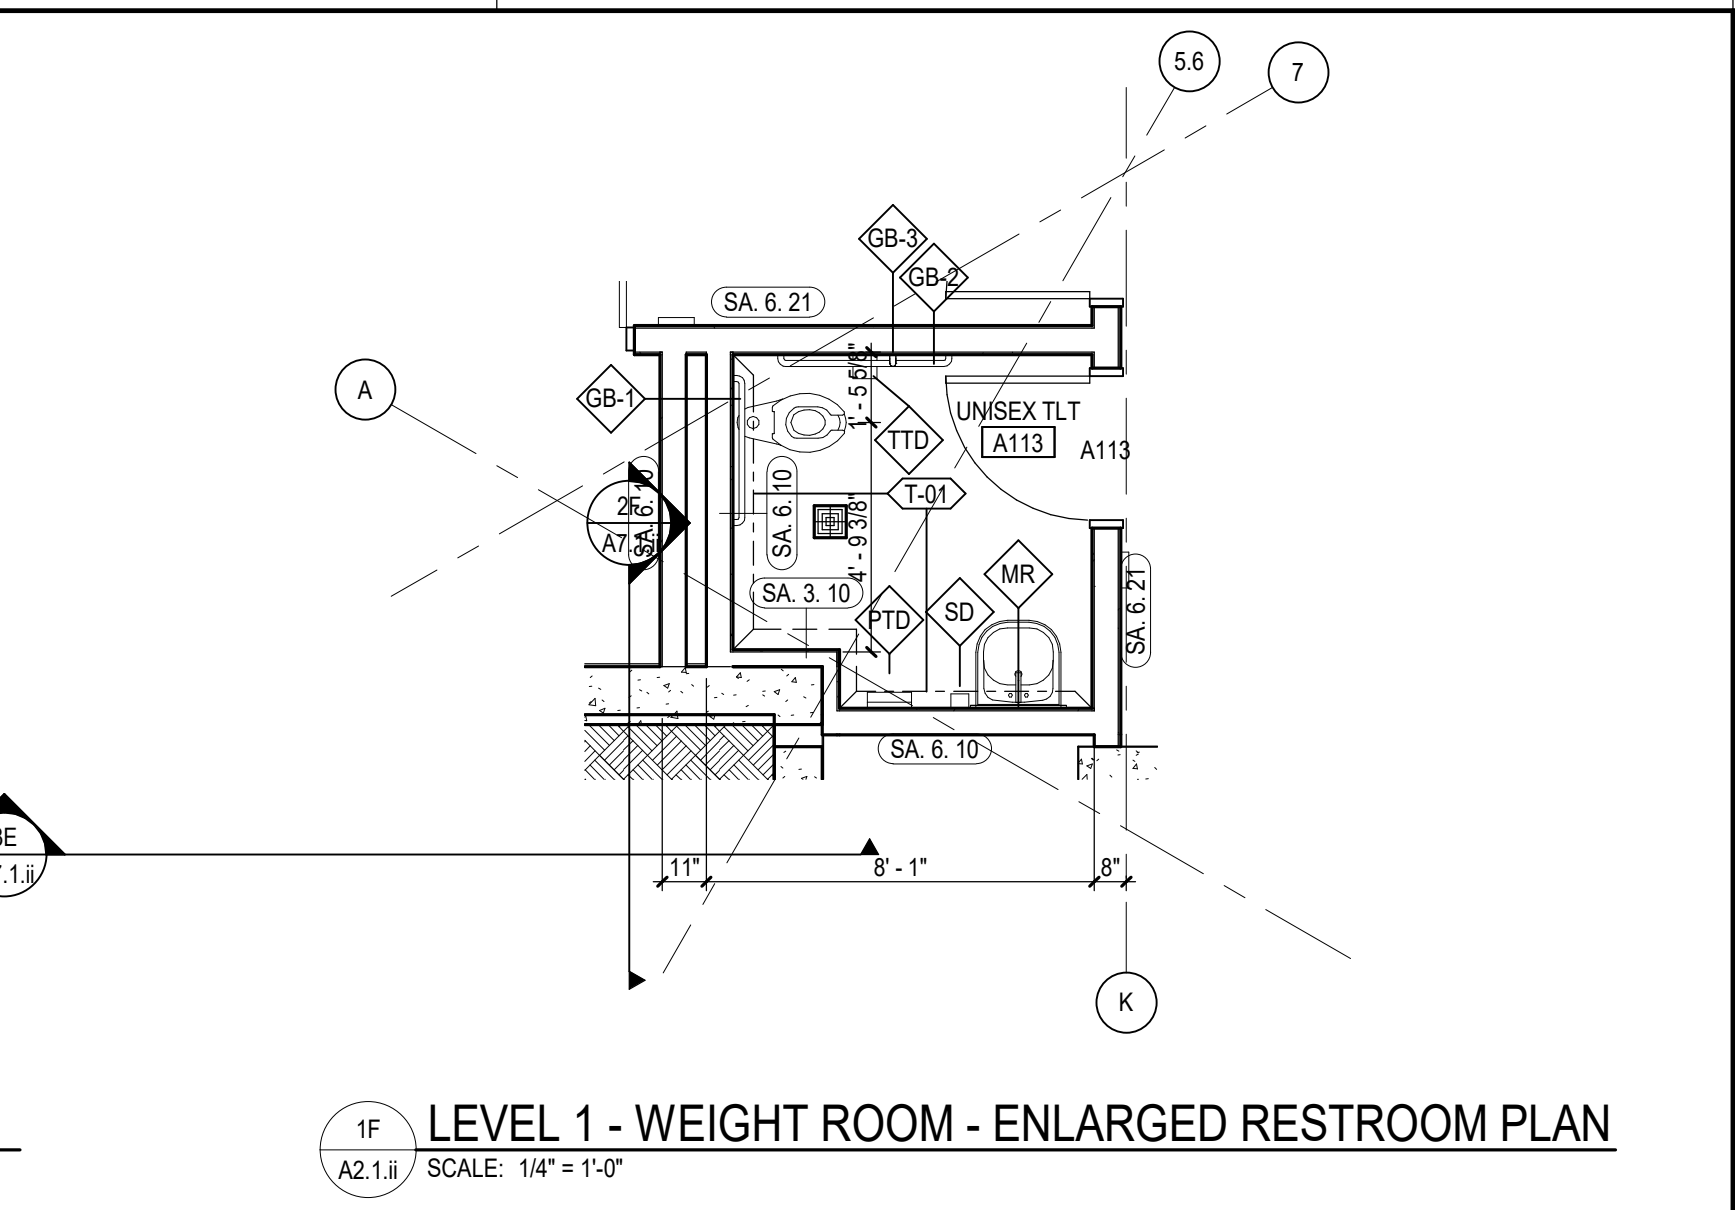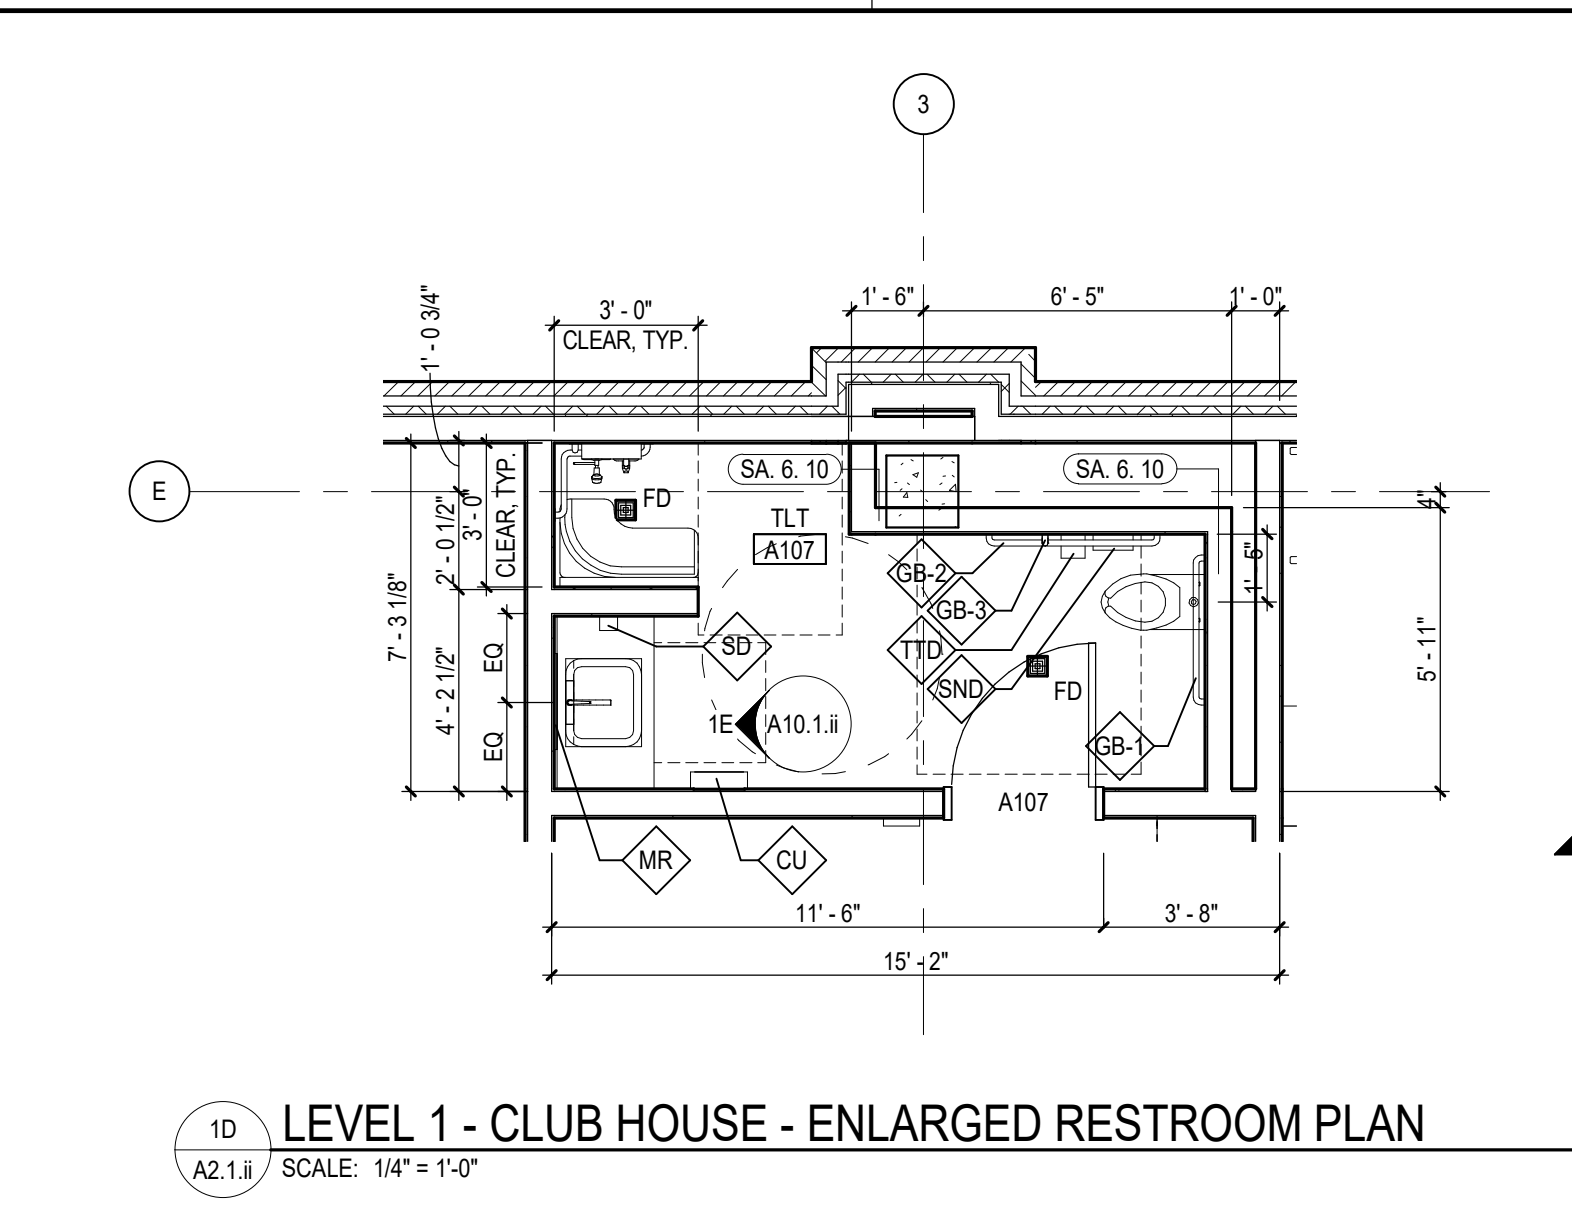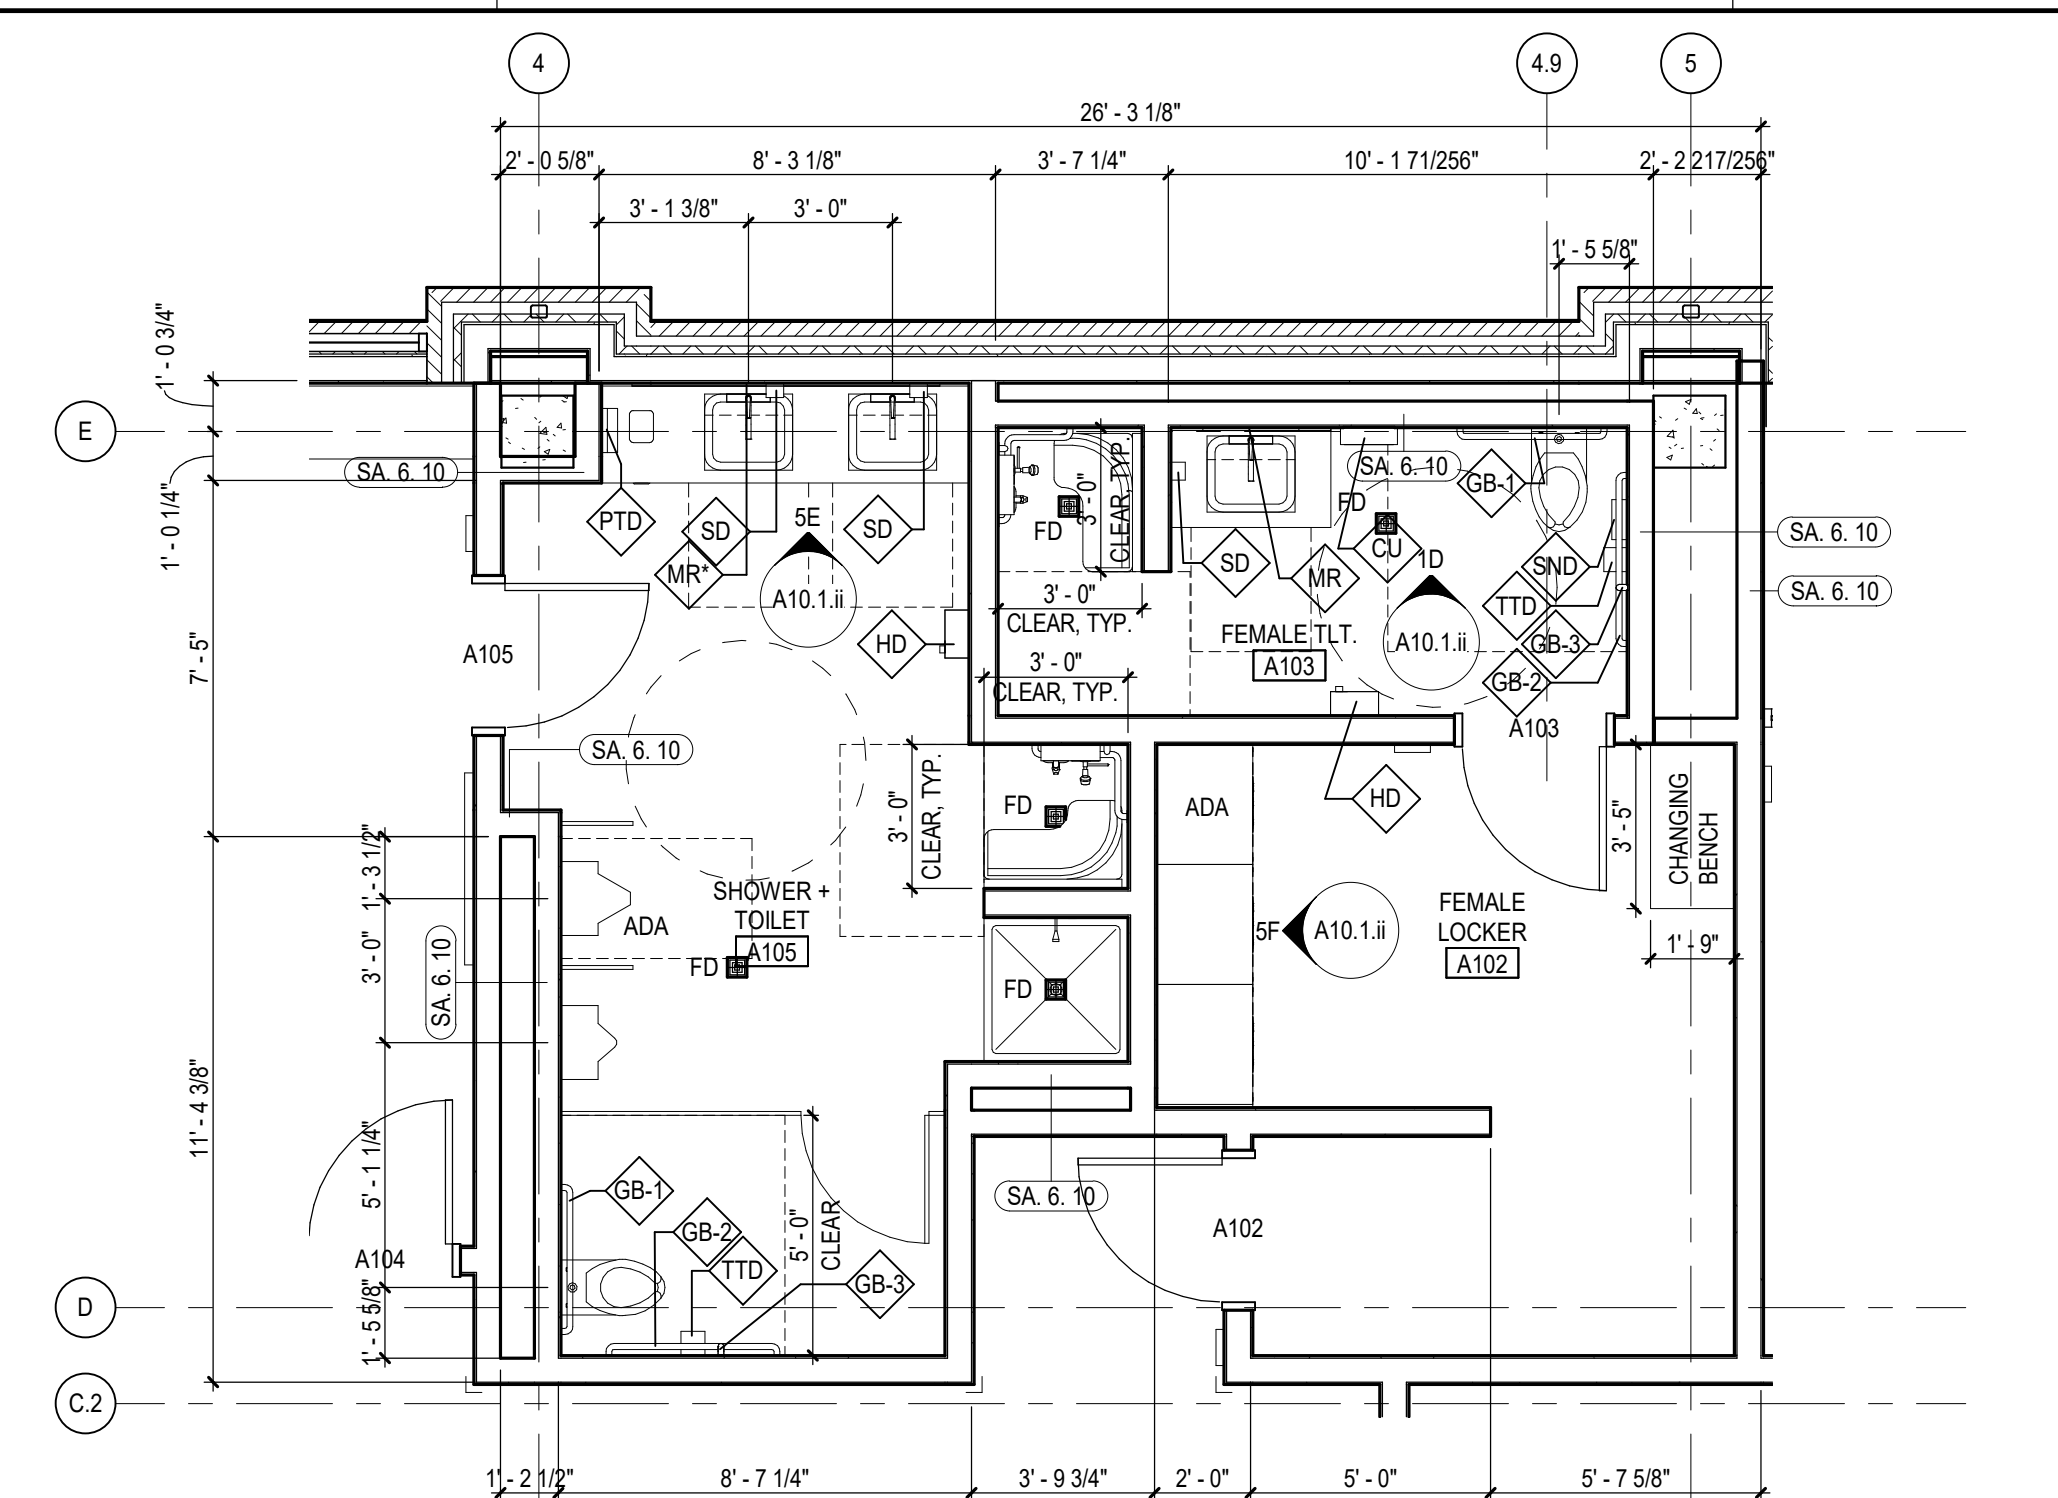
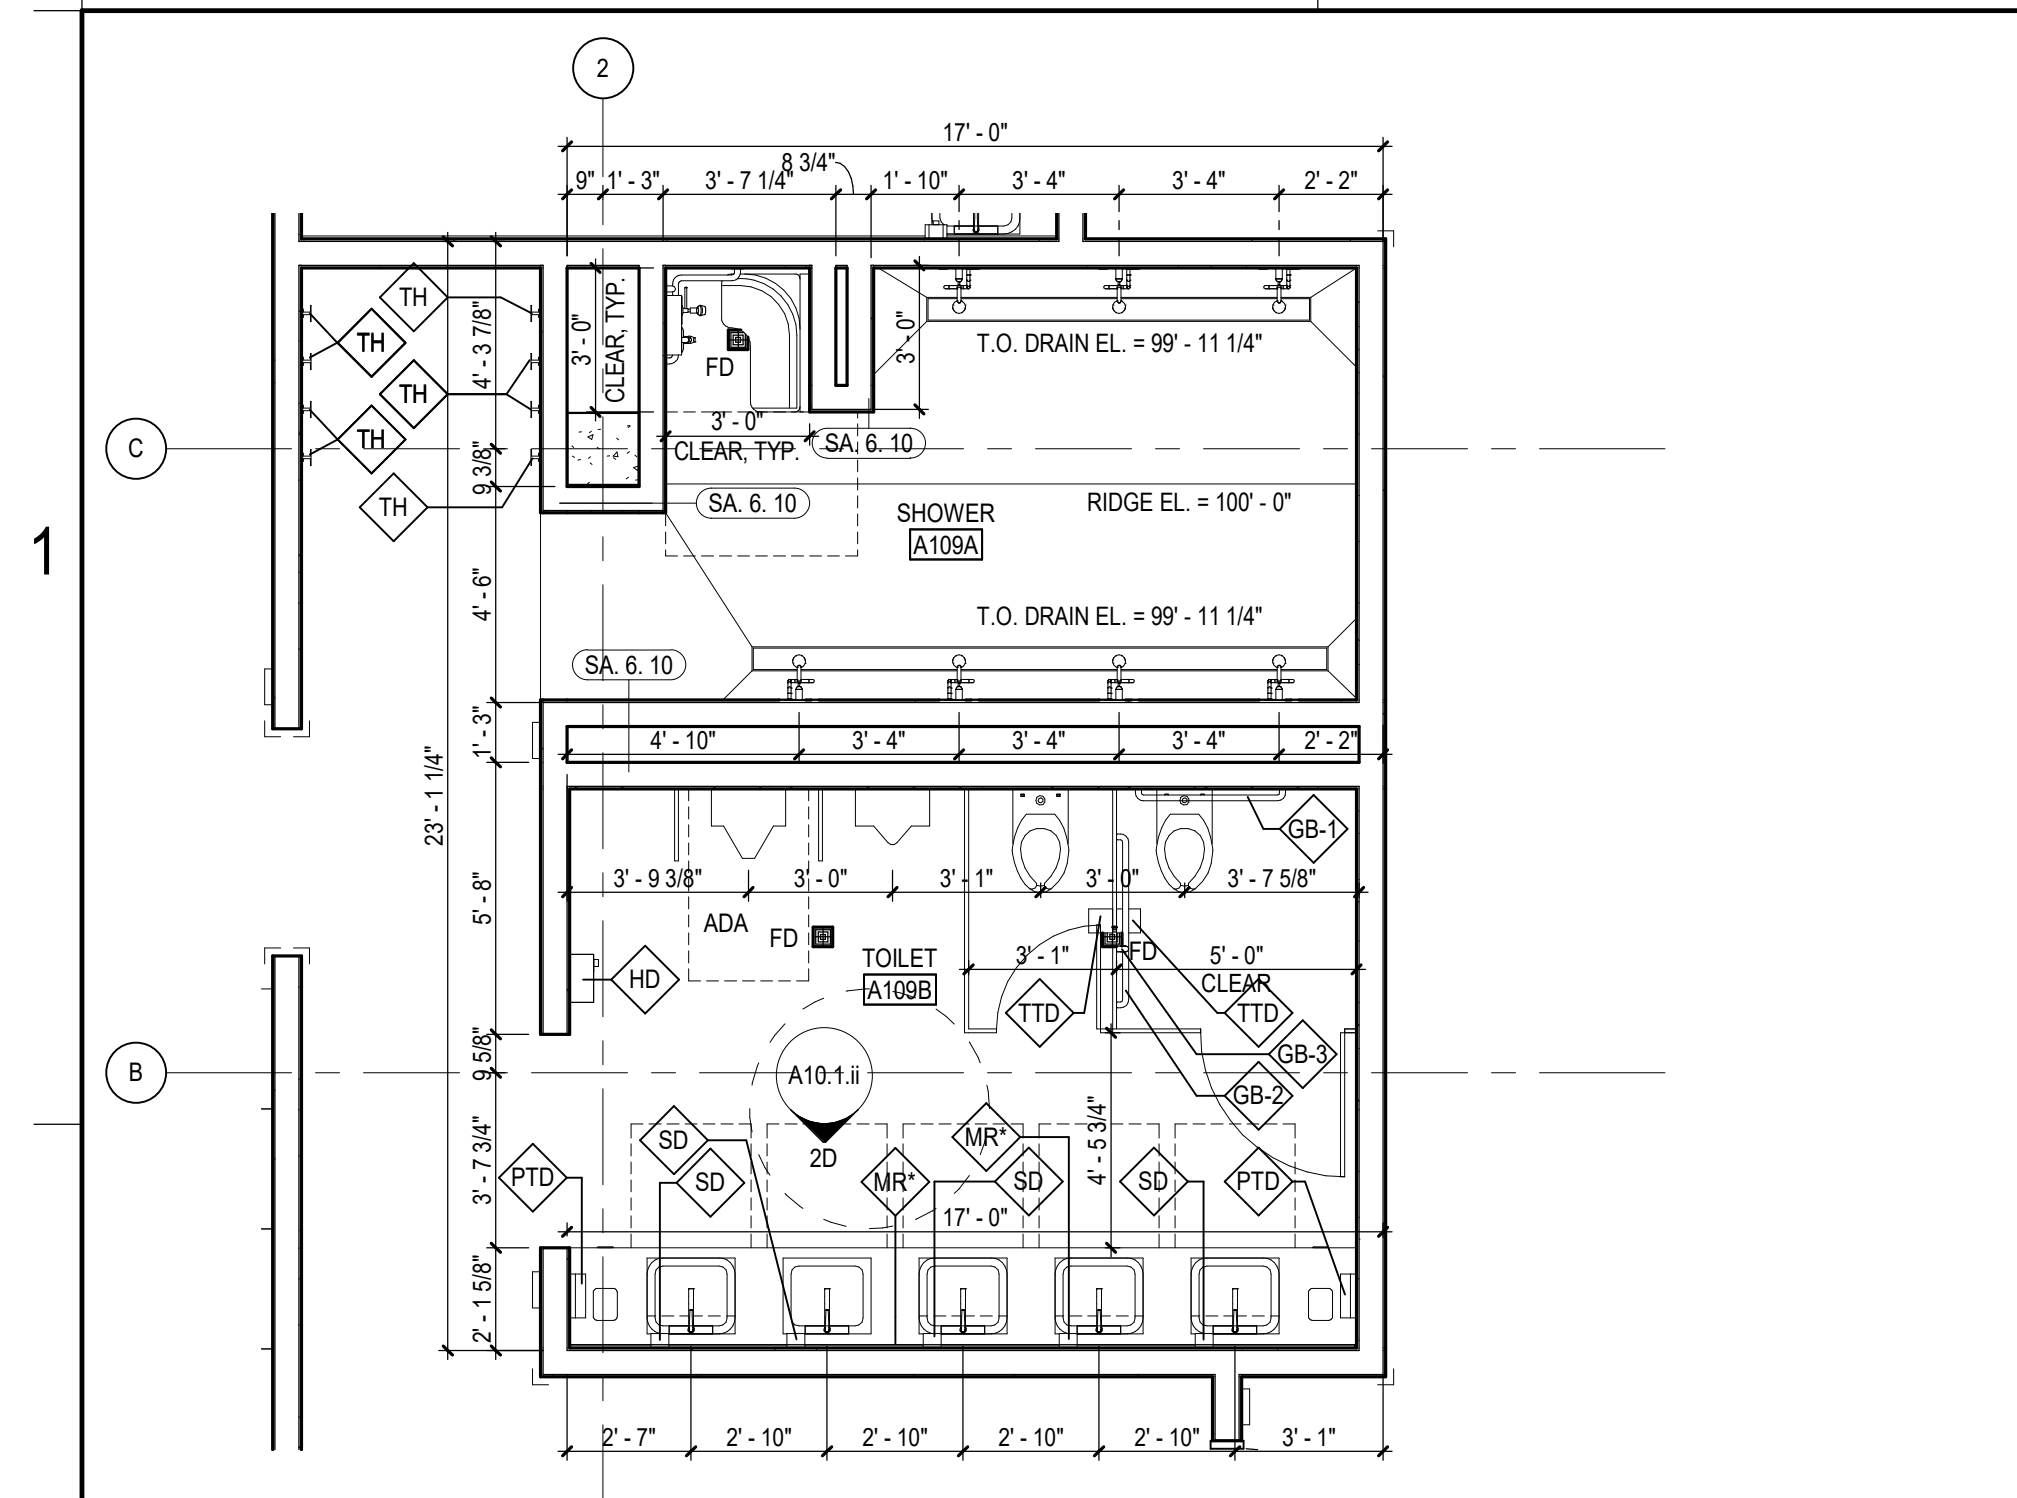


2A LEVEL 1 - CLUB HOUSE - ENLARGED RESTROOM PLAN
A2.1.i SCALE: 1/4" = 1'-0"

2B LEVEL 1 - CLUB HOUSE - ENLARGED RESTROOM PLAN
A2.1.i SCALE: 1/4" = 1'-0"

1D LEVEL 1 - CLUB HOUSE - ENLARGED RESTROOM PLAN
A2.1.i SCALE: 1/4" = 1'-0"

1F LEVEL 1 - WEIGHT ROOM - ENLARGED RESTROOM PLAN
A2.1.i SCALE: 1/4" = 1'-0"

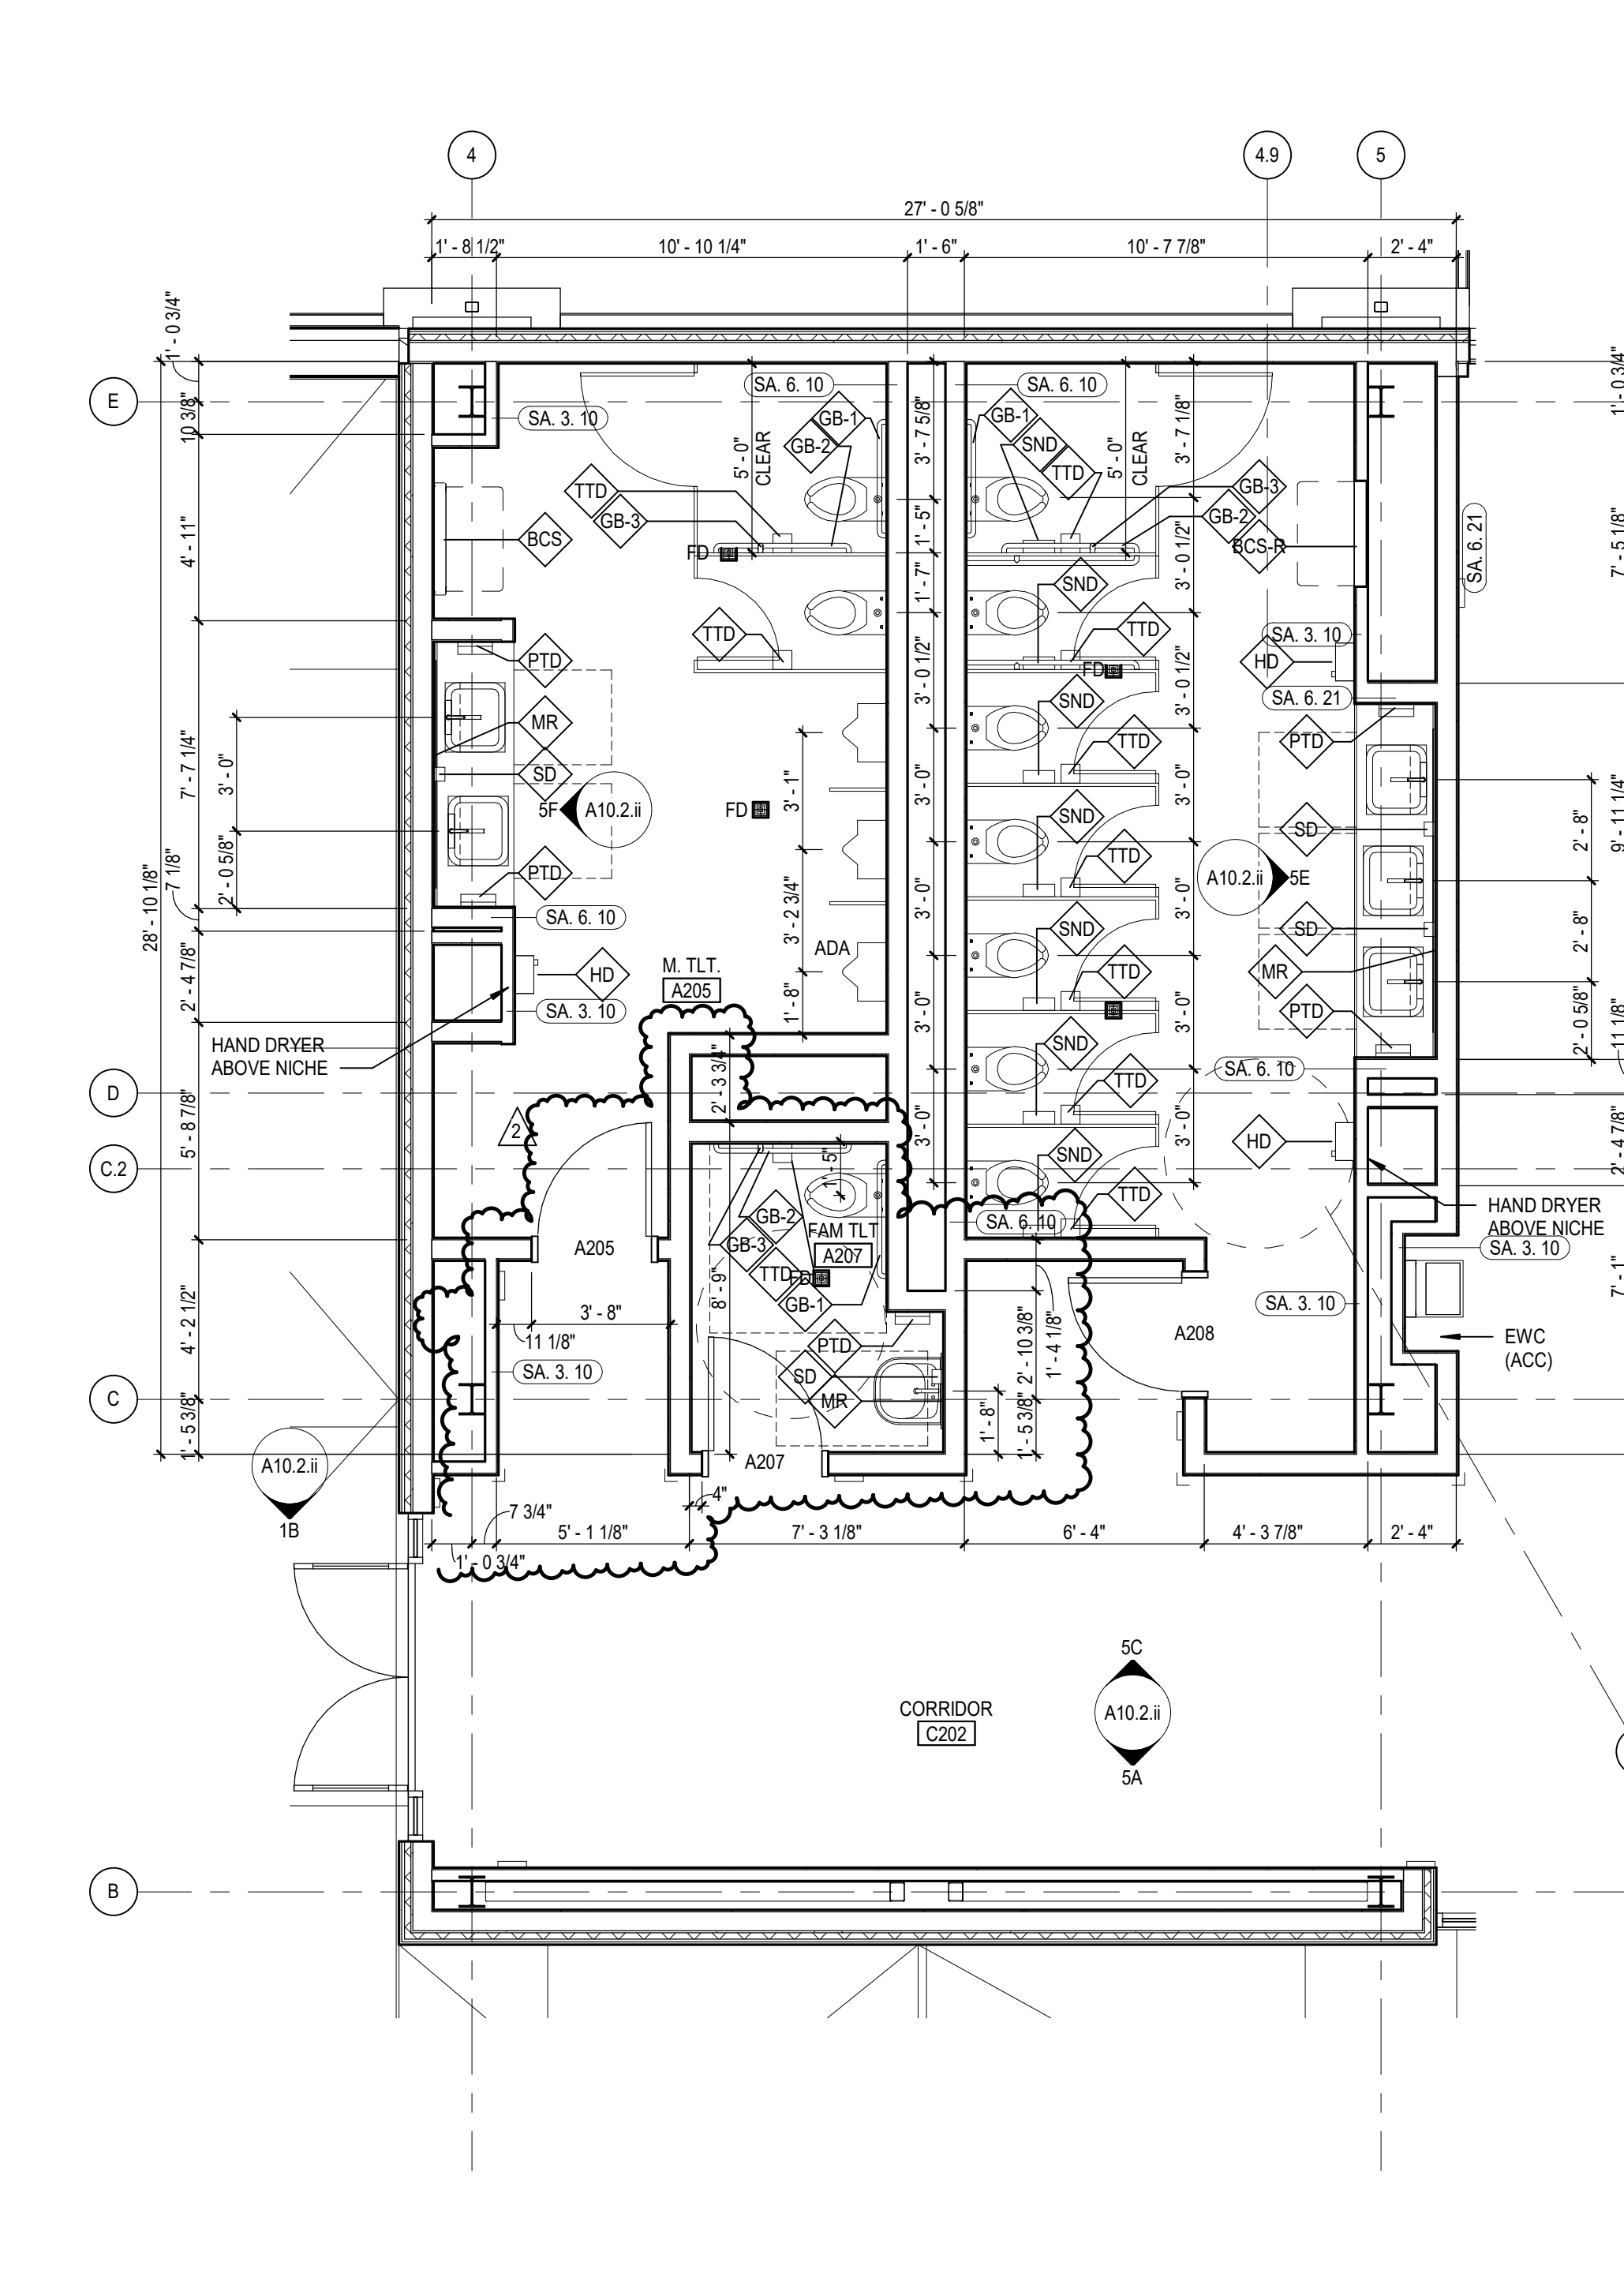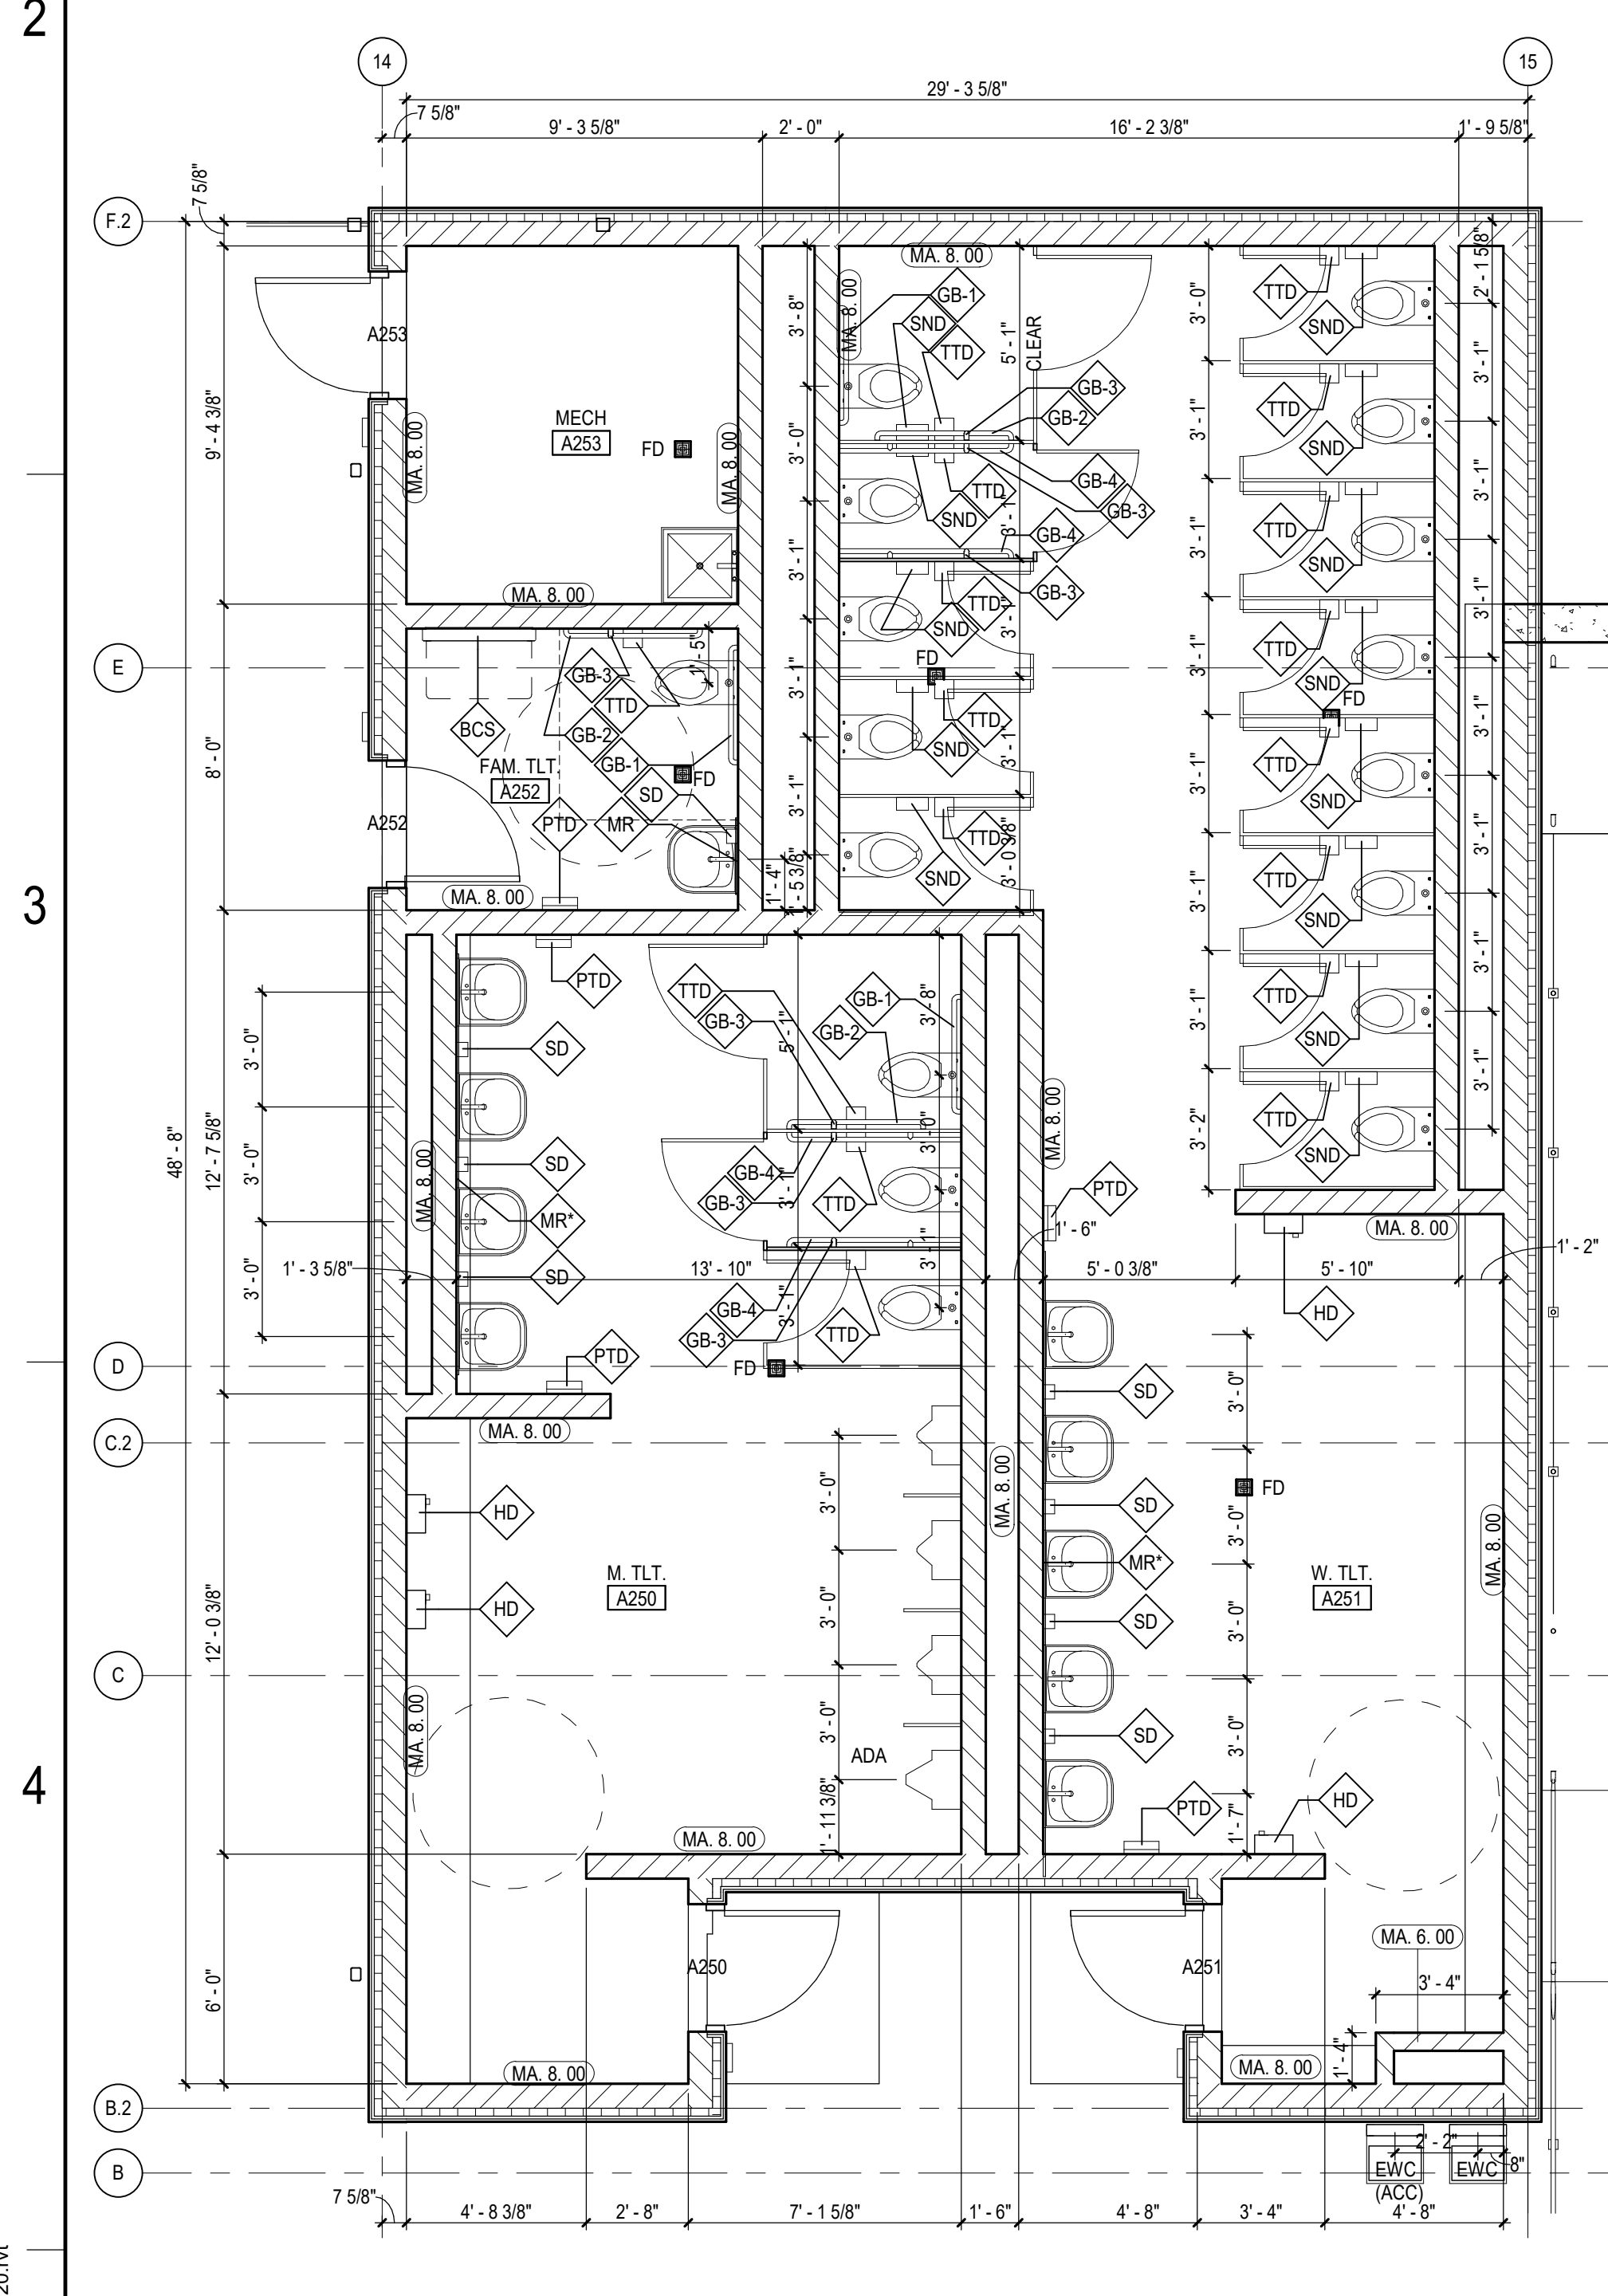

4A LEVEL 2 - RESTROOM BUILDING - ENLARGED PLAN
A2.1.i SCALE: 1/4" = 1'-0"

4C LEVEL 2 - CLUB LEVEL - ENLARGED PLAN
A2.1.i SCALE: 1/4" = 1'-0"


ADULT MOUNTING HEIGHTS	
	ANSI 117.1 2009 - 603.3
	ANSI 117.1 2009 - 602.4
	ANSI 117.1 2009 - 602.7
	ANSI 117.1 2009 - 605.2
	ANSI 117.1 2009 - 605.2
	ANSI 117.1 2009 - 308
	ANSI 117.1 2009 - 606.6
	ANSI 117.1 2009 - 606.1
	ANSI 117.1 2009 - 604.7
	ANSI 117.1 2009 - 606.1
	ANSI 117.1 2009 - 606.1
	ANSI 117.1 2009 - 604.5.1
	ANSI 117.1 2009 - 308
	ANSI 117.1 2009 - 308
	ANSI 117.1 2009 - 604.8
	ANSI 117.1 2009 - 604.8
	ANSI 117.1 2009 - 608.3.1
	ANSI 117.1 2009 - 308.2.2
	ANSI 117.1 2009 - 603.4
	ANSI 117.1 2009 - 603.4
	ANSI 117.1 2009 - 603.4

REFERENCE KEYNOTES

SHEET NOTES

GENERAL NOTES FOR ACCESSIBILITY

- 1 INFILL OR PATCH AND REPAIR CONCRETE SLAB AREA
 - 2 PATCH AND REPAIR WALL
 - 3 REFERENCE FINISH PLANS FOR CONCRETE JOINTING PATTERN
 - 4 FULLY-GROUT COLLAR JOINT.
- A. ACCESSIBLE URINAL SHALL PROVIDE CLEAR FLOOR SPACE PER ANSI 117.1 2009 - 605.3
 - B. ACCESSIBLE WATER CLOSETS SHALL PROVIDE CLEAR SPACE PER ANSI 117.1 2009 - 604.3
 - C. ACCESSIBLE LAVATORIES AND SINKS SHALL PROVIDE CLEAR SPACE PER ANSI 117.1 2009 - 606.2
 - D. ACCESSIBLE TOILET ROOMS SHALL PROVIDE A TURNING SPACE OF 60 INCHES IN DIAMETER PER ANSI 117.1 2009 - 304.3.1
 - E. ACCESSIBLE WATER FOUNTAINS SHALL PROVIDE CLEAR FLOOR SPACE PER ANSI 117.1 2009 - 602.2
 - F. ACCESSIBLE TOILET PARTITIONS SHALL COMPLY WITH ANSI 117.1 2009 - 604.9
 - G. EXPOSED PIPES AND SURFACES UNDER LAVATORIES AND SINKS SHALL BE INSULATED PER ANSI 117.1 2009 - 606.6
 - H. HAND OPERATED FLUSH CONTROLS SHALL BE INSTALLED ON THE OPEN SIDE OF THE WATER CLOSET.
 - I. WHERE THE TOILET PAPER DISPENSER IS LOCATED BELOW THE GRAB BAR, THE OUTLET OF THE DISPENSER SHALL BE LOCATED 24" MINIMUM AND 42" MAXIMUM FROM REAR WALL PER ANSI 117.1 2009 - 604.6

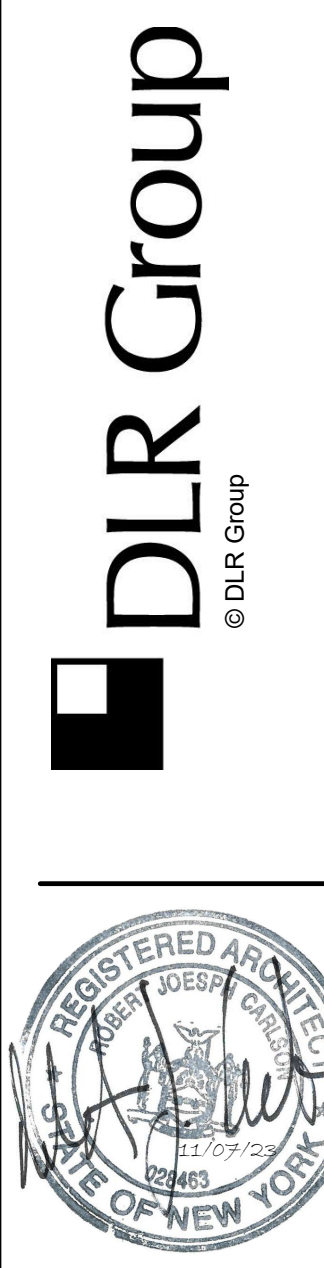

REBID DUTCHESS STADIUM NEW LEFT FIELD CLUBHOUSE, SEATING BOWL, & RESTROOM BUILDING
OWNER: DUTCHESS COUNTY, 22 MARKET STREET Poughkeepsie, NY 12601
1500 ROUTE 90, FISHKILL, NY 12901

BID SET
11.04.22
REVISIONS
1 CONSTRUCTION DOCS 03.05.23
2 ASI 911 11.07.23

57-21113-00
ENLARGED FLOOR PLANS

A2.1.ii

BM 360/02-21113-00_Dutchess Stadium Ph II 57-21113-00_Dutchess Stadium Ph II AR 2020.rvt
11/07/2023 3:55:26 PM

A

B

C

D

E

F



1

2



3

4

5

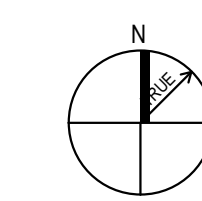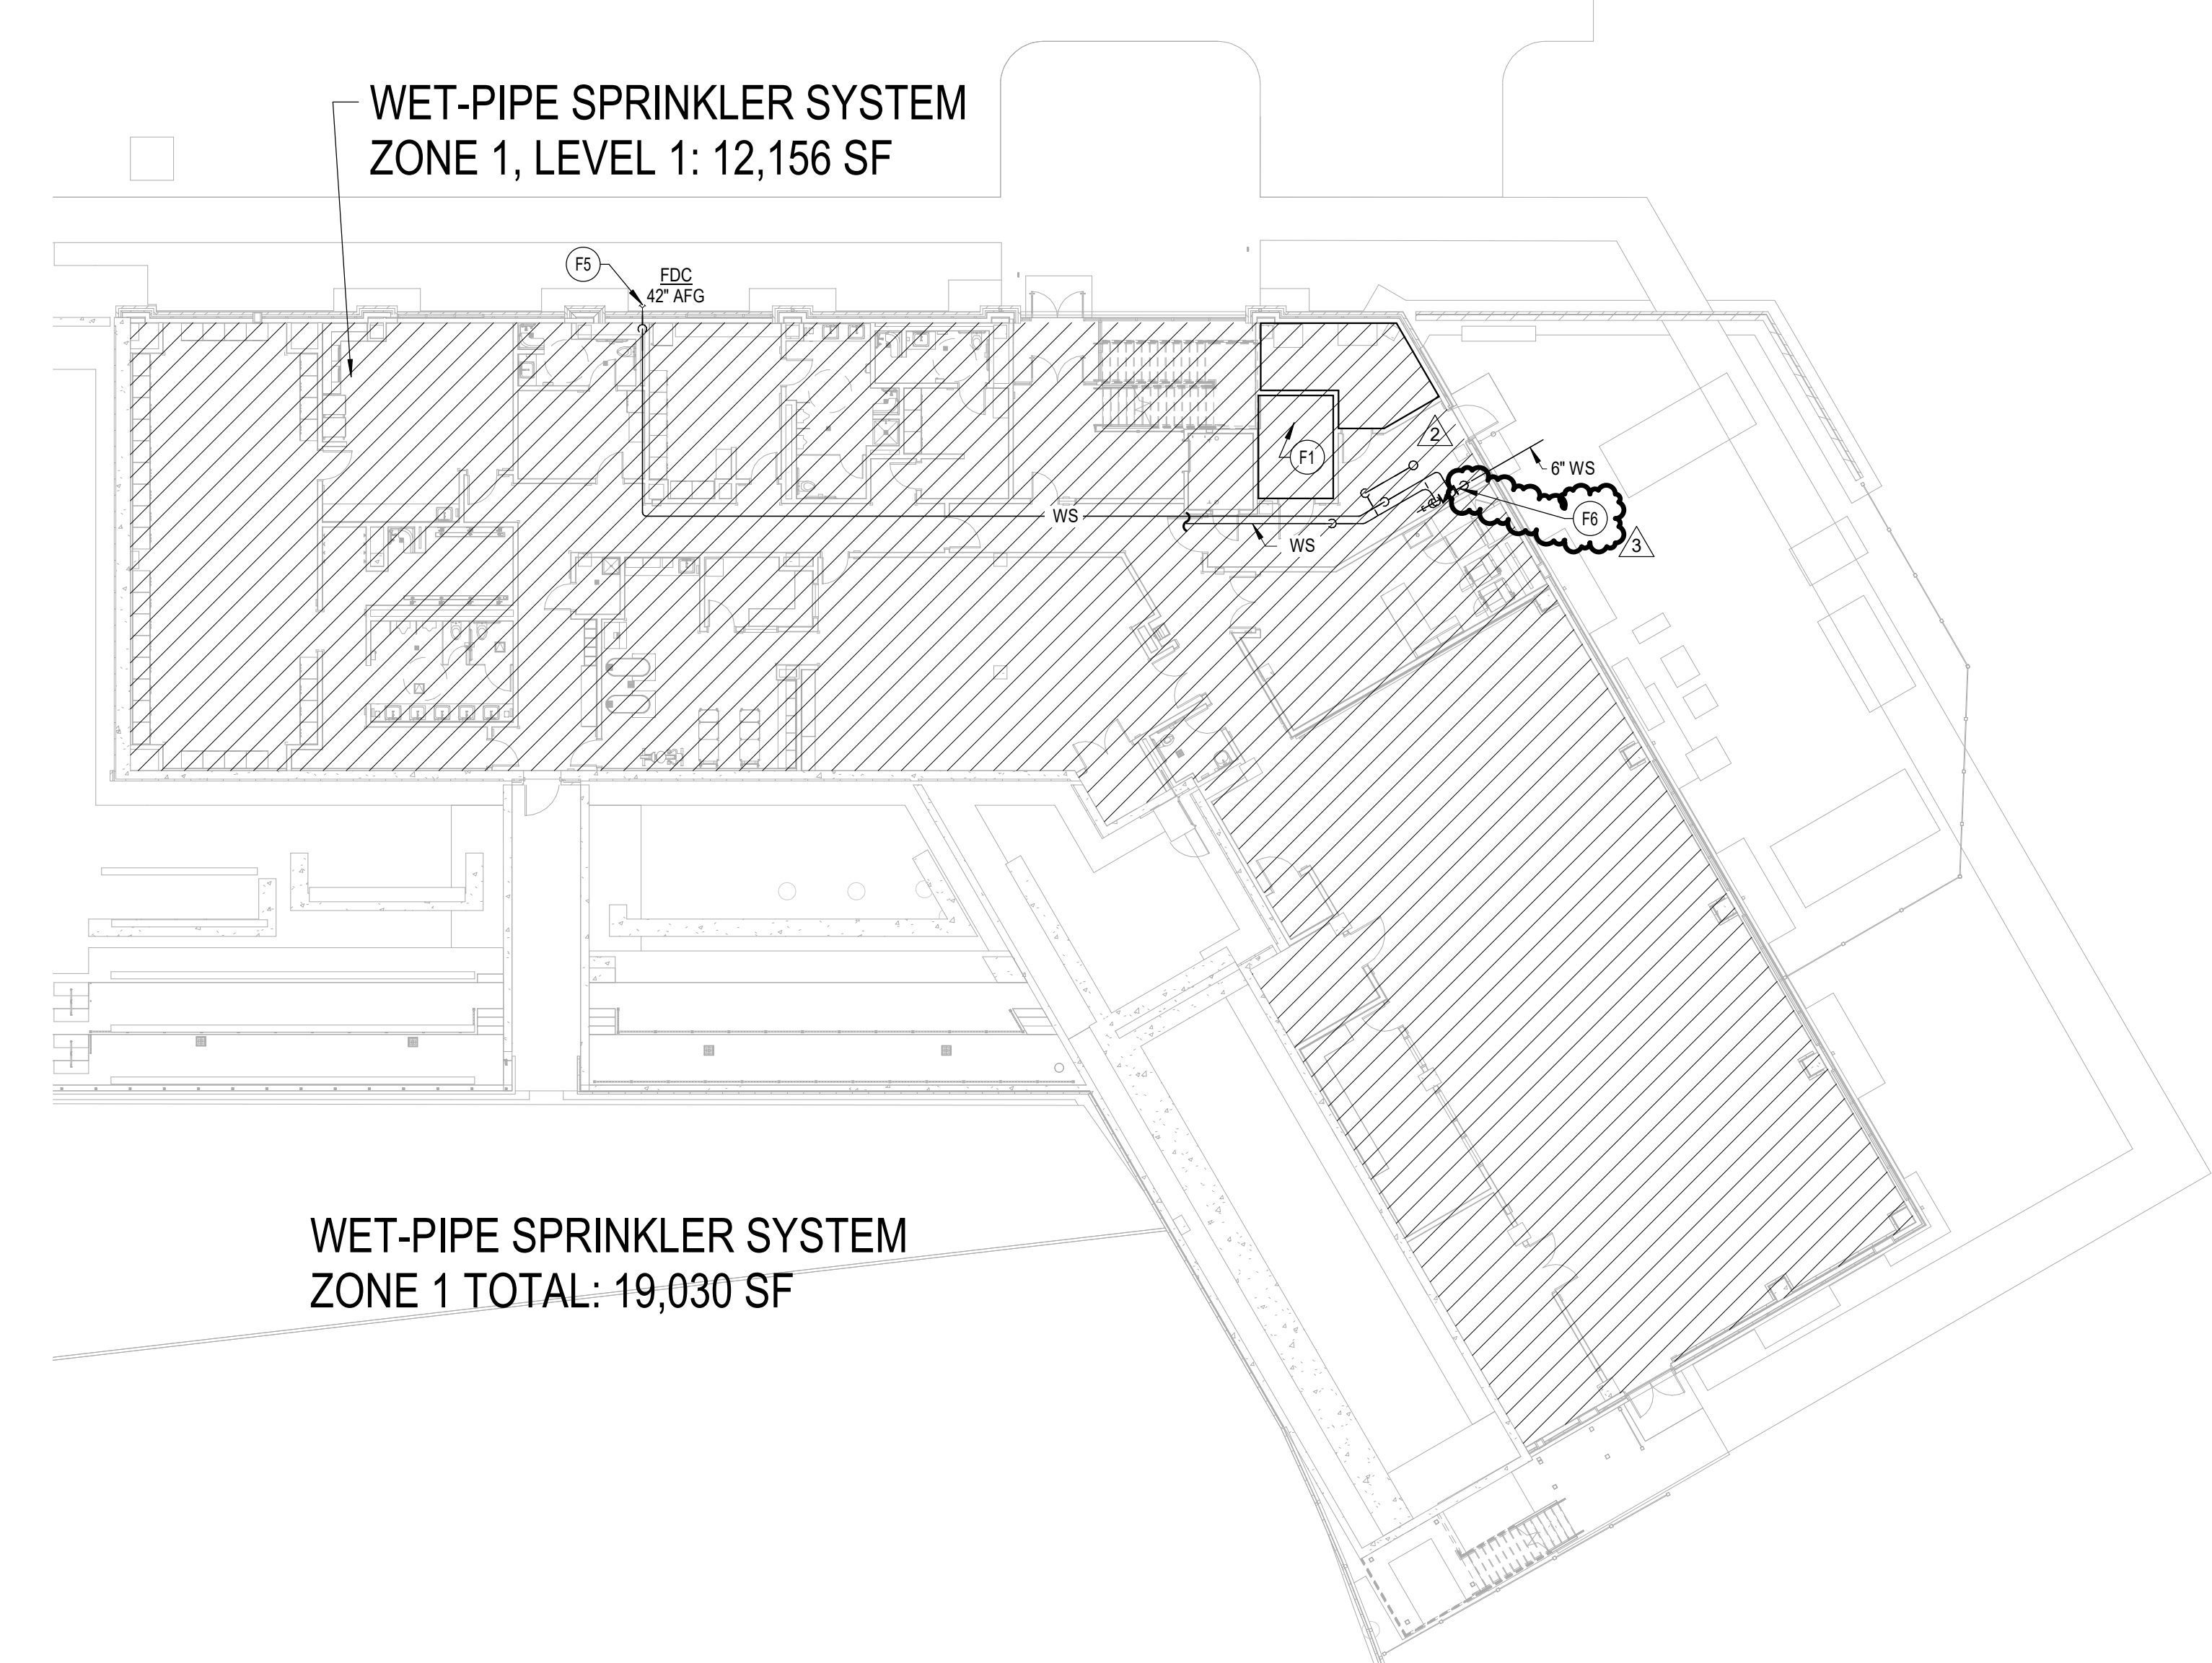

FIRE PROTECTION PLAN - AREA A - LEVEL 1 - BASE BID
SCALE: 1/16" = 1'-0"

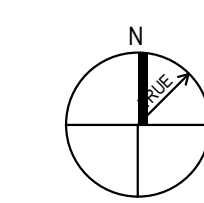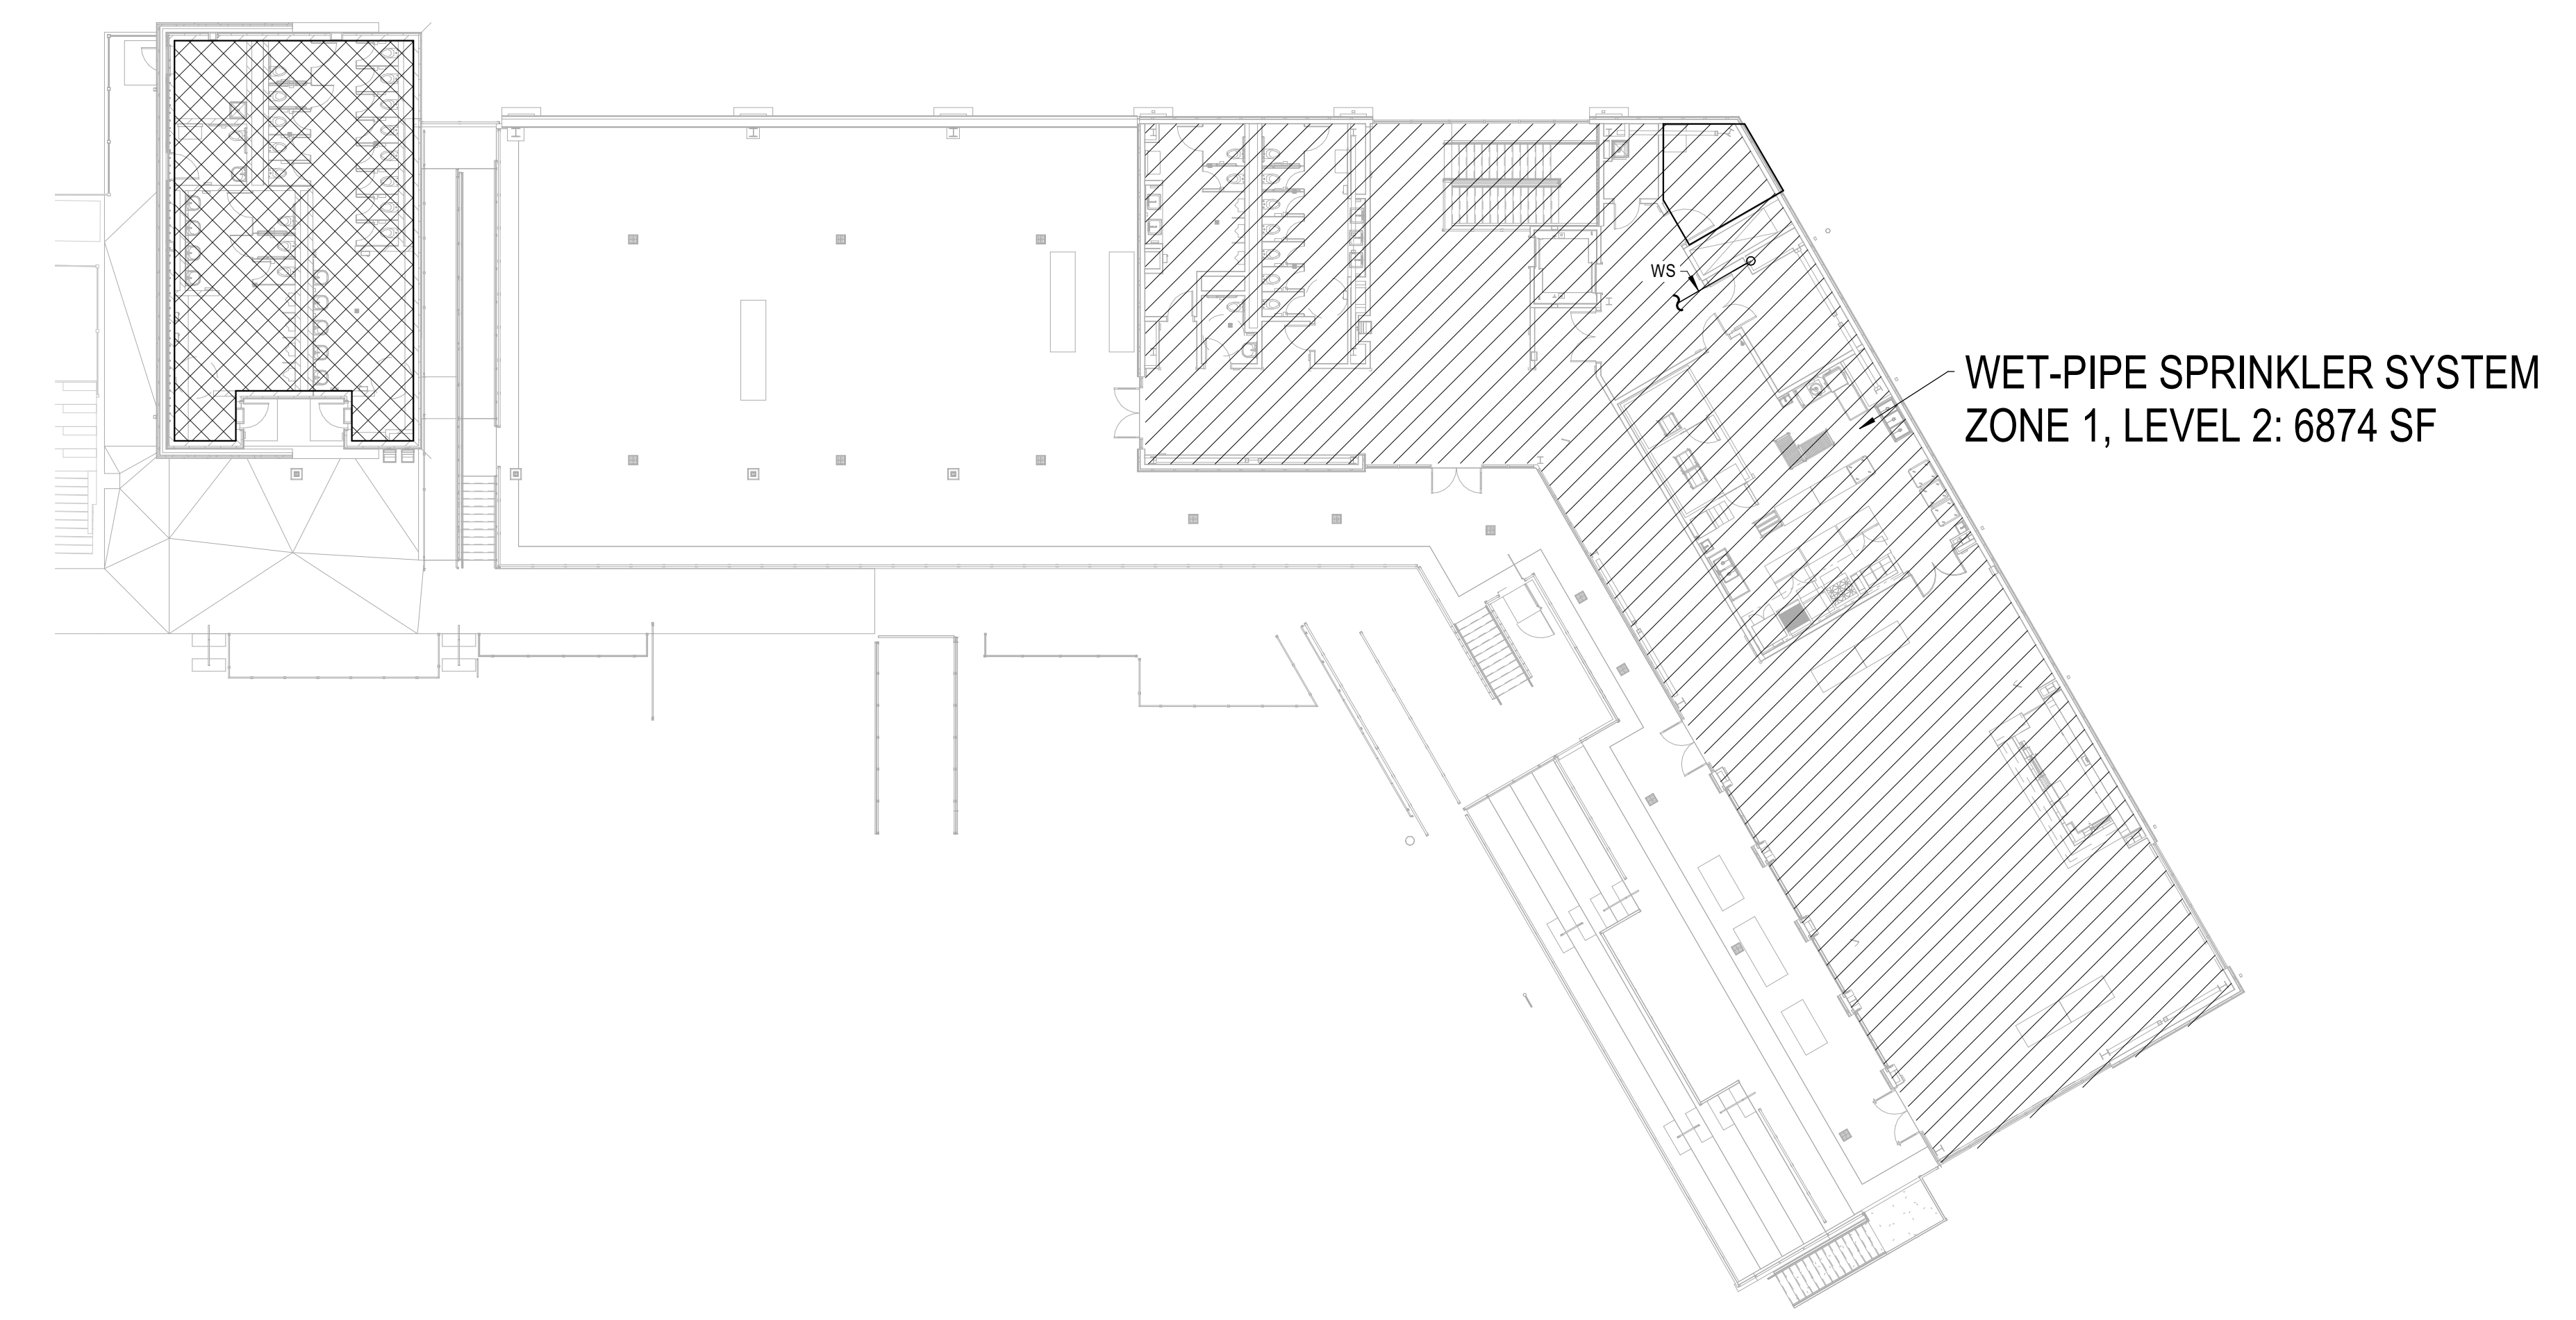

FIRE PROTECTION PLAN - AREA A - LEVEL 2 - BASE BID
SCALE: 1/16" = 1'-0"


GENERAL NOTES

A FOR SYMBOLS AND ABBREVIATIONS SEE DRAWING FPO.1.1.

SHEET NOTES

- F1 ELECTRICAL ROOM. DO NOT ROUTE PIPING ABOVE THIS ROOM. USE SIDEWALL SPRINKLER HEADS.
- F5 COORDINATE FIRE DEPARTMENT CONNECTION LOCATION WITH FIRE CHIEF OF THE CHELSEA FIRE DISTRICT.
- F6 FIRE PROTECTION BACKFLOW PREVENTION DEVICE DESIGNED BY FIRE PROTECTION ENGINEER AND FIRE PROTECTION CONTRACTOR.

KEY PLAN

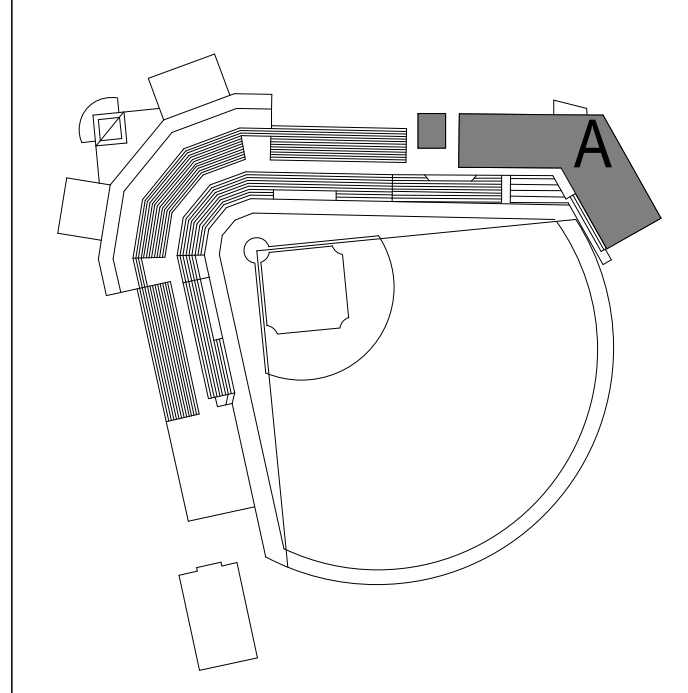

REBID DUTCHESS STADIUM NEW LEFT FIELD CLUBHOUSE, SEATING BOWL, & RESTROOM BUILDING
OWNER: DUTCHESS COUNTY, 22 MARKET STREET POUGHKEEPSIE, NY 12601
1500 ROUTE 90, FISHKILL, NY 12590

BID SET
11.04.22

REVISIONS

1	CONSTRUCTION DOCS	03.06.23
2	PKG 2 - ASB UP	08.07.23
3	PKG 2 - ASB 11	11.07.23

57-21113-00

FIRE PROTECTION PLANS - AREA A


FP1.1A.ii

B:\650\57-21113-00_Dutchess Stadium\PH\57-21113-00_Dutchess Stadium_Plan_MEP_2020.rvt
 11/7/2023 12:21:16 PM

ABBREVIATIONS

Table with 2 columns: Abbreviation, Description. Includes Plumbing, Mechanical, and Electrical symbols.

Table with 2 columns: Abbreviation, Description. Includes Plumbing, Mechanical, and Electrical symbols.

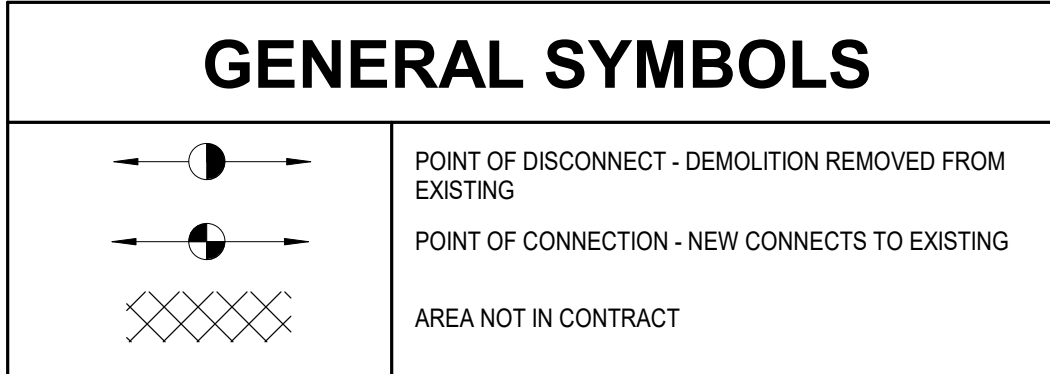


PLUMBING GENERAL NOTES:

- 1. DRAWINGS ARE DIAGRAMMATIC ONLY AND REPRESENT THE GENERAL SCOPE OF THE WORK... 2. ALL WORK SHALL BE FURNISHED AND INSTALLED IN ACCORDANCE WITH THE 2020 PLUMBING CODE OF NEW YORK STATE... 3. REVIEW THE ENTIRE PROJECT DRAWING SET AND COORDINATE LOCATION OF ALL PIPING WITH MECHANICAL AND ELECTRICAL CONTRACTORS BEFORE HANGING ANY PIPE...

PLUMBING SYMBOLS

Table with 3 columns: SCHEMATIC, 3D, DESCRIPTION. Lists various plumbing symbols for water, gas, and waste lines.


PIPING ANNOTATIONS

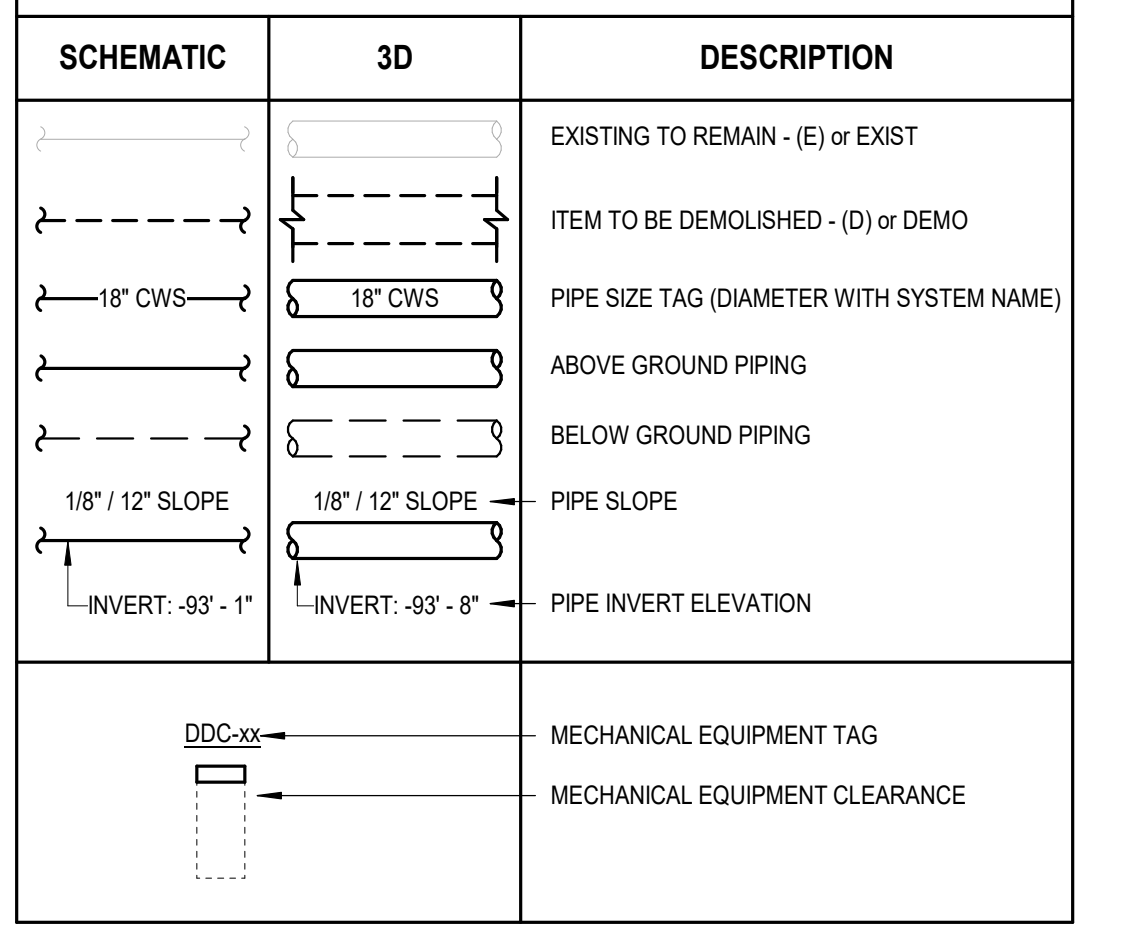


PIPING VALVES AND FITTINGS

Table with 3 columns: SCHEMATIC, 3D, DESCRIPTION. Lists various piping valves and fittings like pipe drop, pipe rise, tee, reducer, and valves.

SHEET INDEX

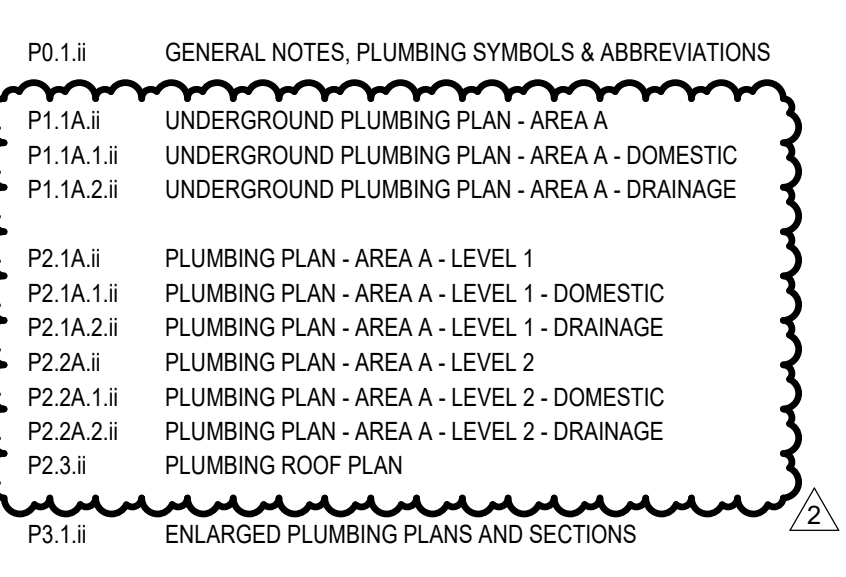


NOTE ALL NOTES ON THIS SHEET ARE APPLICABLE TO ALL OTHER SHEETS IN THIS SET.

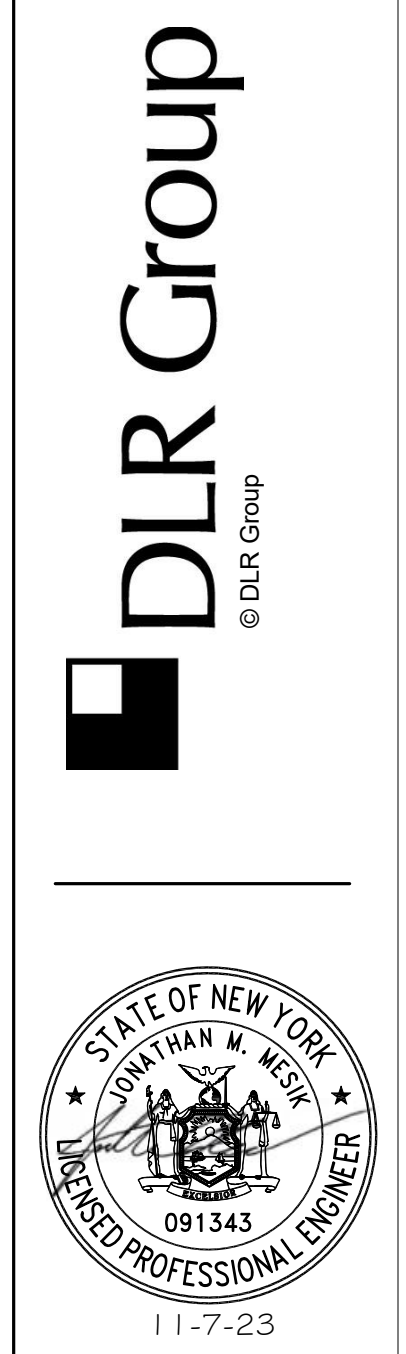

REBID DUTCHESS STADIUM NEW LEFT FIELD CLUBHOUSE, SEATING BOWL, & RESTROOM BUILDING. OWNER: DUTCHESS COUNTY, 22 MARKET STREET POUGHKEEPSIE, NY 12601. 1500 ROUTE 90, FISHKILL, NY 12530.

BID SET 11.04.22 REVISIONS 1 CONSTRUCTION DOCS 03.08.23 2 PKG 2 - ASI 11.09.23

57-2113-00 GENERAL NOTES, PLUMBING SYMBOLS & ABBREVIATIONS

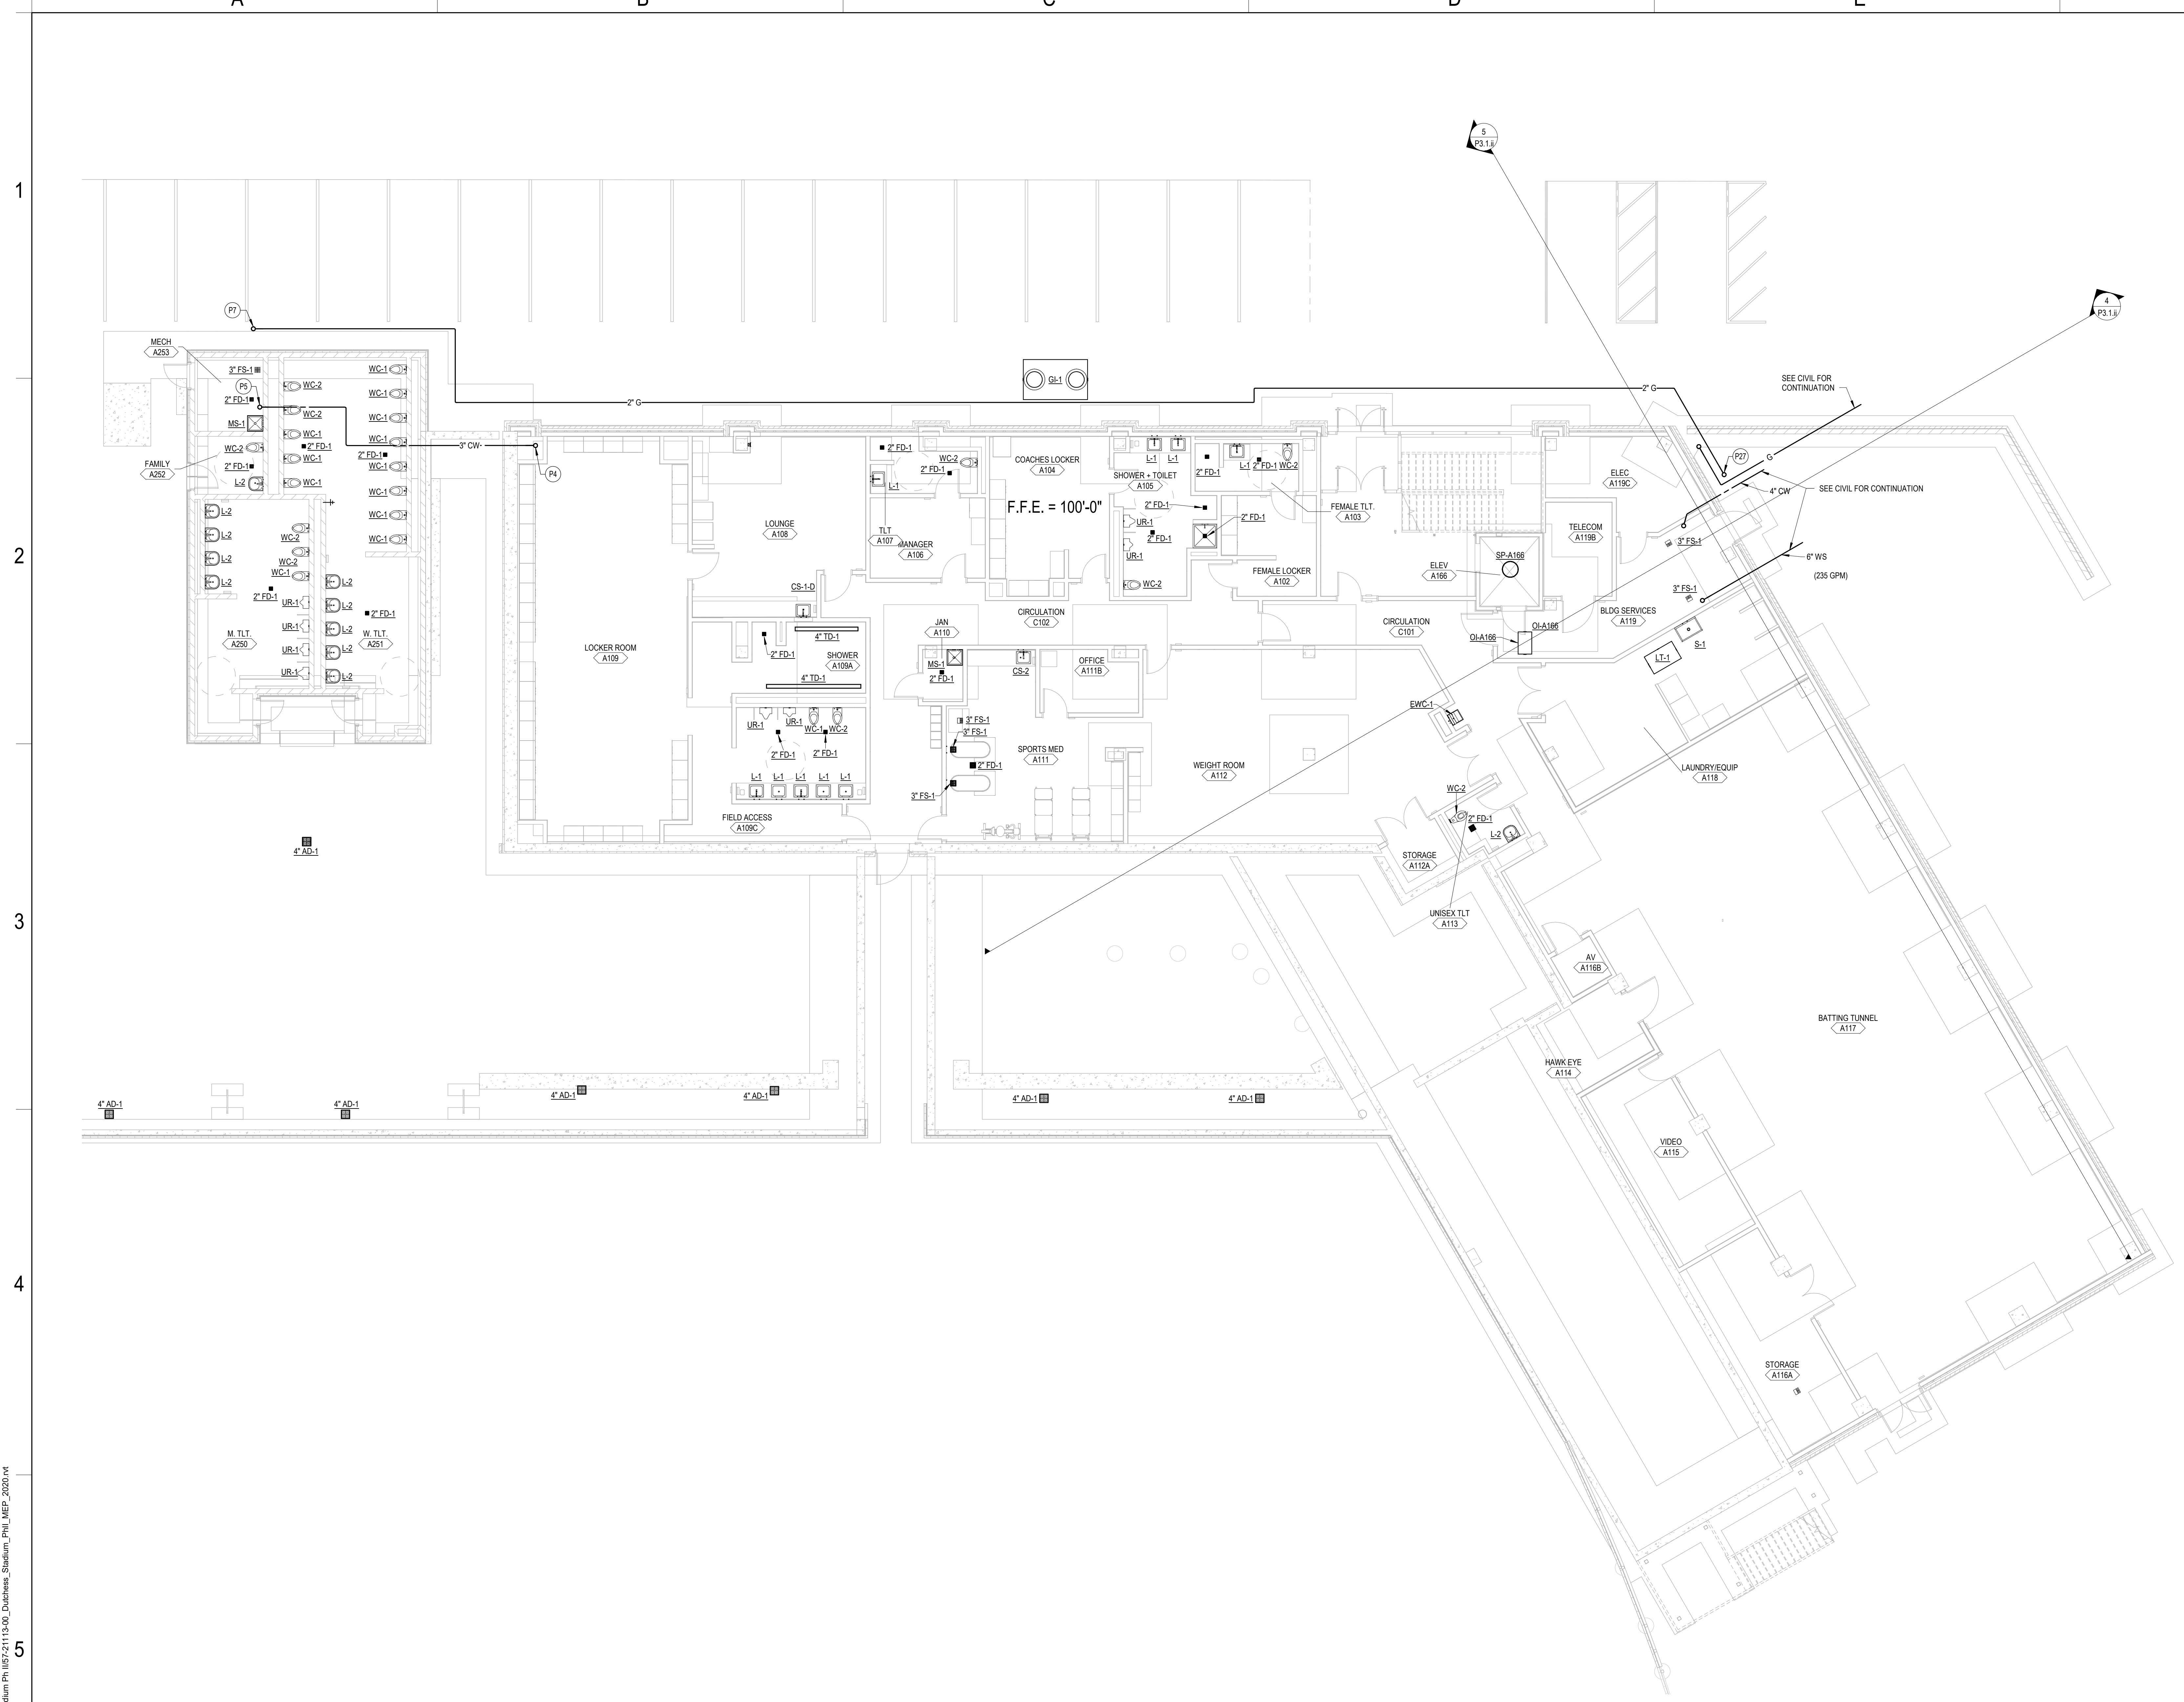


GENERAL NOTES

- A. FOR SYMBOLS AND ABBREVIATIONS SEE DRAWING P0.1.
- B. PIPING TESTS:
1. FILL DOMESTIC WATER PIPING. CHECK COMPONENTS TO DETERMINE THAT THEY ARE NOT AIR BOUND AND THAT PIPING IS FULL OF WATER.
 2. TEST FOR LEAKS AND DEFECTS IN NEW PIPING AND PARTS OF EXISTING PIPING THAT HAVE BEEN ALTERED, EXTENDED, OR REPAIRED. IF TESTING IS PERFORMED IN SEGMENTS, SUBMIT A SEPARATE REPORT FOR EACH TEST. COMPLETE WITH DIAGRAM OF PORTION OF PIPING TESTED.
 3. LEAVE NEW, ALTERED, EXTENDED, OR REPLACED DOMESTIC WATER PIPING UNCOVERED AND UNCONCEALED UNTIL IT HAS BEEN TESTED AND APPROVED. EXPOSE WORK THAT WAS COVERED OR CONCEALED BEFORE IT WAS TESTED.
 4. CAP AND SUBJECT PIPING TO STATIC WATER PRESSURE OF 50 PSIG (345 KPA) ABOVE OPERATING PRESSURE. WITHOUT EXCEEDING PRESSURE RATING OF PIPING SYSTEM MATERIALS. ISOLATE TEST SOURCE AND ALLOW IT TO STAND FOR FOUR HOURS. LEAKS AND LOSS IN TEST PRESSURE CONSTITUTE DEFECTS THAT MUST BE REPAIRED.
 5. REPAIR LEAKS AND DEFECTS WITH NEW MATERIALS, AND RETEST PIPING OR PORTION THEREOF UNTIL SATISFACTORY RESULTS ARE OBTAINED.
 6. PREPARE REPORTS FOR TESTS AND FOR CORRECTIVE ACTION REQUIRED.
- C. CLEAN AND DISINFECT POTABLE DOMESTIC WATER PIPING AS FOLLOWS:
1. PURGE NEW PIPING AND PARTS OF EXISTING PIPING THAT HAVE BEEN ALTERED, EXTENDED, OR REPAIRED BEFORE USING.
 2. USE PURGING AND DISINFECTING PROCEDURES PRESCRIBED BY AUTHORITIES HAVING JURISDICTION. IF METHODS ARE NOT PRESCRIBED, USE PROCEDURES DESCRIBED IN EITHER AWWA C651 OR AWWA C652 OR FOLLOW PROCEDURES DESCRIBED BELOW:
 - a. FLUSH PIPING SYSTEM WITH CLEAN, POTABLE WATER UNTIL DIRTY WATER DOES NOT APPEAR AT OUTLETS.
 - b. FILL AND ISOLATE SYSTEM ACCORDING TO EITHER OF THE FOLLOWING:
 - FILL SYSTEM OR PART THEREOF WITH WATER/CHLORINE SOLUTION WITH AT LEAST 50 PPM (50 MG/L) OF CHLORINE. ISOLATE WITH VALVES AND ALLOW TO STAND FOR 24 HOURS.
 - FILL SYSTEM OR PART THEREOF WITH WATER/CHLORINE SOLUTION WITH AT LEAST 200 PPM (200 MG/L) OF CHLORINE. ISOLATE AND ALLOW TO STAND FOR THREE HOURS.
 - c. FLUSH SYSTEM WITH CLEAN, POTABLE WATER UNTIL NO CHLORINE IS IN WATER COMING FROM SYSTEM AFTER THE STANDING TIME.
 - d. REPEAT PROCEDURES IF BIOLOGICAL EXAMINATION SHOWS CONTAMINATION.
 3. SUBMIT WATER SAMPLES IN STERILE BOTTLES TO AUTHORITIES HAVING JURISDICTION.
- D. CLEAN NON-POTABLE DOMESTIC WATER PIPING AS FOLLOWS:
1. PURGE NEW PIPING AND PARTS OF EXISTING PIPING THAT HAVE BEEN ALTERED, EXTENDED, OR REPAIRED BEFORE USING.
 2. USE PURGING PROCEDURES PRESCRIBED BY AUTHORITIES HAVING JURISDICTION OR, IF METHODS ARE NOT PRESCRIBED, FOLLOW PROCEDURES DESCRIBED BELOW:
 - a. FLUSH PIPING SYSTEM WITH CLEAN, POTABLE WATER UNTIL DIRTY WATER DOES NOT APPEAR AT OUTLETS.
 - b. SUBMIT WATER SAMPLES IN STERILE BOTTLES TO AUTHORITIES HAVING JURISDICTION. REPEAT PROCEDURES IF BIOLOGICAL EXAMINATION SHOWS CONTAMINATION.
- E. PREPARE AND SUBMIT REPORTS OF PURGING AND DISINFECTING ACTIVITIES. INCLUDE COPIES OF WATER-SAMPLE APPROVALS FROM AUTHORITIES HAVING JURISDICTION.
- F. CLEAN INTERIOR OF DOMESTIC WATER PIPING SYSTEM. REMOVE DIRT AND DEBRIS AS WORK PROGRESSES.

SHEET NOTES

- P4 DOMESTIC COLD WATER DOWN FROM ABOVE SLAB. SEE P2.1A.II FOR CONTINUATION.
- P5 DOMESTIC COLD WATER UP TO ABOVE SLAB. SEE P2.2A.II FOR CONTINUATION.
- P7 NATURAL GAS UP TO ABOVE GRADE AND LEVEL ABOVE. SEE P2.2A.II FOR CONTINUATION.
- P27 2" GAS PIPING DOWN FROM ABOVE. SEE P2.1A.II FOR CONTINUATION.

KEY PLAN

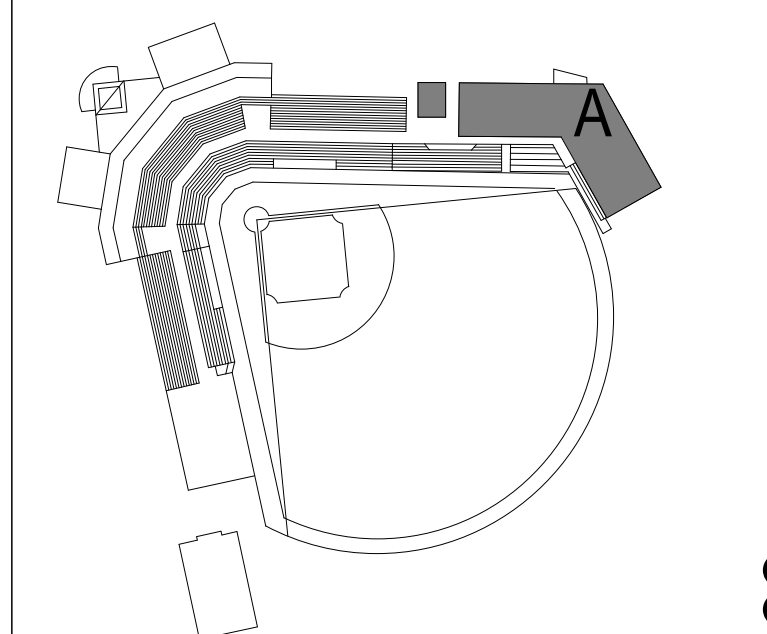

DLR Group
© DLR Group

REBID DUTCHESS STADIUM NEW LEFT FIELD CLUBHOUSE, SEATING BOWL, & RESTROOM BUILDING
OWNER: DUTCHESS COUNTY, 22 MARKET STREET Poughkeepsie, NY 12601
1500 ROUTE 9D, FISHKILL, NY 12530

BID SET
11.04.22

REVISIONS


1	PKG 2 - ASI 001	04.07.23
2	PKG 2 - ASI 09	09.15.23
3	PKG 2 - ASI 11	11.09.23

57-21113-00
UNDERGROUND PLUMBING PLAN - AREA A - DOMESTIC

P1.1A.1.ii

B:\600\57-21113-00_Dutchess Stadium\PH\11572-21113-00_Dutchess Stadium_P11_MEP_2020.rvt
11/17/2023 12:22:13 PM

UNDERGROUND PLUMBING PLAN - AREA A - DOMESTIC
SCALE: 1/8" = 1'-0"

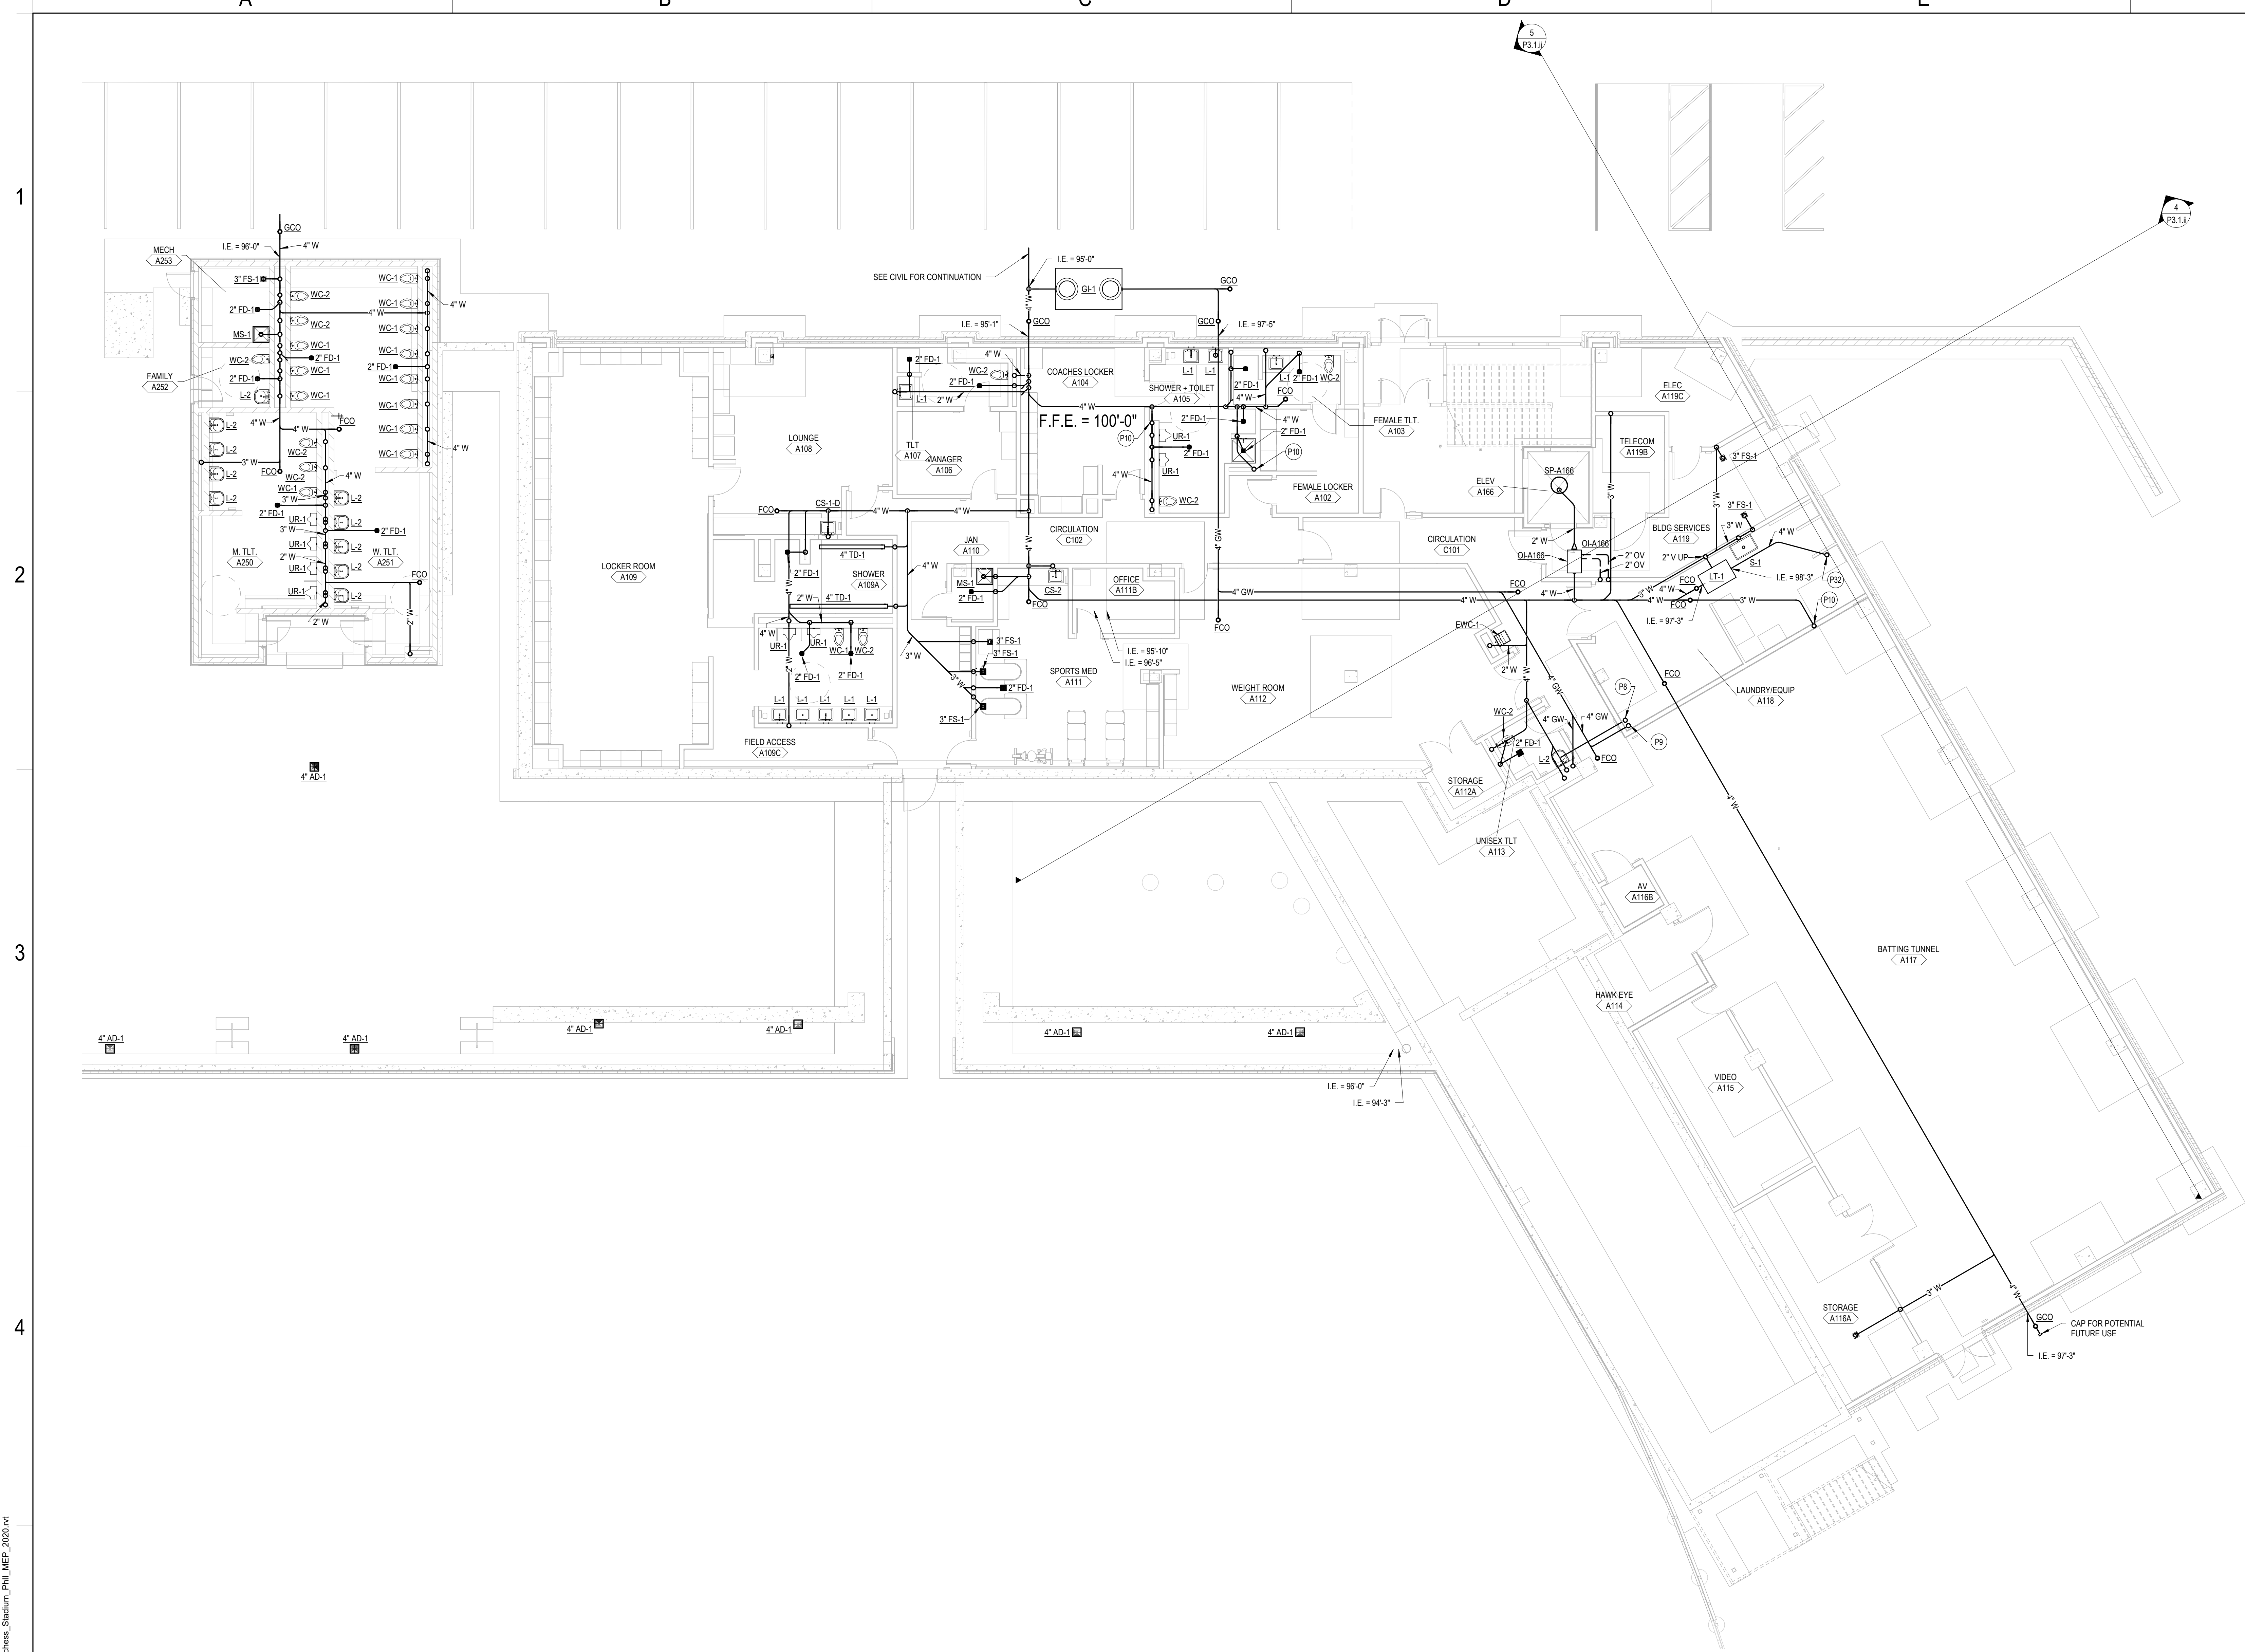


GENERAL NOTES

- A. FOR SYMBOLS AND ABBREVIATIONS SEE DRAWING P0.1
- B. TEST SANITARY DRAINAGE AND VENT PIPING ACCORDING TO PROCEDURES OF AUTHORITIES HAVING JURISDICTION OR, IN ABSENCE OF PUBLISHED PROCEDURES, AS FOLLOWS:
 1. TEST FOR LEAKS AND DEFECTS IN NEW PIPING AND PARTS OF EXISTING PIPING THAT HAVE BEEN ALTERED, EXTENDED, OR REPAIRED. IF TESTING IS PERFORMED IN SEGMENTS, SUBMIT SEPARATE REPORT FOR EACH TEST. COMPLETE WITH DIAGRAM OF PORTION OF PIPING TESTED.
 2. LEAVE UNCOVERED AND UNCONCEALED NEW, ALTERED, EXTENDED, OR REPLACED DRAINAGE AND VENT PIPING UNTIL IT HAS BEEN TESTED AND APPROVED. EXPOSE WORK THAT WAS COVERED OR CONCEALED BEFORE IT WAS TESTED.
 3. ROUGHING-IN PLUMBING TEST PROCEDURE: TEST DRAINAGE AND VENT PIPING EXCEPT OUTSIDE LEADERS ON COMPLETION OF ROUGHING-IN. CLOSE OPENINGS IN PIPING SYSTEM AND FILL WITH WATER TO POINT OF OVERFLOW, BUT NOT LESS THAN 10-FOOT HEAD OF WATER (30 KPA). FROM 15 MINUTES BEFORE INSPECTION STARTS TO COMPLETION OF INSPECTION, WATER LEVEL MUST NOT DROP. INSPECT JOINTS FOR LEAKS.
 4. FINISHED PLUMBING TEST PROCEDURE: AFTER PLUMBING FIXTURES HAVE BEEN SET AND TRAPS FILLED WITH WATER, TEST CONNECTIONS AND PROVE THEY ARE GASTIGHT AND WATERTIGHT. PLUG VENT STACK OPENINGS ON ROOF AND BUILDING DRAINS WHERE THEY LEAVE BUILDING. INTRODUCE AIR INTO PIPING SYSTEM EQUAL TO PRESSURE OF 1-INCH WG (250 PA). USE U-TUBE OR MANOMETER INSERTED IN TRAP OF WATER CLOSET TO MEASURE THIS PRESSURE. AIR PRESSURE MUST REMAIN CONSTANT WITHOUT INTRODUCING ADDITIONAL AIR THROUGHOUT PERIOD OF INSPECTION. INSPECT PLUMBING FIXTURE CONNECTIONS FOR GAS AND WATER LEAKS.
 5. REPAIR LEAKS AND DEFECTS WITH NEW MATERIALS AND RETEST PIPING, OR PORTION THEREOF, UNTIL SATISFACTORY RESULTS ARE OBTAINED.
 6. PREPARE REPORTS FOR TESTS AND REQUIRED CORRECTIVE ACTION.

SHEET NOTES

- P8. STORM DRAINAGE DOWN FROM ABOVE SLAB. SEE P2.1A.ii FOR CONTINUATION.
- P9. GREASE WASTE DOWN FROM ABOVE SLAB. SEE P2.1A.ii FOR CONTINUATION.
- P10. SANITARY DOWN FROM ABOVE SLAB. SEE P2.1A.ii FOR CONTINUATION.
- P32. 4" SANITARY UP TO TRENCH DRAIN. REFER TO STRUCTURAL DRAWINGS AND DETAIL S153.2.ii FOR ADDITIONAL INFORMATION.

KEY PLAN

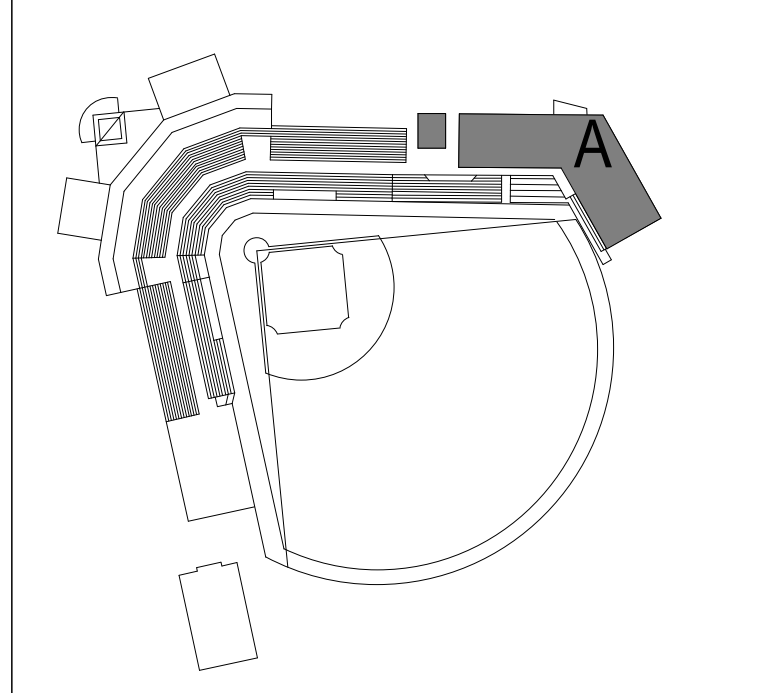

DLR Group
 1500 ROUTE 90, FISHKILL, NY 12520
 STATE OF NEW YORK
 JAMES W. WELLS
 091343
 LICENSED PROFESSIONAL ENGINEER
 11-7-23

REBID DUTCHESS STADIUM NEW LEFT FIELD CLUBHOUSE, SEATING BOWL, & RESTROOM BUILDING
 OWNER: DUTCHESS COUNTY, 22 MARKET STREET POUGHKEEPSIE, NY 12601
 1500 ROUTE 90, FISHKILL, NY 12520

BID SET


11.04.22	
REVISIONS	
1 PKG 2 - ASI 001	04.07.23
2 PKG 2 - ASI 09	09.15.23
3 PKG 2 - ASI 11	11.09.23

57-21113-00
 UNDERGROUND PLUMBING PLAN - AREA A - DRAINAGE

P1.1A.2.ii

UNDERGROUND PLUMBING PLAN - AREA A - DRAINAGE
 SCALE: 1/8" = 1'-0"

B:\117\2023\117-21113-00_Dutchess Stadium\PH\117-21113-00_Dutchess Stadium_P111_MEP_2023.rvt
 11/17/2023 12:22:48 PM

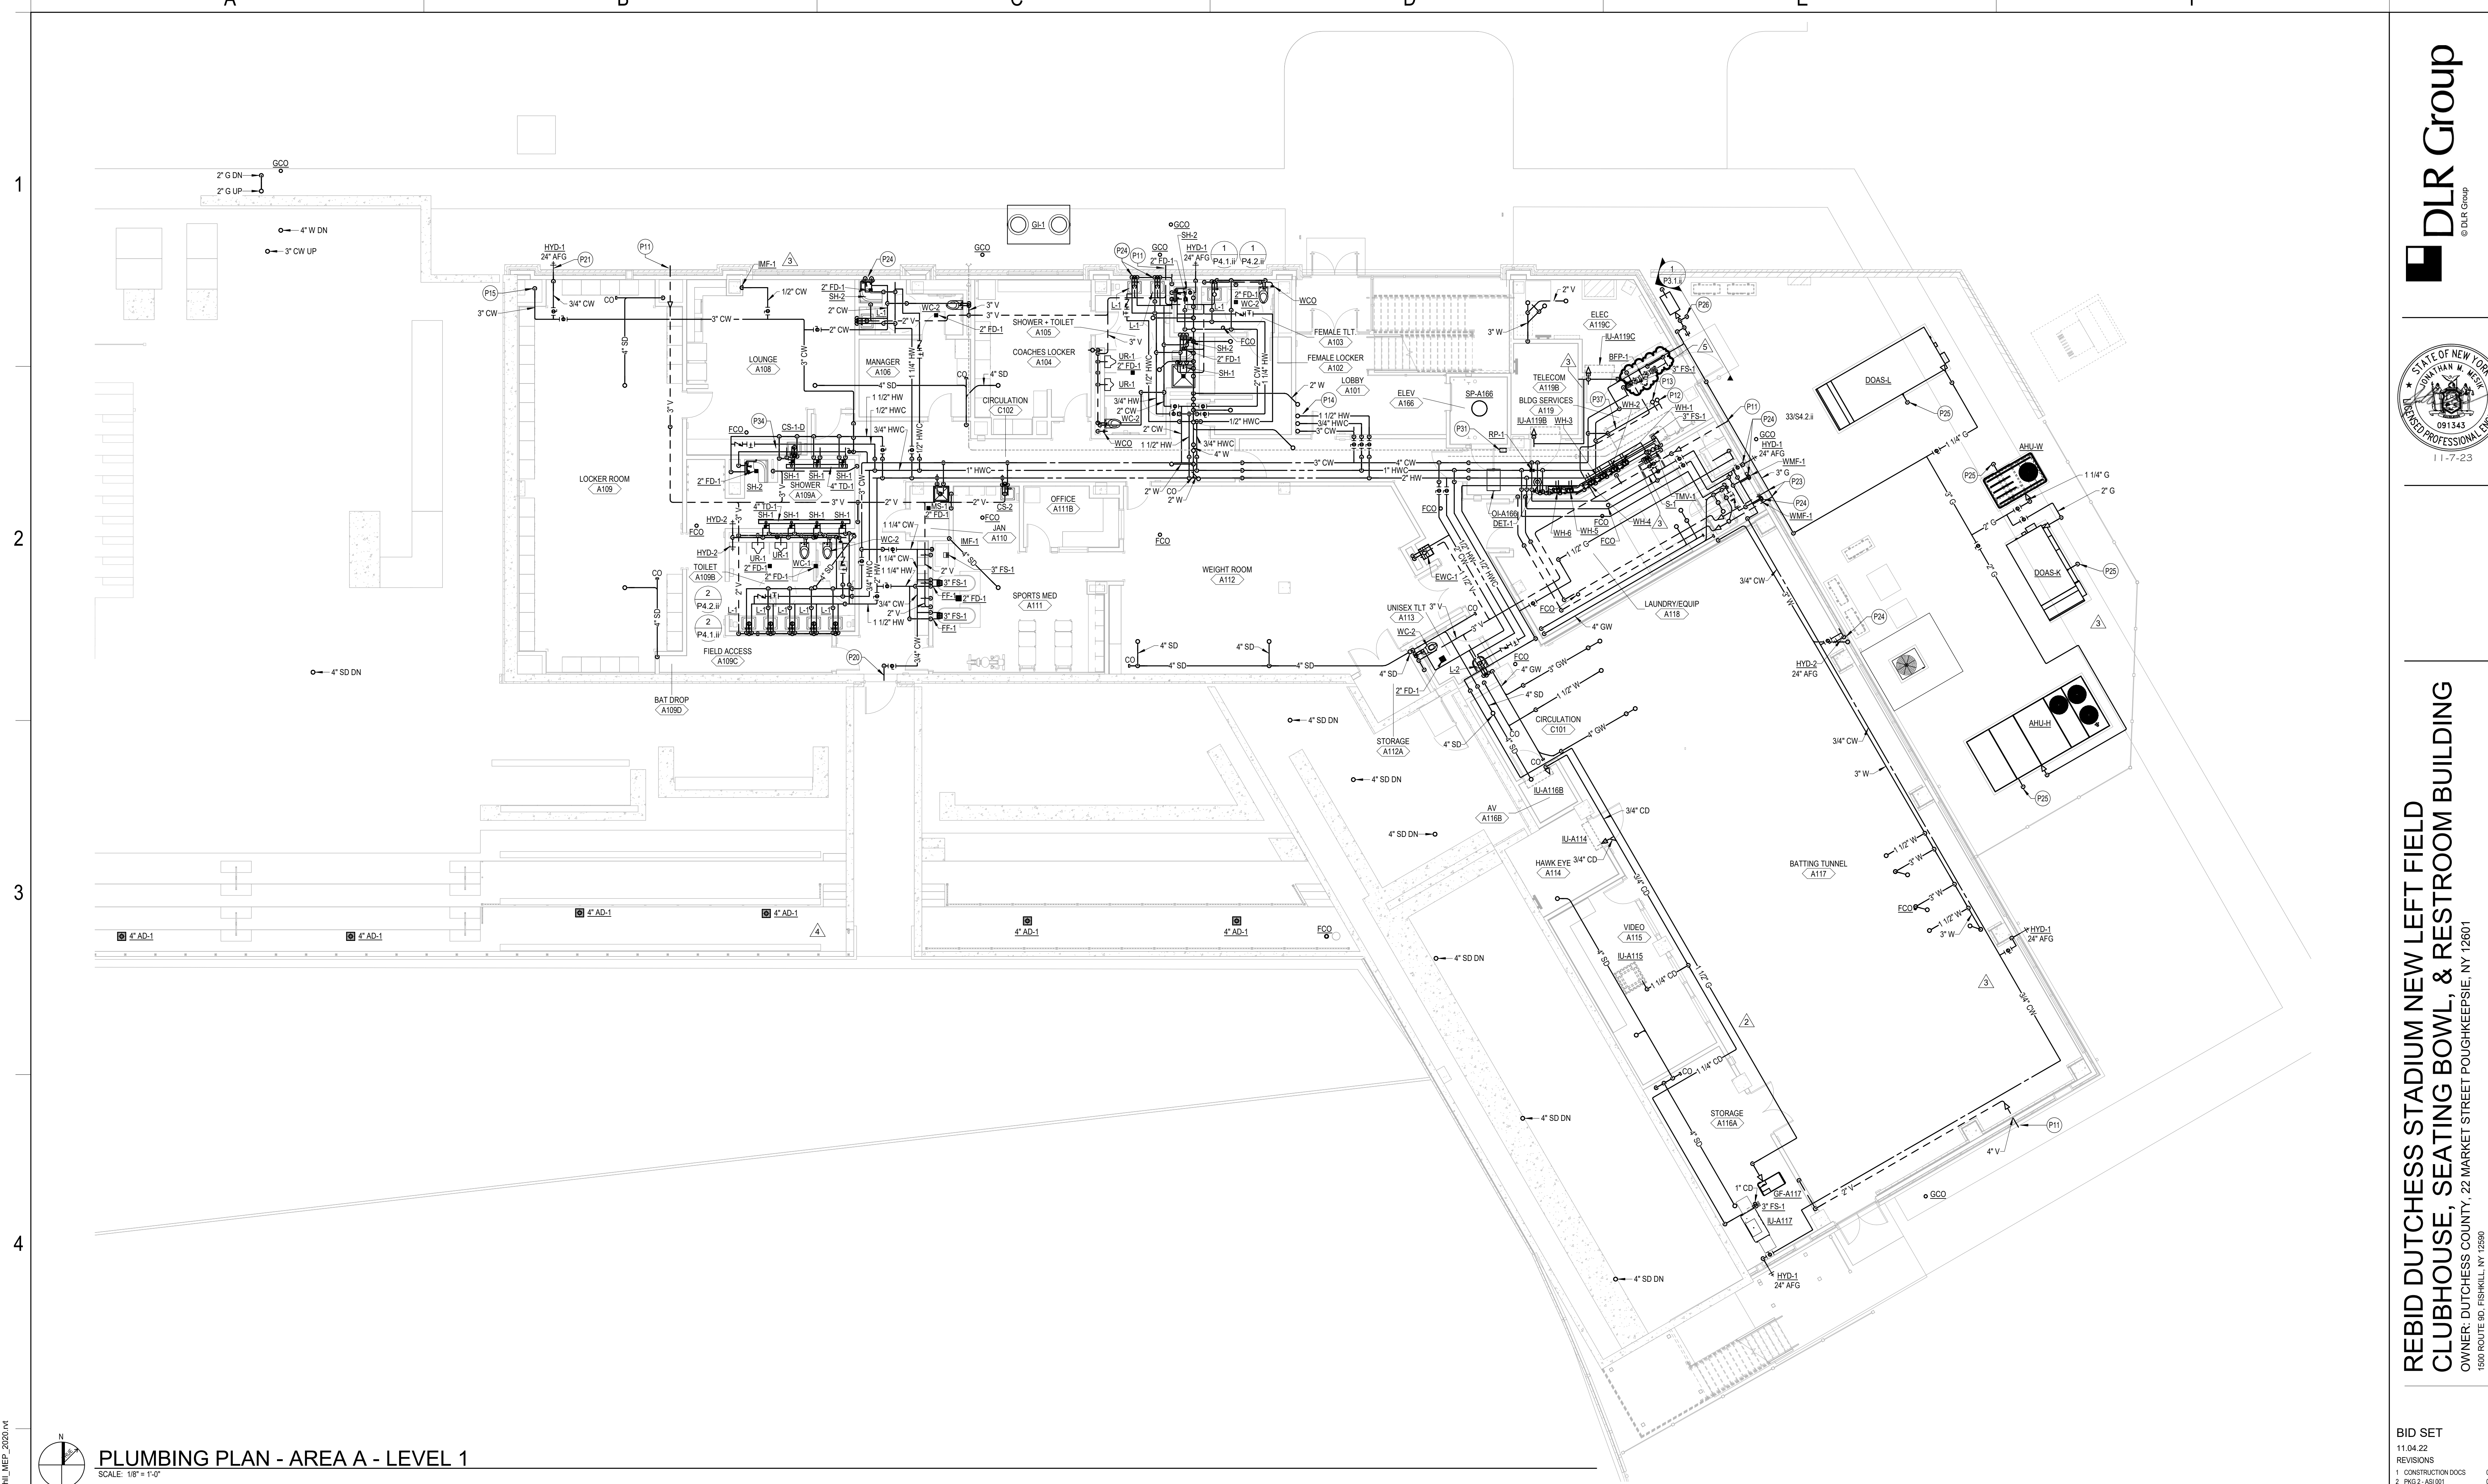

PLUMBING PLAN - AREA A - LEVEL 1
 SCALE: 1/8" = 1'-0"

GENERAL NOTES

A FOR SYMBOLS AND ABBREVIATIONS SEE DRAWING P0.1.


SHEET NOTES

- P11 4" SANITARY VENT TERMINATION. PROVIDE WITH 45° ELBOW WITH BIRD SCREEN.
- P12 DOMESTIC COLD WATER UP TO LEVEL ABOVE. SEE P2.2A.I FOR CONTINUATION.
- P13 NATURAL GAS UP TO LEVEL ABOVE.
- P14 DOMESTIC COLD AND HOT WATER UP TO LEVEL ABOVE AND DOMESTIC HOT WATER RECIRCULATION DOWN FROM LEVEL ABOVE. SEE P2.2A.I FOR CONTINUATION.
- P15 DOMESTIC COLD WATER DOWN TO BELOW GRADE. SEE P1.1A.II FOR CONTINUATION.
- P20 3/4" DOMESTIC COLD WATER TO WALL HYDRANT ABOVE SEATING BOWL WALKWAY ON LEVEL ABOVE. INSTALL SO THAT PIPING IS TIGHT TO BOTTOM OF STRUCTURE. SEE P2.2A.II FOR CONTINUATION.
- P21 WALL HYDRANT TO FUNCTION AS MAIN BUILDING BLOW DOWN CONNECTION. REFER TO DETAIL 1E.P1.II FOR ADDITIONAL INFORMATION.
- P23 4" OIL SEPARATOR VENT TERMINATIONS. PROVIDE WITH 45° ELBOW WITH BIRD SCREEN. INSTALL VENTS PER OIL SEPARATOR MANUFACTURER'S INSTRUCTIONS.
- P24 ALL PLUMBING PIPING IN THIS EXTERIOR WALL TO BE INSTALLED ON INTERIOR SIDE OF INSULATION.

SHEET NOTES

- P25 DRAIN CONDENSATE TO GRAVEL SURROUNDING CONCRETE EQUIPMENT PADS IN MECHANICAL YARD. CONDENSATE PIPING TO BE COPPER.
- P26 2" GAS PIPING DOWN TO BELOW GRADE. SEE P1.1A.II FOR CONTINUATION.
- P31 INSTALL SUMP PUMP SIMPLEX ALARM PANEL IN THIS LOCATION.
- P34 CONNECT DISHWASHER DRAIN TO SINK SANITARY. REFER TO DETAIL S.A.P15.1.
- P37 ROUTE GAS AND DOMESTIC COLD WATER PIPING STACKED TOGETHER AS HIGH AS POSSIBLE BETWEEN CONCRETE STRUCTURAL BEAMS ABOVE DUCTWORK.


KEY PLAN

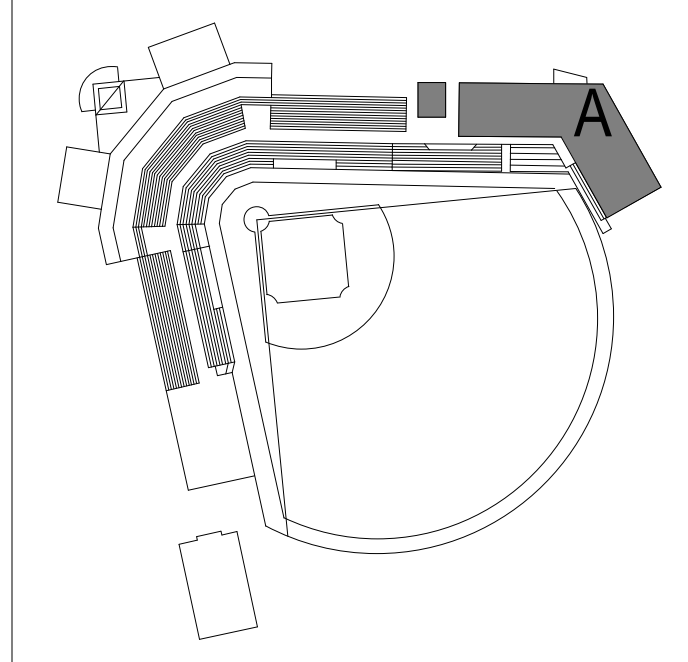

BID SET

11.04.22	
REVISIONS	
1 CONSTRUCTION DOCS	03.06.23
2 PKG 2 - ASI 001	06.07.23
3 PKG 2 - ASI 007	06.07.23
4 PKG 2 - ASI 009	09.15.23
5 PKG 2 - ASI 11	11.07.23

B:\360\57-21113-00_Dutchess Stadium\PH\57-21113-00_Dutchess Stadium_Plan_MEP_2020.rvt
 11/17/2023 12:24:49 PM

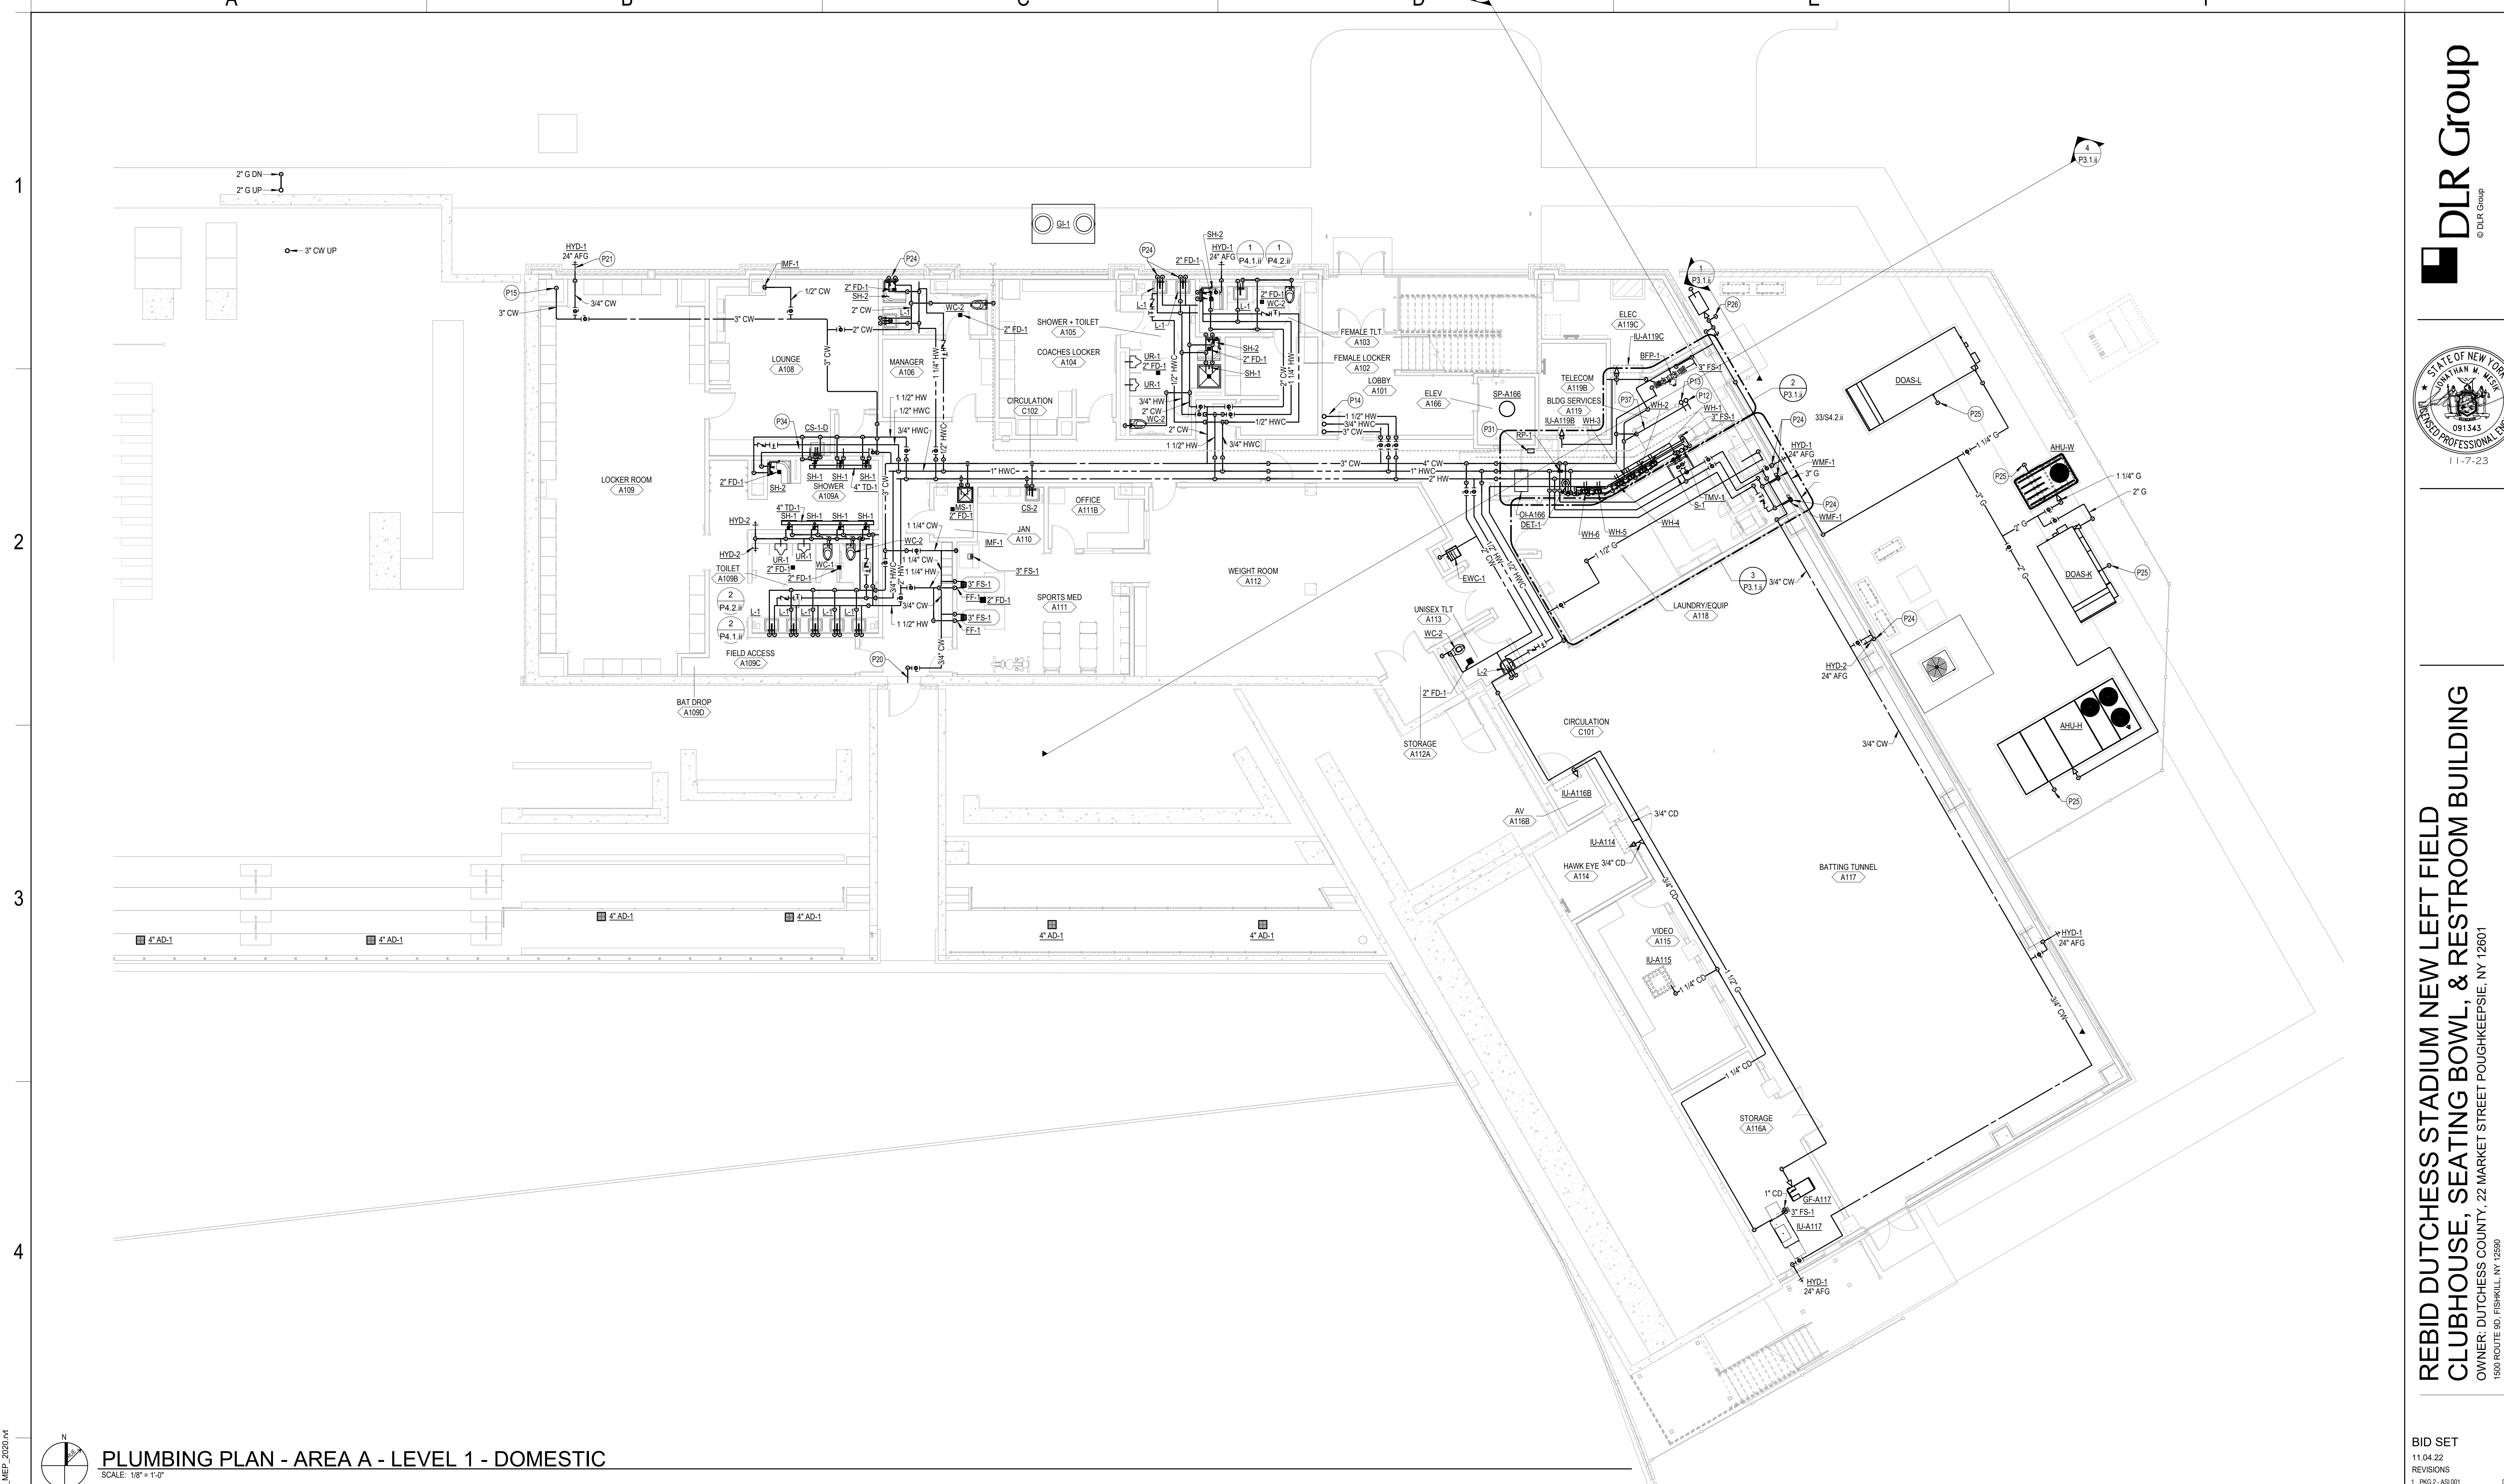

PLUMBING PLAN - AREA A - LEVEL 1 - DOMESTIC
 SCALE: 1/8" = 1'-0"

GENERAL NOTES

- A. FOR SYMBOLS AND ABBREVIATIONS SEE DRAWING PD.1.
- B. PIPING TESTS:
 1. FILL DOMESTIC WATER PIPING. CHECK COMPONENTS TO DETERMINE THAT THEY ARE NOT AIR BOUND AND THAT PIPING IS FULL OF WATER.
 2. TEST FOR LEAKS AND DEFECTS IN NEW PIPING AND PARTS OF EXISTING PIPING THAT HAVE BEEN ALTERED, EXTENDED, OR REPAIRED. IF TESTING IS PERFORMED IN SECTIONS, SUBMIT A SEPARATE REPORT FOR EACH TEST. COMPLETE WITH DIAGRAM OF PORTION OF PIPING TESTED.
 3. LEAVE NEW, ALTERED, EXTENDED, OR REPLACED DOMESTIC WATER PIPING UNCOVERED AND UNCONCEALED UNTIL IT HAS BEEN TESTED AND APPROVED. EXPOSE WORK THAT WAS COVERED OR CONCEALED BEFORE IT WAS TESTED.
 4. CAP AND SUBJECT PIPING TO STATIC WATER PRESSURE OF 50 PSIG (345 KPA) ABOVE OPERATING PRESSURE, WITHOUT EXCEEDING PRESSURE RATING OF PIPING SYSTEM MATERIALS. ISOLATE TEST SOURCE AND ALLOW IT TO STAND FOR FOUR HOURS. LEAKS AND LOSS IN TEST PRESSURE CONSTITUTE DEFECTS THAT MUST BE REPAIRED.
 5. REPAIR LEAKS AND DEFECTS WITH NEW MATERIALS, AND RETEST PIPING OR PORTION THEREOF UNTIL SATISFACTORY RESULTS ARE OBTAINED.
 6. PREPARE REPORTS FOR TESTS AND FOR CORRECTIVE ACTION REQUIRED.

GENERAL NOTES

- C. CLEAN AND DISINFECT POTABLE DOMESTIC WATER PIPING AS FOLLOWS:
 1. PURGE NEW PIPING AND PARTS OF EXISTING PIPING THAT HAVE BEEN ALTERED, EXTENDED, OR REPAIRED BEFORE USING.
 2. USE PURGING AND DISINFECTING PROCEDURES PRESCRIBED BY AUTHORITIES HAVING JURISDICTION; IF METHODS ARE NOT PRESCRIBED, USE PROCEDURES DESCRIBED IN EITHER AWWA C651 OR AWWA C652 OR FOLLOW PROCEDURES DESCRIBED BELOW.
 - a. FLUSH PIPING SYSTEM WITH CLEAN, POTABLE WATER UNTIL DIRTY WATER DOES NOT APPEAR AT OUTLETS.
 - b. FILL AND ISOLATE SYSTEM ACCORDING TO EITHER OF THE FOLLOWING:
 - FILL SYSTEM OR PART THEREOF WITH WATER/CHLORINE SOLUTION WITH AT LEAST 50 PPM (50 MG/L) OF CHLORINE. ISOLATE WITH VALVES AND ALLOW TO STAND FOR 24 HOURS.
 - FILL SYSTEM OR PART THEREOF WITH WATER/CHLORINE SOLUTION WITH AT LEAST 200 PPM (200 MG/L) OF CHLORINE. ISOLATE AND ALLOW TO STAND FOR THREE HOURS.
 - c. FLUSH SYSTEM WITH CLEAN, POTABLE WATER UNTIL NO CHLORINE IS IN WATER COMING FROM SYSTEM AFTER THE STANDING TIME.

GENERAL NOTES

- D. REPEAT PROCEDURES IF BIOLOGICAL EXAMINATION SHOWS CONTAMINATION.
 - a. SUBMIT WATER SAMPLES IN STERILE BOTTLES TO AUTHORITIES HAVING JURISDICTION.
- E. CLEAN NON-POTABLE DOMESTIC WATER PIPING AS FOLLOWS:
 1. PURGE NEW PIPING AND PARTS OF EXISTING PIPING THAT HAVE BEEN ALTERED, EXTENDED, OR REPAIRED BEFORE USING.
 2. USE PURGING PROCEDURES PRESCRIBED BY AUTHORITIES HAVING JURISDICTION OR, IF METHODS ARE NOT PRESCRIBED, FOLLOW PROCEDURES DESCRIBED BELOW.
 - a. FLUSH PIPING SYSTEM WITH CLEAN, POTABLE WATER UNTIL DIRTY WATER DOES NOT APPEAR AT OUTLETS.
 - b. SUBMIT WATER SAMPLES IN STERILE BOTTLES TO AUTHORITIES HAVING JURISDICTION. REPEAT PROCEDURES IF BIOLOGICAL EXAMINATION SHOWS CONTAMINATION.
 3. PREPARE AND SUBMIT REPORTS OF PURGING AND DISINFECTING ACTIVITIES. INCLUDE COPIES OF WATER-SAMPLE APPROVALS FROM AUTHORITIES HAVING JURISDICTION TO STAND FOR THREE HOURS.
 4. CLEAN INTERIOR OF DOMESTIC WATER PIPING SYSTEM. REMOVE DIRT AND DEBRIS AS WORK PROGRESSES.



SHEET NOTES

- P12 DOMESTIC COLD WATER UP TO LEVEL ABOVE. SEE P2.2A.ii FOR CONTINUATION.
- P13 NATURAL GAS UP TO LEVEL ABOVE.
- P14 DOMESTIC COLD AND HOT WATER UP TO LEVEL ABOVE AND DOMESTIC HOT WATER RECIRCULATION DOWN FROM LEVEL ABOVE. SEE P2.2A.ii FOR CONTINUATION.
- P15 DOMESTIC COLD WATER DOWN TO BELOW GRADE. SEE P1.1A.i FOR CONTINUATION.
- P20 3/4" DOMESTIC COLD WATER TO WALL HYDRANT ABOVE SEATING BOWL WALKWAY ON LEVEL ABOVE. INSTALL SO THAT PIPING IS TIGHT TO BOTTOM OF STRUCTURE. SEE P2.2A.i FOR CONTINUATION.
- P21 WALL HYDRANT TO FUNCTION AS MAIN BUILDING BLOW DOWN CONNECTION. REFER TO DETAIL 1E.PS.1.H FOR ADDITIONAL INFORMATION.

SHEET NOTES

- P24 ALL PLUMBING PIPING IN THIS EXTERIOR WALL TO BE INSTALLED ON INTERIOR SIDE OF INSULATION.
- P25 NATURAL GAS PIPING TO GRAVEL SURROUNDING CONCRETE EQUIPMENT PADS IN MECHANICAL YARD. CONDENSATE PIPING TO BE COPPER.
- P26 2" GAS PIPING DOWN TO BELOW GRADE. SEE P1.1A.i FOR CONTINUATION.
- P31 INSTALL SUMP PUMP SIMPLEX ALARM PANEL IN THIS LOCATION.
- P34 CONNECT DISHWASHER DRAIN TO SINK SANITARY. REFER TO DETAIL SA.PS.1.i.
- P37 ROUTE GAS AND DOMESTIC COLD WATER PIPING STACKED TIGHT TOGETHER AS HIGH AS POSSIBLE BETWEEN CONCRETE STRUCTURAL BEAMS ABOVE DUCTWORK.

KEY PLAN

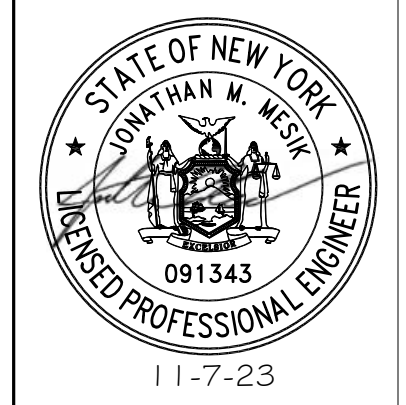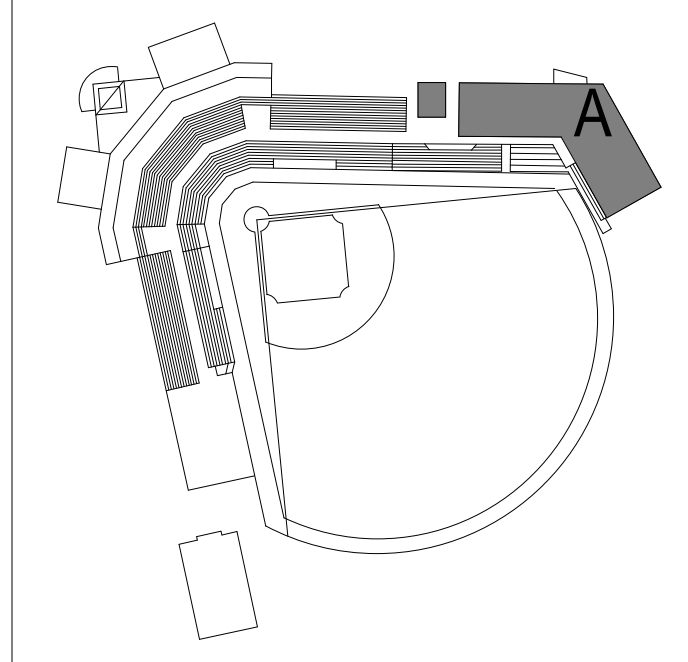

BID SET


11.04.22	
REVISIONS	
1 PKG 2 - ASI 001	04.07.23
2 PKG 2 - ASI 01	08.07.23
3 PKG 2 - ASI 09	09.15.23
4 PKG 2 - ASI 11	11.07.23

57-21113-00

PLUMBING PLAN - AREA A - LEVEL 1 - DOMESTIC

P2.1A.1.ii

B:\360\57-21113-00_Address Stadium_Plan\57-21113-00_Dutchess Stadium_Plan_MEP_2020.rvt
 11/7/2023 12:23:22 PM

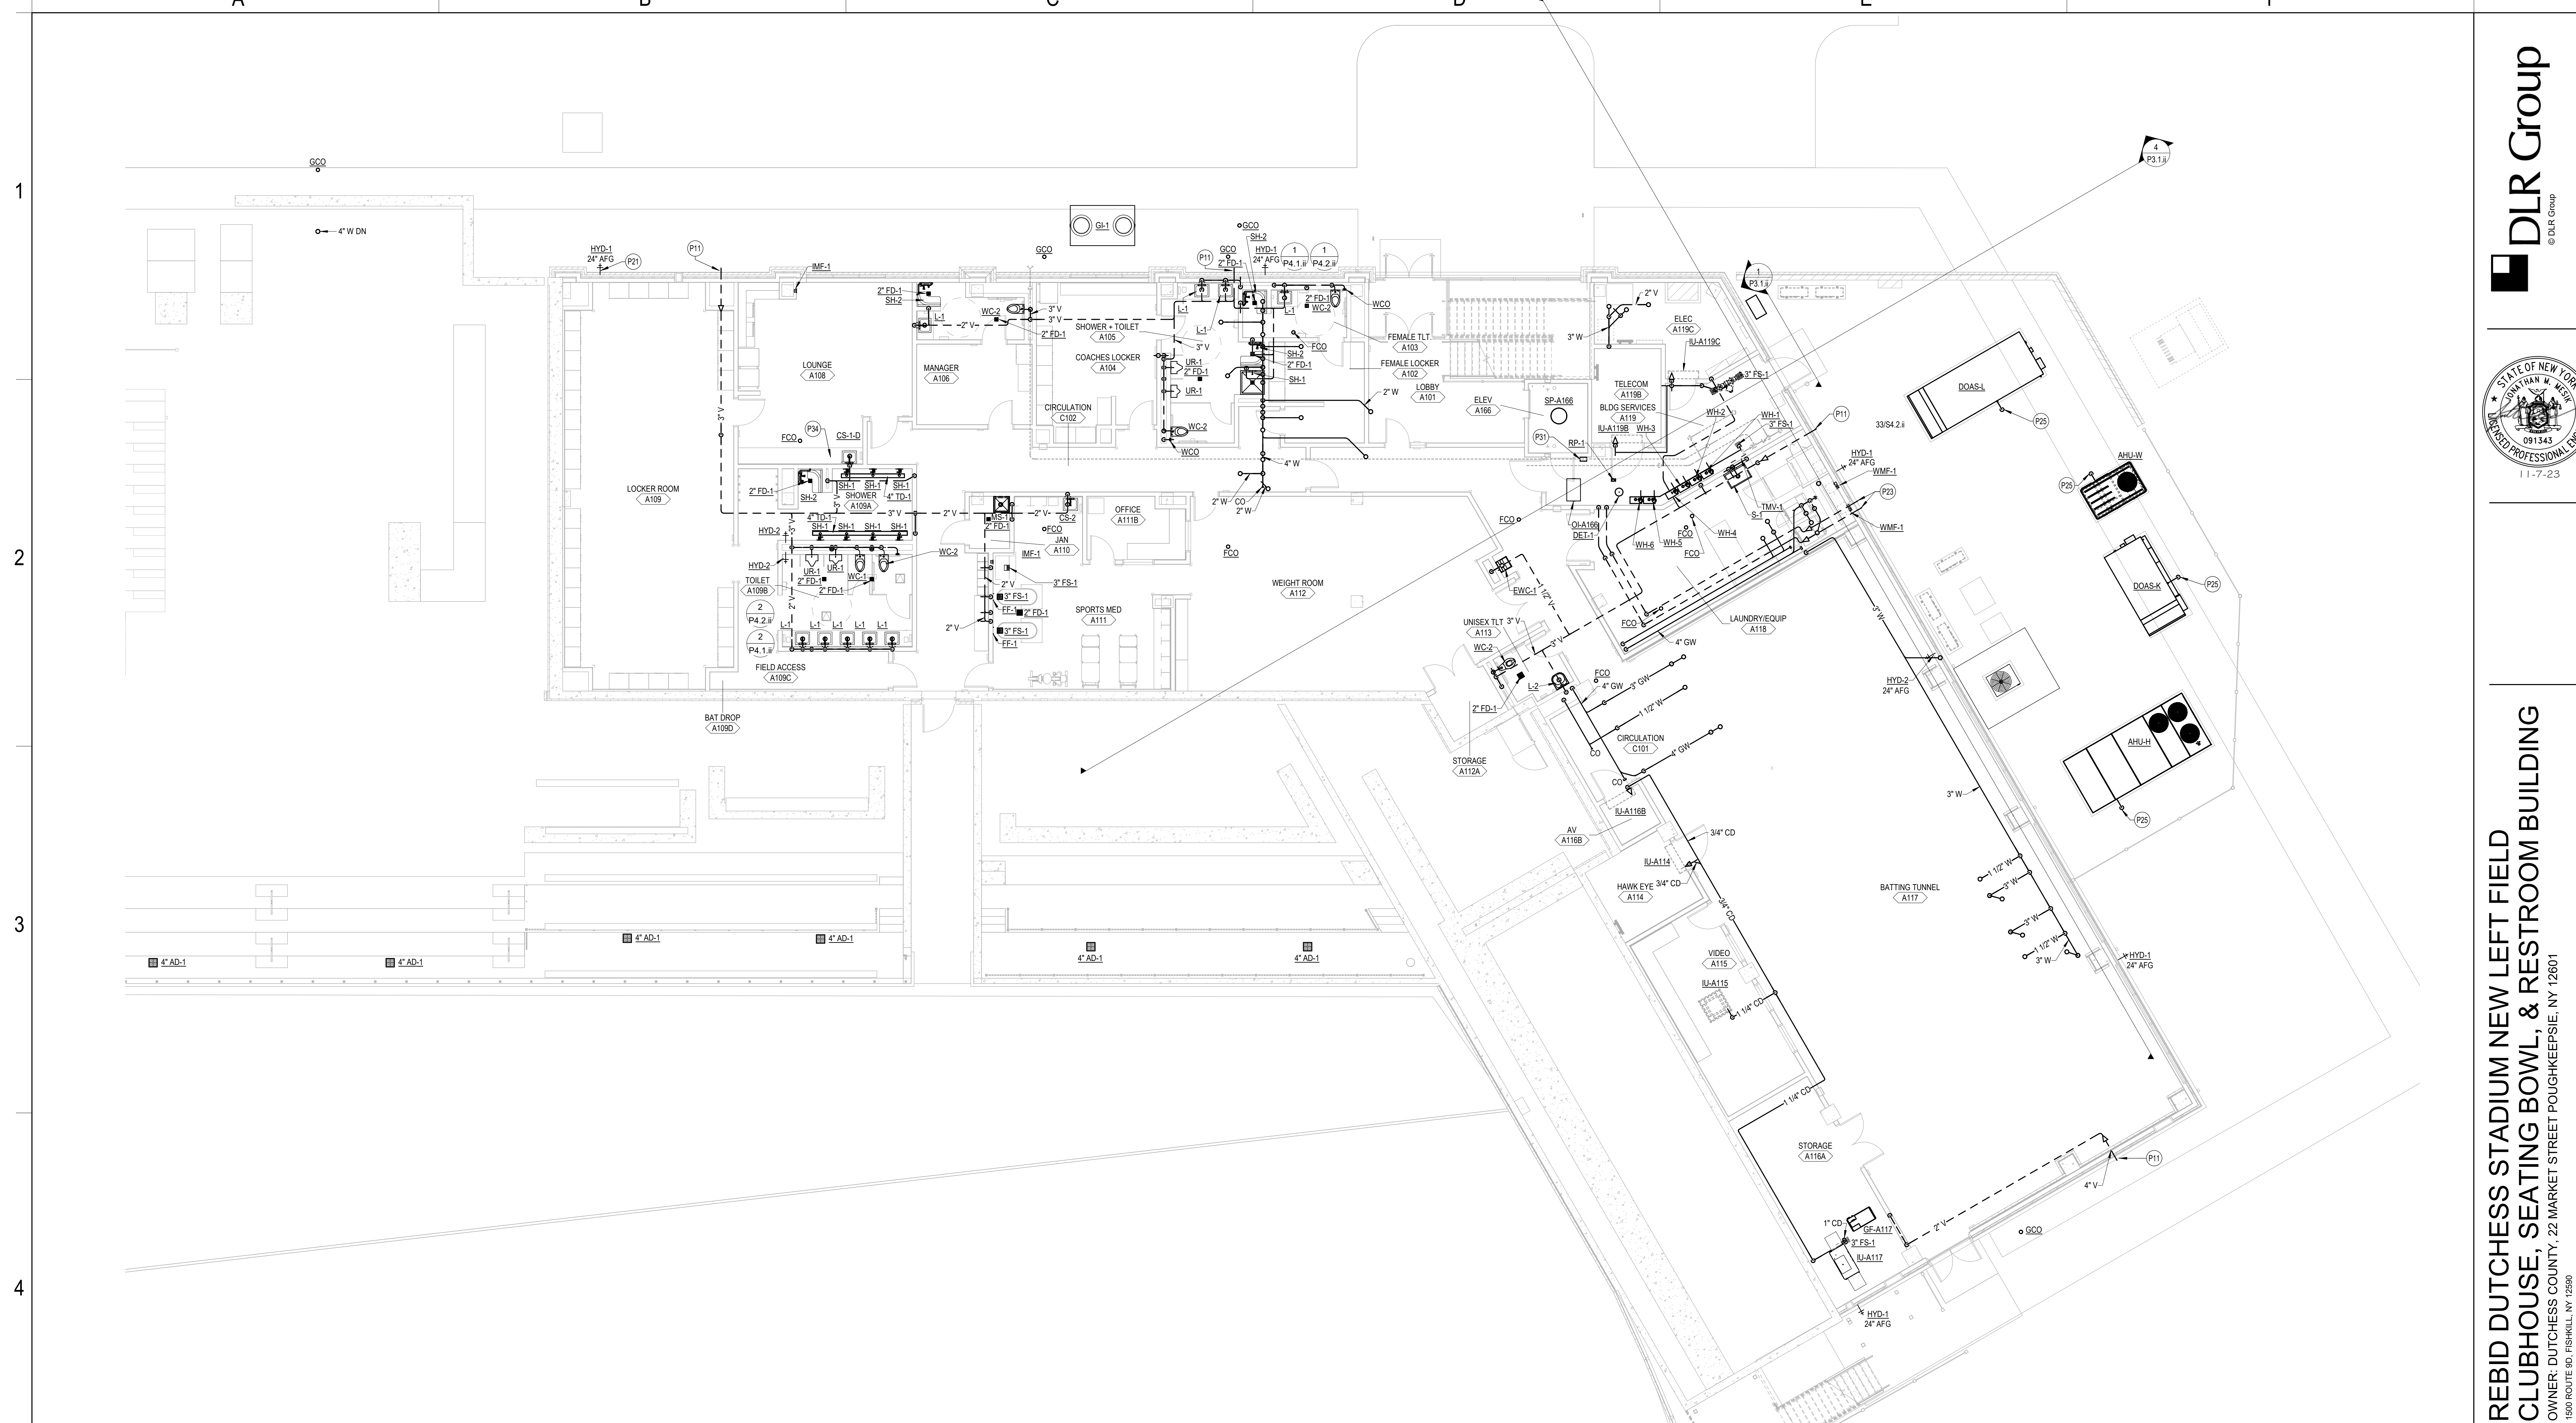

PLUMBING PLAN - AREA A - LEVEL 1 - DRAINAGE
 SCALE: 1/8" = 1'-0"

GENERAL NOTES

- A. FOR SYMBOLS AND ABBREVIATIONS SEE DRAWING P2.1
- B. TEST SANITARY DRAINAGE AND VENT PIPING ACCORDING TO PROCEDURES OF AUTHORITIES HAVING JURISDICTION OR, IN ABSENCE OF PUBLISHED PROCEDURES, AS FOLLOWS:
 1. TEST FOR LEAKS AND DEFECTS IN NEW PIPING AND PARTS OF EXISTING PIPING THAT HAVE BEEN ALTERED, EXTENDED, OR REPAIRED. IF TESTING IS PERFORMED IN SEGMENTS, SUBMIT SEPARATE REPORT FOR EACH TEST. COMPLETE WITH DIAGRAM OF PORTION OF PIPING TESTED.
 2. LEAVE UNCOVERED AND UNCONCEALED NEW, ALTERED, EXTENDED, OR REPLACED DRAINAGE AND VENT PIPING UNTIL IT HAS BEEN TESTED AND APPROVED. EXPOSE WORK THAT WAS COVERED OR CONCEALED BEFORE IT WAS TESTED.
 3. ROUGHING-IN PLUMBING TEST PROCEDURE: TEST DRAINAGE AND VENT PIPING EXCEPT OUTSIDE LEADERS ON COMPLETION OF ROUGHING-IN. CLOSE OPENINGS IN PIPING SYSTEM AND FILL WITH WATER TO POINT OF OVERFLOW, BUT NOT LESS THAN 10-FOOT HEAD OF WATER (30 KPA). FROM 15 MINUTES BEFORE INSPECTION STARTS TO COMPLETION OF INSPECTION, WATER LEVEL MUST NOT DROP. INSPECT JOINTS FOR LEAKS.


GENERAL NOTES

- 4. FINISHED PLUMBING TEST PROCEDURE: AFTER PLUMBING FIXTURES HAVE BEEN SET AND TRAPS FILLED WITH WATER, TEST CONNECTIONS AND PROVE THEY ARE GASTIGHT AND WATERTIGHT. PLUG VENT-STACK OPENINGS ON ROOF AND BUILDING DRAINS WHERE THEY LEAVE BUILDING. INTRODUCE AIR INTO PIPING SYSTEM EQUAL TO PRESSURE OF 1 INCH WG (250 PA). USE U-TUBE OR MANOMETER INSERTED IN TRAP OF WATER CLOSET TO MEASURE THIS PRESSURE. AIR PRESSURE MUST REMAIN CONSTANT WITHOUT INTRODUCING ADDITIONAL AIR THROUGHOUT PERIOD OF INSPECTION. INSPECT PLUMBING FIXTURE CONNECTIONS FOR GAS AND WATER LEAKS.
- 5. REPAIR LEAKS AND DEFECTS WITH NEW MATERIALS AND RETEST PIPING, OR PORTION THEREOF, UNTIL SATISFACTORY RESULTS ARE OBTAINED.
- 6. PREPARE REPORTS FOR TESTS AND REQUIRED CORRECTIVE ACTION.

SHEET NOTES

- P11 4" SANITARY VENT TERMINATION. PROVIDE WITH 45° ELBOW WITH BIRD SCREEN.
- P21 WALL HYDRANT TO FUNCTION AS MAIN BUILDING BLOW DOWN CONNECTION. REFER TO DETAIL T.E.P.S.1.1 FOR ADDITIONAL INFORMATION.
- P23 4" OIL SEPARATOR VENT TERMINATIONS. PROVIDE WITH 45° ELBOW WITH BIRD SCREEN. INSTALL VENTS PER OIL SEPARATOR MANUFACTURER'S INSTRUCTIONS.
- P25 DRAIN CONDENSATE TO GRAVEL SURROUNDING CONCRETE EQUIPMENT PADS IN MECHANICAL YARD. CONDENSATE PIPING TO BE COPPER.
- P31 INSTALL SLUMP PUMP SIMPLEX ALARM PANEL IN THIS LOCATION.
- P34 CONNECT DISHWASHER DRAIN TO SINK SANITARY. REFER TO DETAIL S.A.P.S.1.A.

KEY PLAN

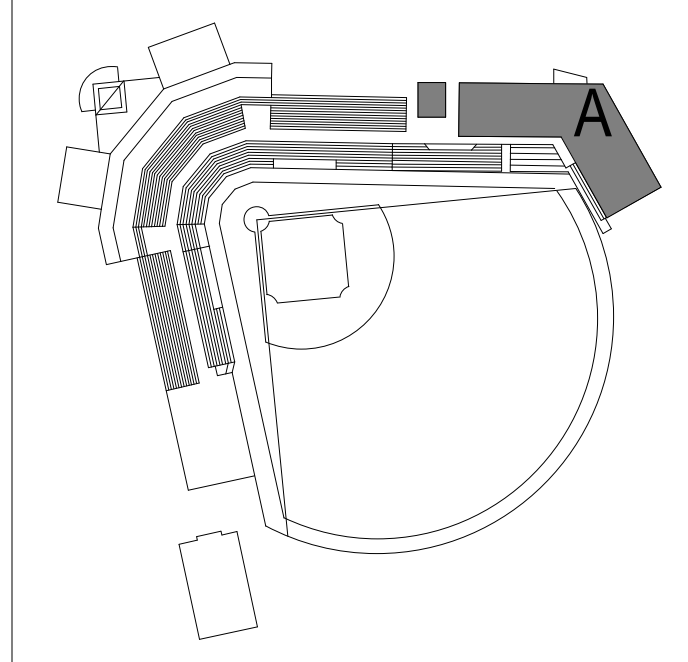

BID SET

11.04.22	
REVISIONS	
1	PKG 2 - ASI 001 04.07.23
2	PKG 2 - ASI 01 08.07.23
3	PKG 2 - ASI 09 09.15.23
4	PKG 2 - ASI 11 11.07.23

B:\600\57-21113-00_Dutchess Stadium\PH\57-21113-00_Dutchess Stadium_Plan_MEP_2020.rvt
 11/17/2023 12:24:01 PM

1
2
3
4
5

A


B

C

D

E

F

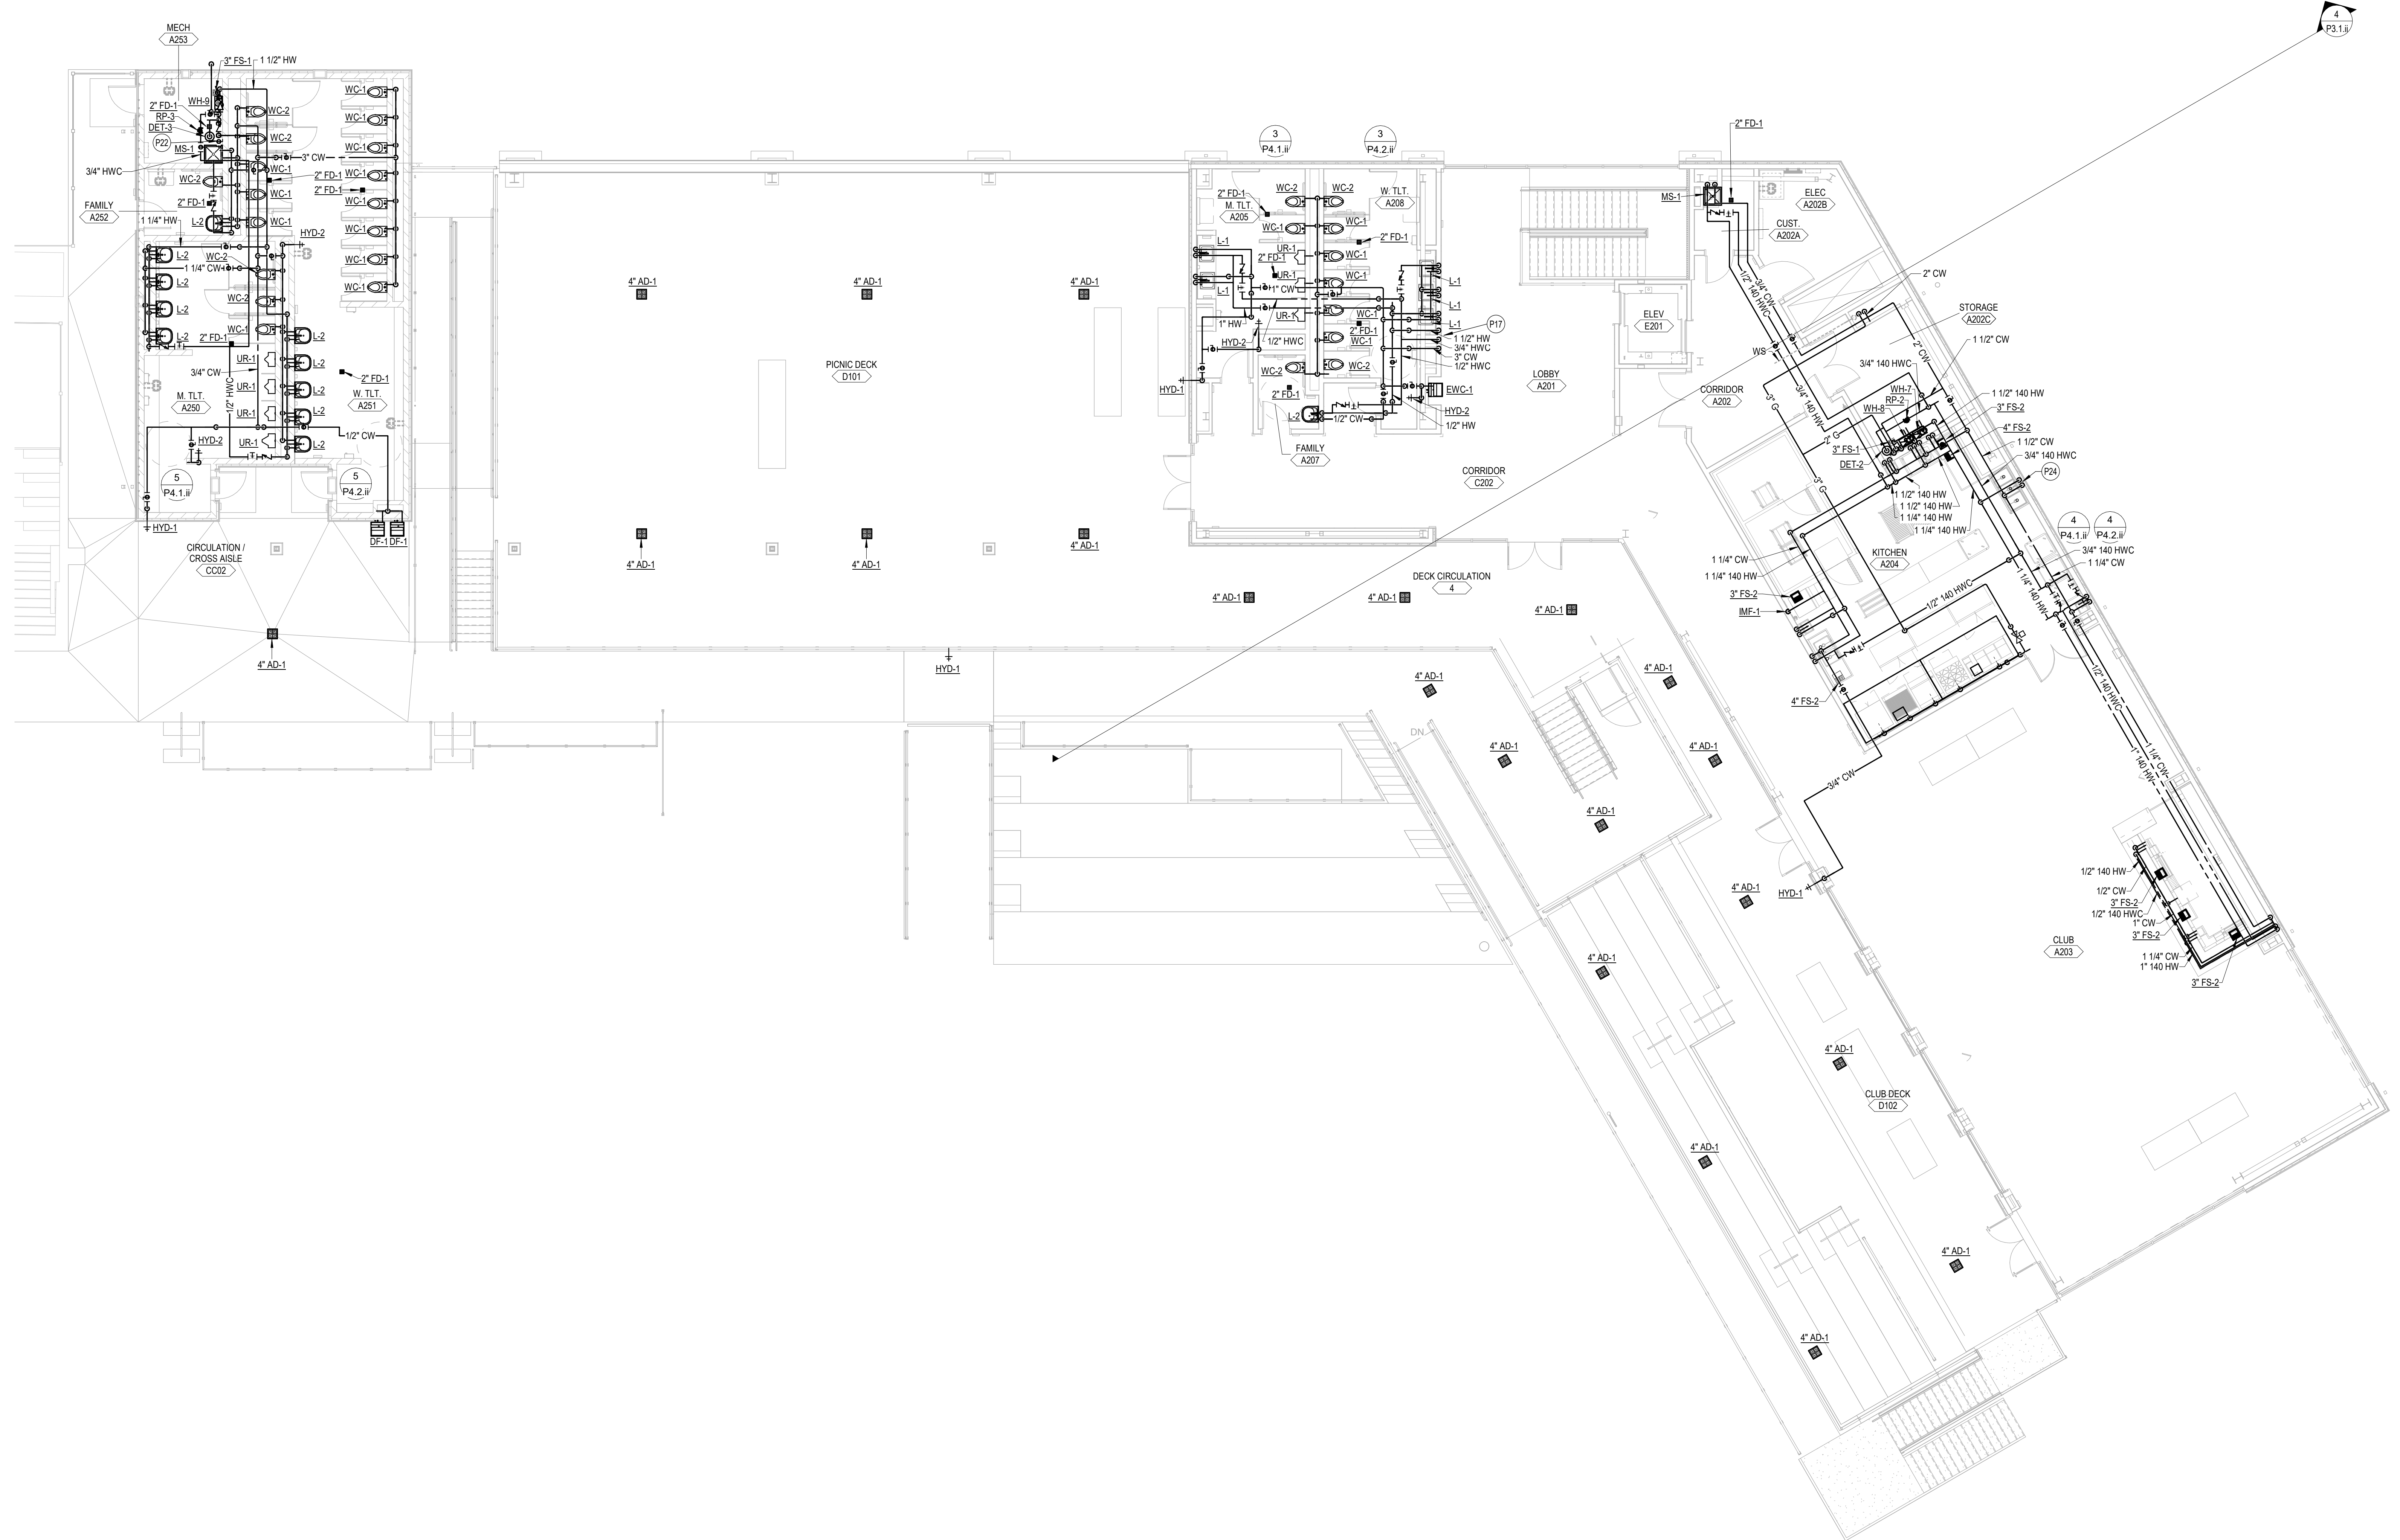


GENERAL NOTES

- A. FOR SYMBOLS AND ABBREVIATIONS SEE DRAWING P0.1.
 B. PIPING TESTS:
 1. FILL DOMESTIC WATER PIPING. CHECK COMPONENTS TO DETERMINE THAT THEY ARE NOT AIR BOUND AND THAT PIPING IS FULL OF WATER.
 2. TEST FOR LEAKS AND DEFECTS IN NEW PIPING AND PARTS OF EXISTING PIPING THAT HAVE BEEN ALTERED, EXTENDED, OR REPAIRED. IF TESTING IS PERFORMED IN SEGMENTS, SUBMIT A SEPARATE REPORT FOR EACH TEST. COMPLETE WITH DIAGRAM OF PORTION OF PIPING TESTED.
 3. LEAVE NEW, ALTERED, EXTENDED, OR REPLACED DOMESTIC WATER PIPING UNCOVERED AND UNCONCEALED UNTIL IT HAS BEEN TESTED AND APPROVED. EXPOSE WORK THAT WAS COVERED OR CONCEALED BEFORE IT WAS TESTED.
 4. CAP AND SUBJECT PIPING TO STATIC WATER PRESSURE OF 50 PSIG (345 KPA) ABOVE OPERATING PRESSURE. WITHOUT EXCEEDING PRESSURE RATING OF PIPING SYSTEM MATERIALS. ISOLATE TEST SOURCE AND ALLOW IT TO STAND FOR FOUR HOURS. LEAKS AND LOSS IN TEST PRESSURE CONSTITUTE DEFECTS THAT MUST BE REPAIRED.
 5. REPAIR LEAKS AND DEFECTS WITH NEW MATERIALS, AND RETEST PIPING OR PORTION THEREOF UNTIL SATISFACTORY RESULTS ARE OBTAINED.
 6. PREPARE REPORTS FOR TESTS AND FOR CORRECTIVE ACTION REQUIRED.
 C. CLEAN AND DISINFECT POTABLE DOMESTIC WATER PIPING AS FOLLOWS:
 1. PURGE NEW PIPING AND PARTS OF EXISTING PIPING THAT HAVE BEEN ALTERED, EXTENDED, OR REPAIRED BEFORE USING.
 2. USE PURGING AND DISINFECTING PROCEDURES PRESCRIBED BY AUTHORITIES HAVING JURISDICTION; IF METHODS ARE NOT PRESCRIBED, USE PROCEDURES DESCRIBED IN EITHER ANWA C851 OR ANWA C852 OR FOLLOW PROCEDURES DESCRIBED BELOW.
 a. FLUSH PIPING SYSTEM WITH CLEAN, POTABLE WATER UNTIL DIRTY WATER DOES NOT APPEAR AT OUTLETS.
 b. FILL AND ISOLATE SYSTEM ACCORDING TO EITHER OF THE FOLLOWING:
 • FILL SYSTEM OR PART THEREOF WITH WATER/CHLORINE SOLUTION WITH AT LEAST 50 PPM (50 MG/L) OF CHLORINE. ISOLATE WITH VALVES AND ALLOW TO STAND FOR 24 HOURS.
 • FILL SYSTEM OR PART THEREOF WITH WATER/CHLORINE SOLUTION WITH AT LEAST 200 PPM (200 MG/L) OF CHLORINE. ISOLATE AND ALLOW TO STAND FOR THREE HOURS.
 c. FLUSH SYSTEM WITH CLEAN, POTABLE WATER UNTIL NO CHLORINE IS IN WATER COMING FROM SYSTEM AFTER THE STANDING TIME.
 d. REPEAT PROCEDURES IF BIOLOGICAL EXAMINATION SHOWS CONTAMINATION.
 e. SUBMIT WATER SAMPLES IN STERILE BOTTLES TO AUTHORITIES HAVING JURISDICTION.
 D. CLEAN NON-POTABLE DOMESTIC WATER PIPING AS FOLLOWS:
 1. PURGE NEW PIPING AND PARTS OF EXISTING PIPING THAT HAVE BEEN ALTERED, EXTENDED, OR REPAIRED BEFORE USING.
 2. USE PURGING PROCEDURES PRESCRIBED BY AUTHORITIES HAVING JURISDICTION OR, IF METHODS ARE NOT PRESCRIBED, FOLLOW PROCEDURES DESCRIBED BELOW.
 a. FLUSH PIPING SYSTEM WITH CLEAN, POTABLE WATER UNTIL DIRTY WATER DOES NOT APPEAR AT OUTLETS.
 b. SUBMIT WATER SAMPLES IN STERILE BOTTLES TO AUTHORITIES HAVING JURISDICTION. REPEAT PROCEDURES IF BIOLOGICAL EXAMINATION SHOWS CONTAMINATION.
 E. PREPARE AND SUBMIT REPORTS OF PURGING AND DISINFECTING ACTIVITIES. INCLUDE COPIES OF WATER-SAMPLE APPROVALS FROM AUTHORITIES HAVING JURISDICTION.
 F. CLEAN INTERIOR OF DOMESTIC WATER PIPING SYSTEM. REMOVE DIRT AND DEBRIS AS WORK PROGRESSES.

SHEET NOTES

- P17. DOMESTIC COLD AND HOT WATER UP FROM LEVEL BELOW AND DOMESTIC HOT WATER RECIRCULATION DOWN TO LEVEL BELOW. SEE P2.1A.II FOR CONTINUATION.
 P22. REMOTE LOCATION BLOW DOWN CONNECTION. REFER TO DETAIL P2.P5.II FOR ADDITIONAL INFORMATION.
 P24. ALL PLUMBING PIPING IN THIS EXTERIOR WALL TO BE INSTALLED ON INTERIOR SIDE OF INSULATION.

KEY PLAN

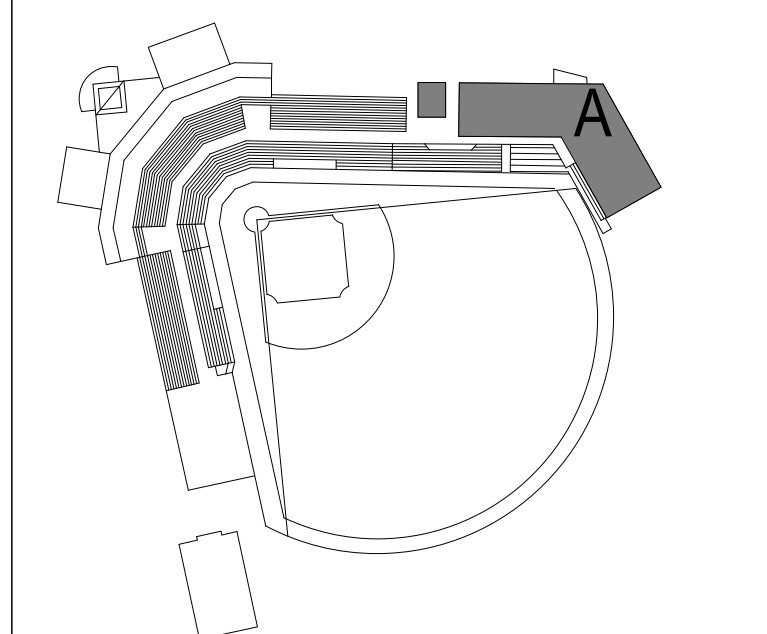

PLUMBING PLAN - AREA A - LEVEL 2 - DOMESTIC
 SCALE: 1/8" = 1'-0"

DLR Group
 © DLR Group
 STATE OF NEW YORK
 SEAL OF THE STATE OF NEW YORK
 JAMES W. WELLS
 091343
 LICENSED PROFESSIONAL ENGINEER
 11-7-23

REBID DUTCHESS STADIUM NEW LEFT FIELD CLUBHOUSE, SEATING BOWL, & RESTROOM BUILDING
 OWNER: DUTCHESS COUNTY, 22 MARKET STREET Poughkeepsie, NY 12601
 1500 ROUTE 90, FISHKILL, NY 12590

BID SET

11.04.22	
REVISIONS	
1 PKG 2 - ASI 07	08.07.23
2 PKG 2 - ASI 11	11.07.23

57-21113-00
 PLUMBING PLAN - AREA A - LEVEL 2 - DOMESTIC

P2.2A.1.ii

B:\600\57-21113-00_Dutchess Stadium\Plumbing\Plumbing_Plan_MEP_2020.rvt
 11/17/2023 12:25:19 PM




GENERAL NOTES

- A. FOR SYMBOLS AND ABBREVIATIONS SEE DRAWING PG. 1.
- B. TEST SANITARY DRAINAGE AND VENT PIPING ACCORDING TO PROCEDURES OF AUTHORITIES HAVING JURISDICTION OR, IN ABSENCE OF PUBLISHED PROCEDURES, AS FOLLOWS:
 1. TEST FOR LEAKS AND DEFECTS IN NEW PIPING AND PARTS OF EXISTING PIPING THAT HAVE BEEN ALTERED, EXTENDED, OR REPAIRED. IF TESTING IS PERFORMED IN SEGMENTS, SUBMIT SEPARATE REPORT FOR EACH TEST. COMPLETE WITH DIAGRAM OF PORTION OF PIPING TESTED.
 2. LEAVE UNCOVERED AND UNCONCEALED NEW, ALTERED, EXTENDED, OR REPLACED DRAINAGE AND VENT PIPING UNTIL IT HAS BEEN TESTED AND APPROVED. EXPOSE WORK THAT WAS COVERED OR CONCEALED BEFORE IT WAS TESTED.
 3. ROUGH-IN PLUMBING TEST PROCEDURE: TEST DRAINAGE AND VENT PIPING EXCEPT OUTSIDE LEADERS ON COMPLETION OF ROUGH-IN. CLOSE OPENINGS IN PIPING SYSTEM AND FILL WITH WATER TO POINT OF OVERFLOW, BUT NOT LESS THAN 10 FOOT HEAD OF WATER (30 KPA). FROM 15 MINUTES BEFORE INSPECTION STARTS TO COMPLETION OF INSPECTION, WATER LEVEL MUST NOT DROP. INSPECT JOINTS FOR LEAKS.
 4. FINISHED PLUMBING TEST PROCEDURE: AFTER PLUMBING FIXTURES HAVE BEEN SET AND TRAPS FILLED WITH WATER, TEST CONNECTIONS AND PROVE THEY ARE GASTIGHT AND WATERTIGHT. PLUG VENT-STACK OPENINGS ON ROOF AND BUILDING DRAINS WHERE THEY LEAVE BUILDING. INTRODUCE AIR INTO PIPING SYSTEM EQUAL TO PRESSURE OF 1 INCH WG (250 PA). USE U-TUBE OR MANOMETER INSERTED IN TOP OF WATER TUBE CLOSEST TO MEASURE THIS PRESSURE. AIR PRESSURE MUST REMAIN CONSTANT WITHOUT INTRODUCING ADDITIONAL AIR THROUGHOUT PERIOD OF INSPECTION. INSPECT PLUMBING FIXTURE CONNECTIONS FOR GAS AND WATER LEAKS.
 5. REPAIR LEAKS AND DEFECTS WITH NEW MATERIALS AND RETEST PIPING, OR PORTION THEREOF, UNTIL SATISFACTORY RESULTS ARE OBTAINED.
 6. PREPARE REPORTS FOR TESTS AND REQUIRED CORRECTIVE ACTION.

SHEET NOTES

- P24 ALL PLUMBING PIPING IN THIS EXTERIOR WALL TO BE INSTALLED ON INTERIOR SIDE OF INSULATION.

KEY PLAN

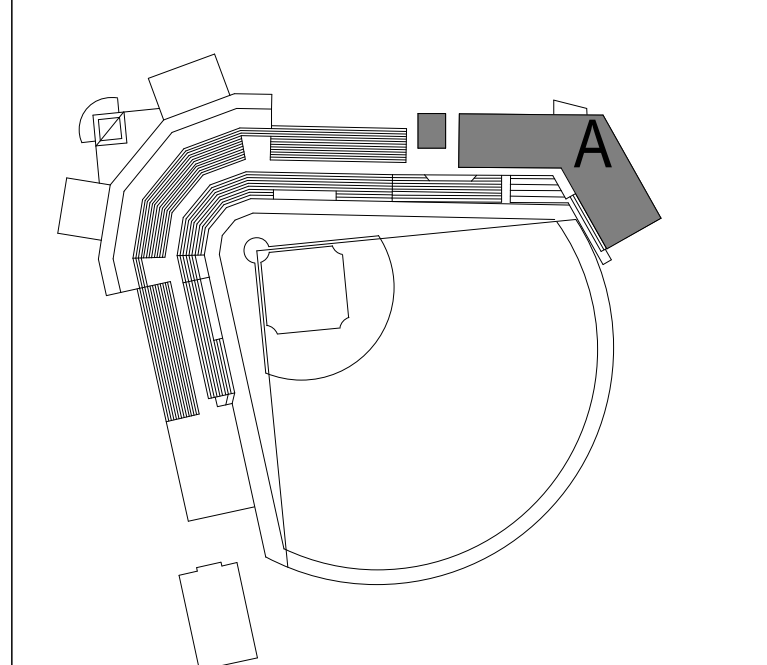

DLR Group
 © DLR Group
 STATE OF NEW YORK
 JONATHAN W. WEST
 091343
 LICENSED PROFESSIONAL ENGINEER
 11-7-23

REBID DUTCHESS STADIUM NEW LEFT FIELD CLUBHOUSE, SEATING BOWL, & RESTROOM BUILDING
 OWNER: DUTCHESS COUNTY, 22 MARKET STREET POUGHKEEPSIE, NY 12601
 1500 ROUTE 90, FISHKILL, NY 12590

BID SET

11.04.22	
REVISIONS	
1 PKG 2 - ASI 07	08.07.23
2 PKG 2 - ASI 11	11.07.23

57-21113-00
 PLUMBING PLAN - AREA A - LEVEL 2 - DRAINAGE

P2.2A.2.ii

PLUMBING PLAN - AREA A - LEVEL 2 - DRAINAGE
 SCALE: 1/8" = 1'-0"

B:\060\57-21113-00_Dutchess Stadium\PH\05721113-00_Dutchess Stadium_Plan_MEP_2020.rvt
 11/17/2023 12:25:30 PM

A

B

C

D

E

F

GENERAL NOTES

A FOR SYMBOLS AND ABBREVIATIONS SEE DRAWING P0.1.

SHEET NOTES

P28 REFER TO DETAIL SD/PS.1.1 FOR PIPE SIZES TO WATER HEATERS AND ADDITIONAL INFORMATION.



REBID DUTCHESS STADIUM NEW LEFT FIELD CLUBHOUSE, SEATING BOWL, & RESTROOM BUILDING
OWNER: DUTCHESS COUNTY, 22 MARKET STREET POUGHKEEPSIE, NY 12601
1500 ROUTE 90, FISHKILL, NY 12590


BID SET
11.04.22

REVISIONS


1	CONSTRUCTION DOCS	03.06.23
2	PKG 2 - ASB UP	08.07.23
3	PKG 2 - ASB IT	11.07.23

57-21113-00
ENLARGED PLUMBING PLANS AND SECTIONS


P3.1.ii

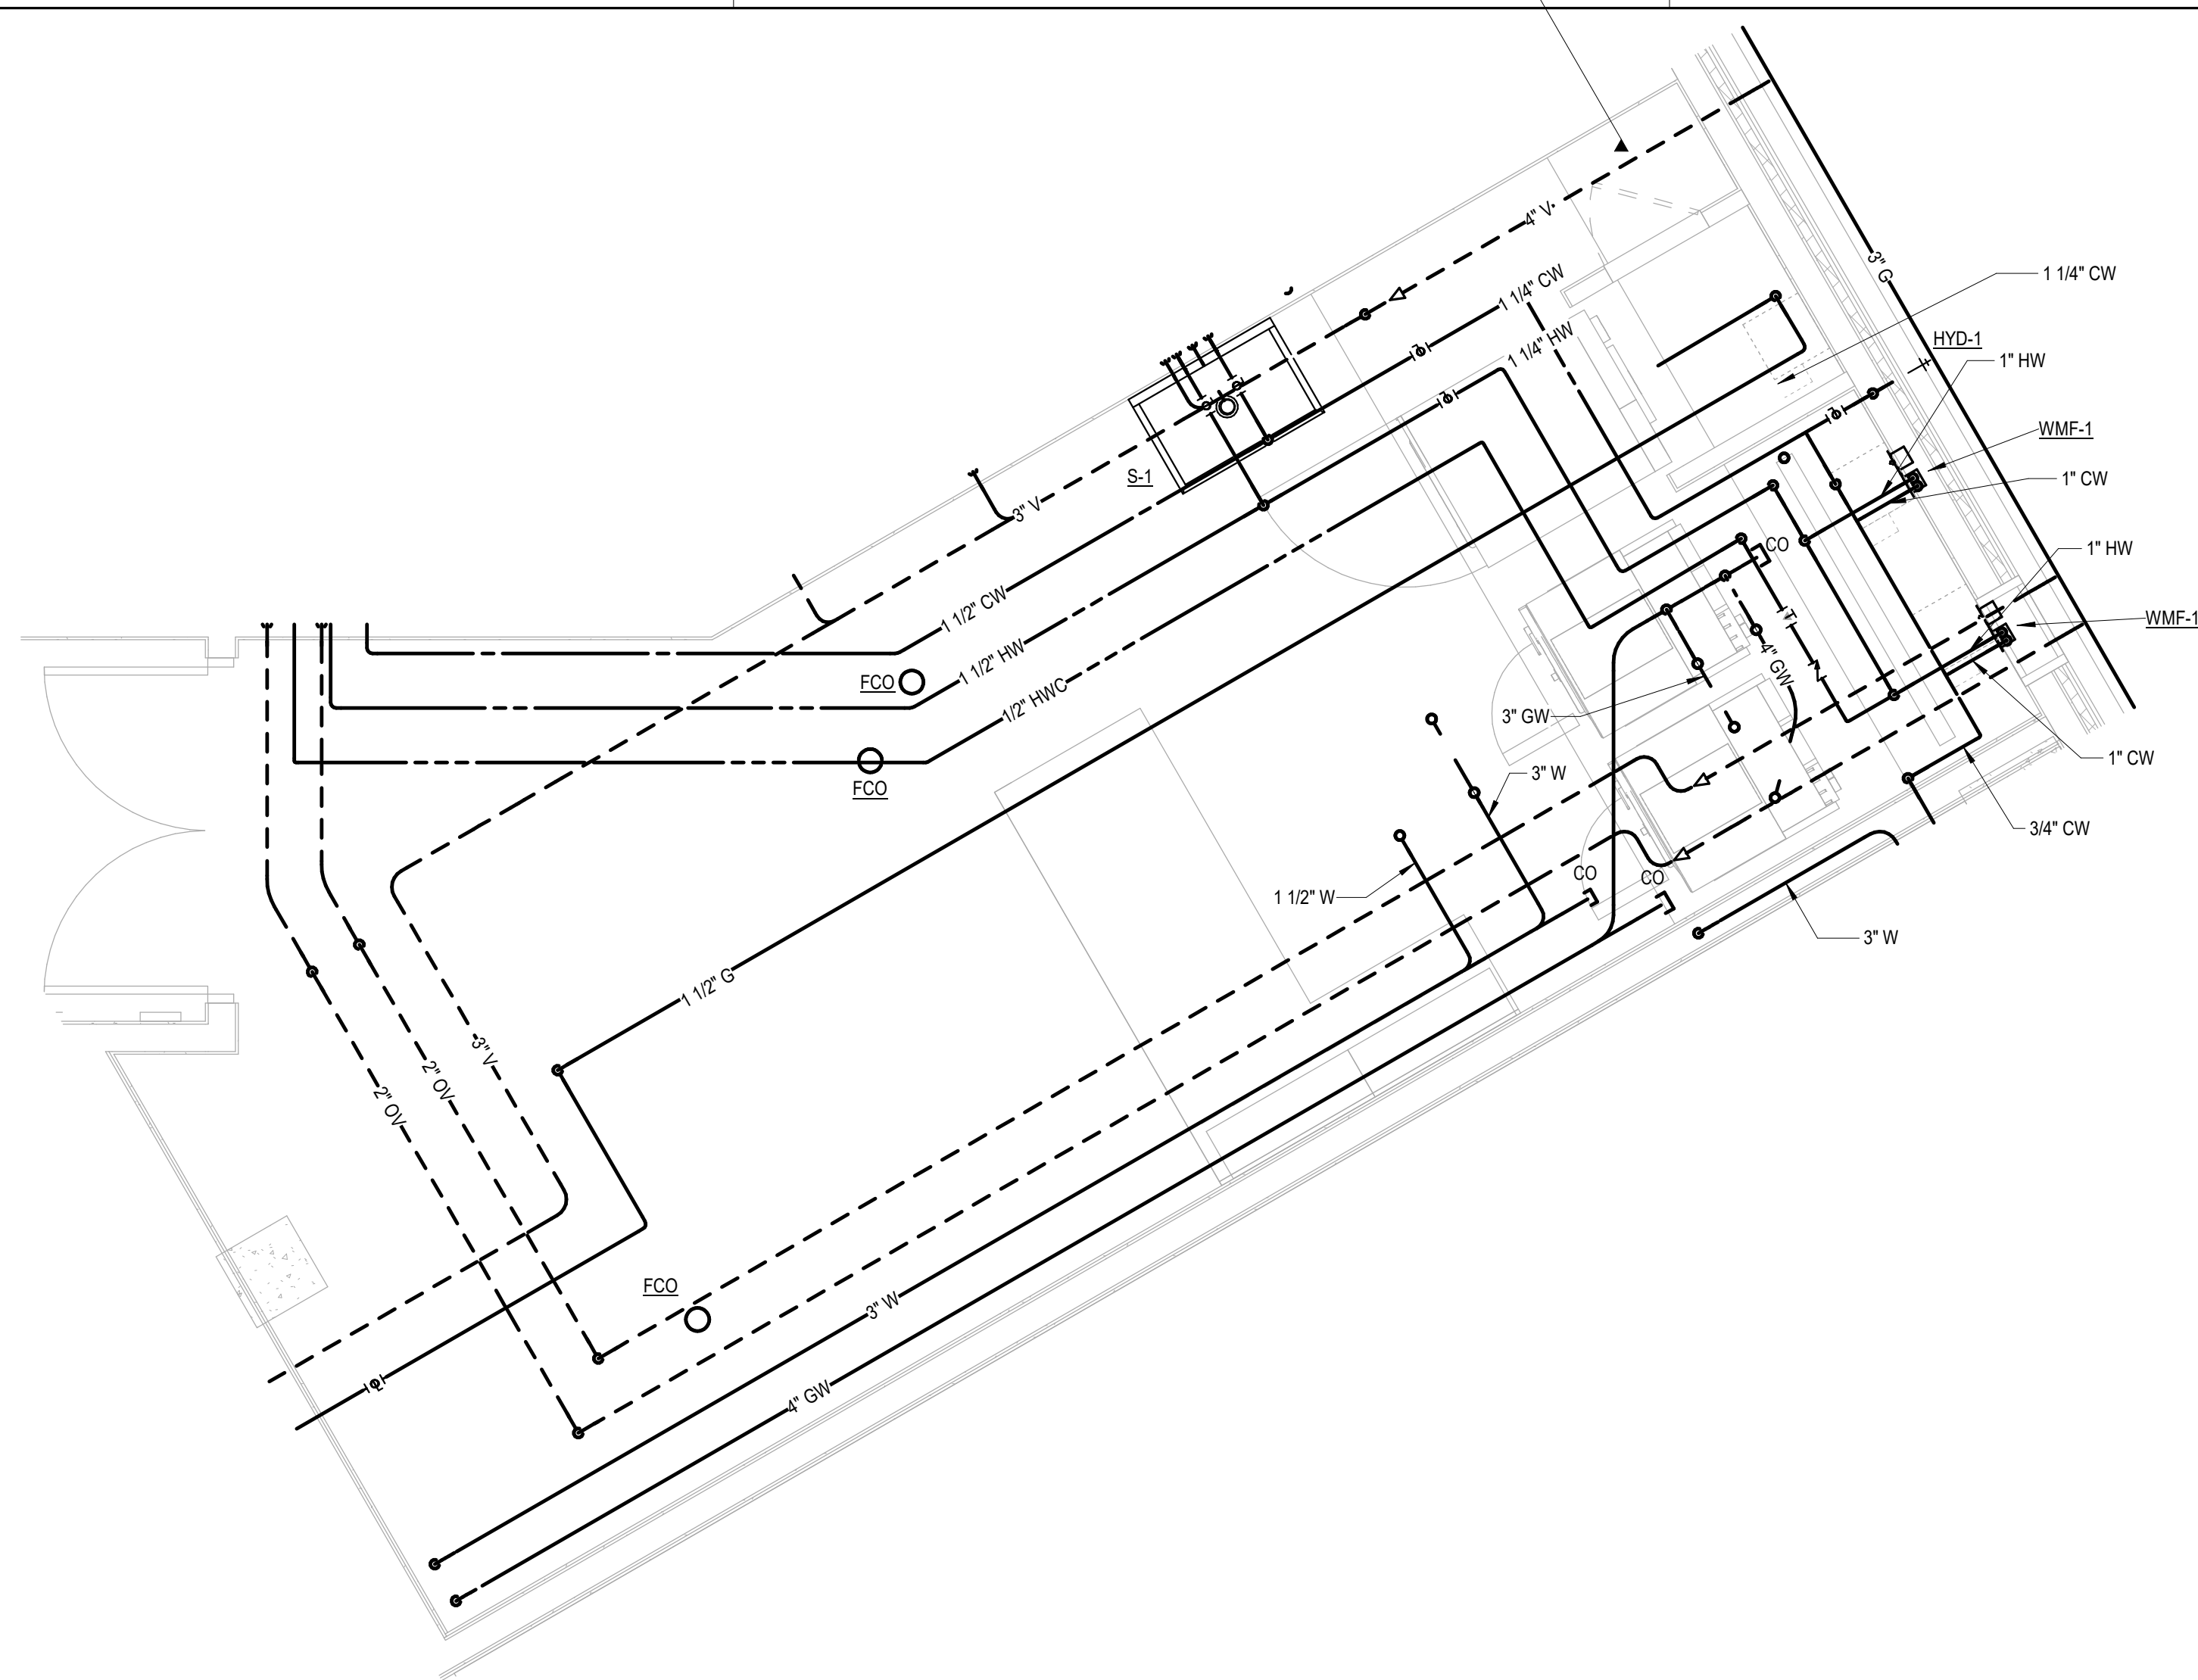


3 LAUNDRY/EQUIP (A118) ENLARGED PLUMBING PLAN
P3.1.ii SCALE: 3/8" = 1'-0"

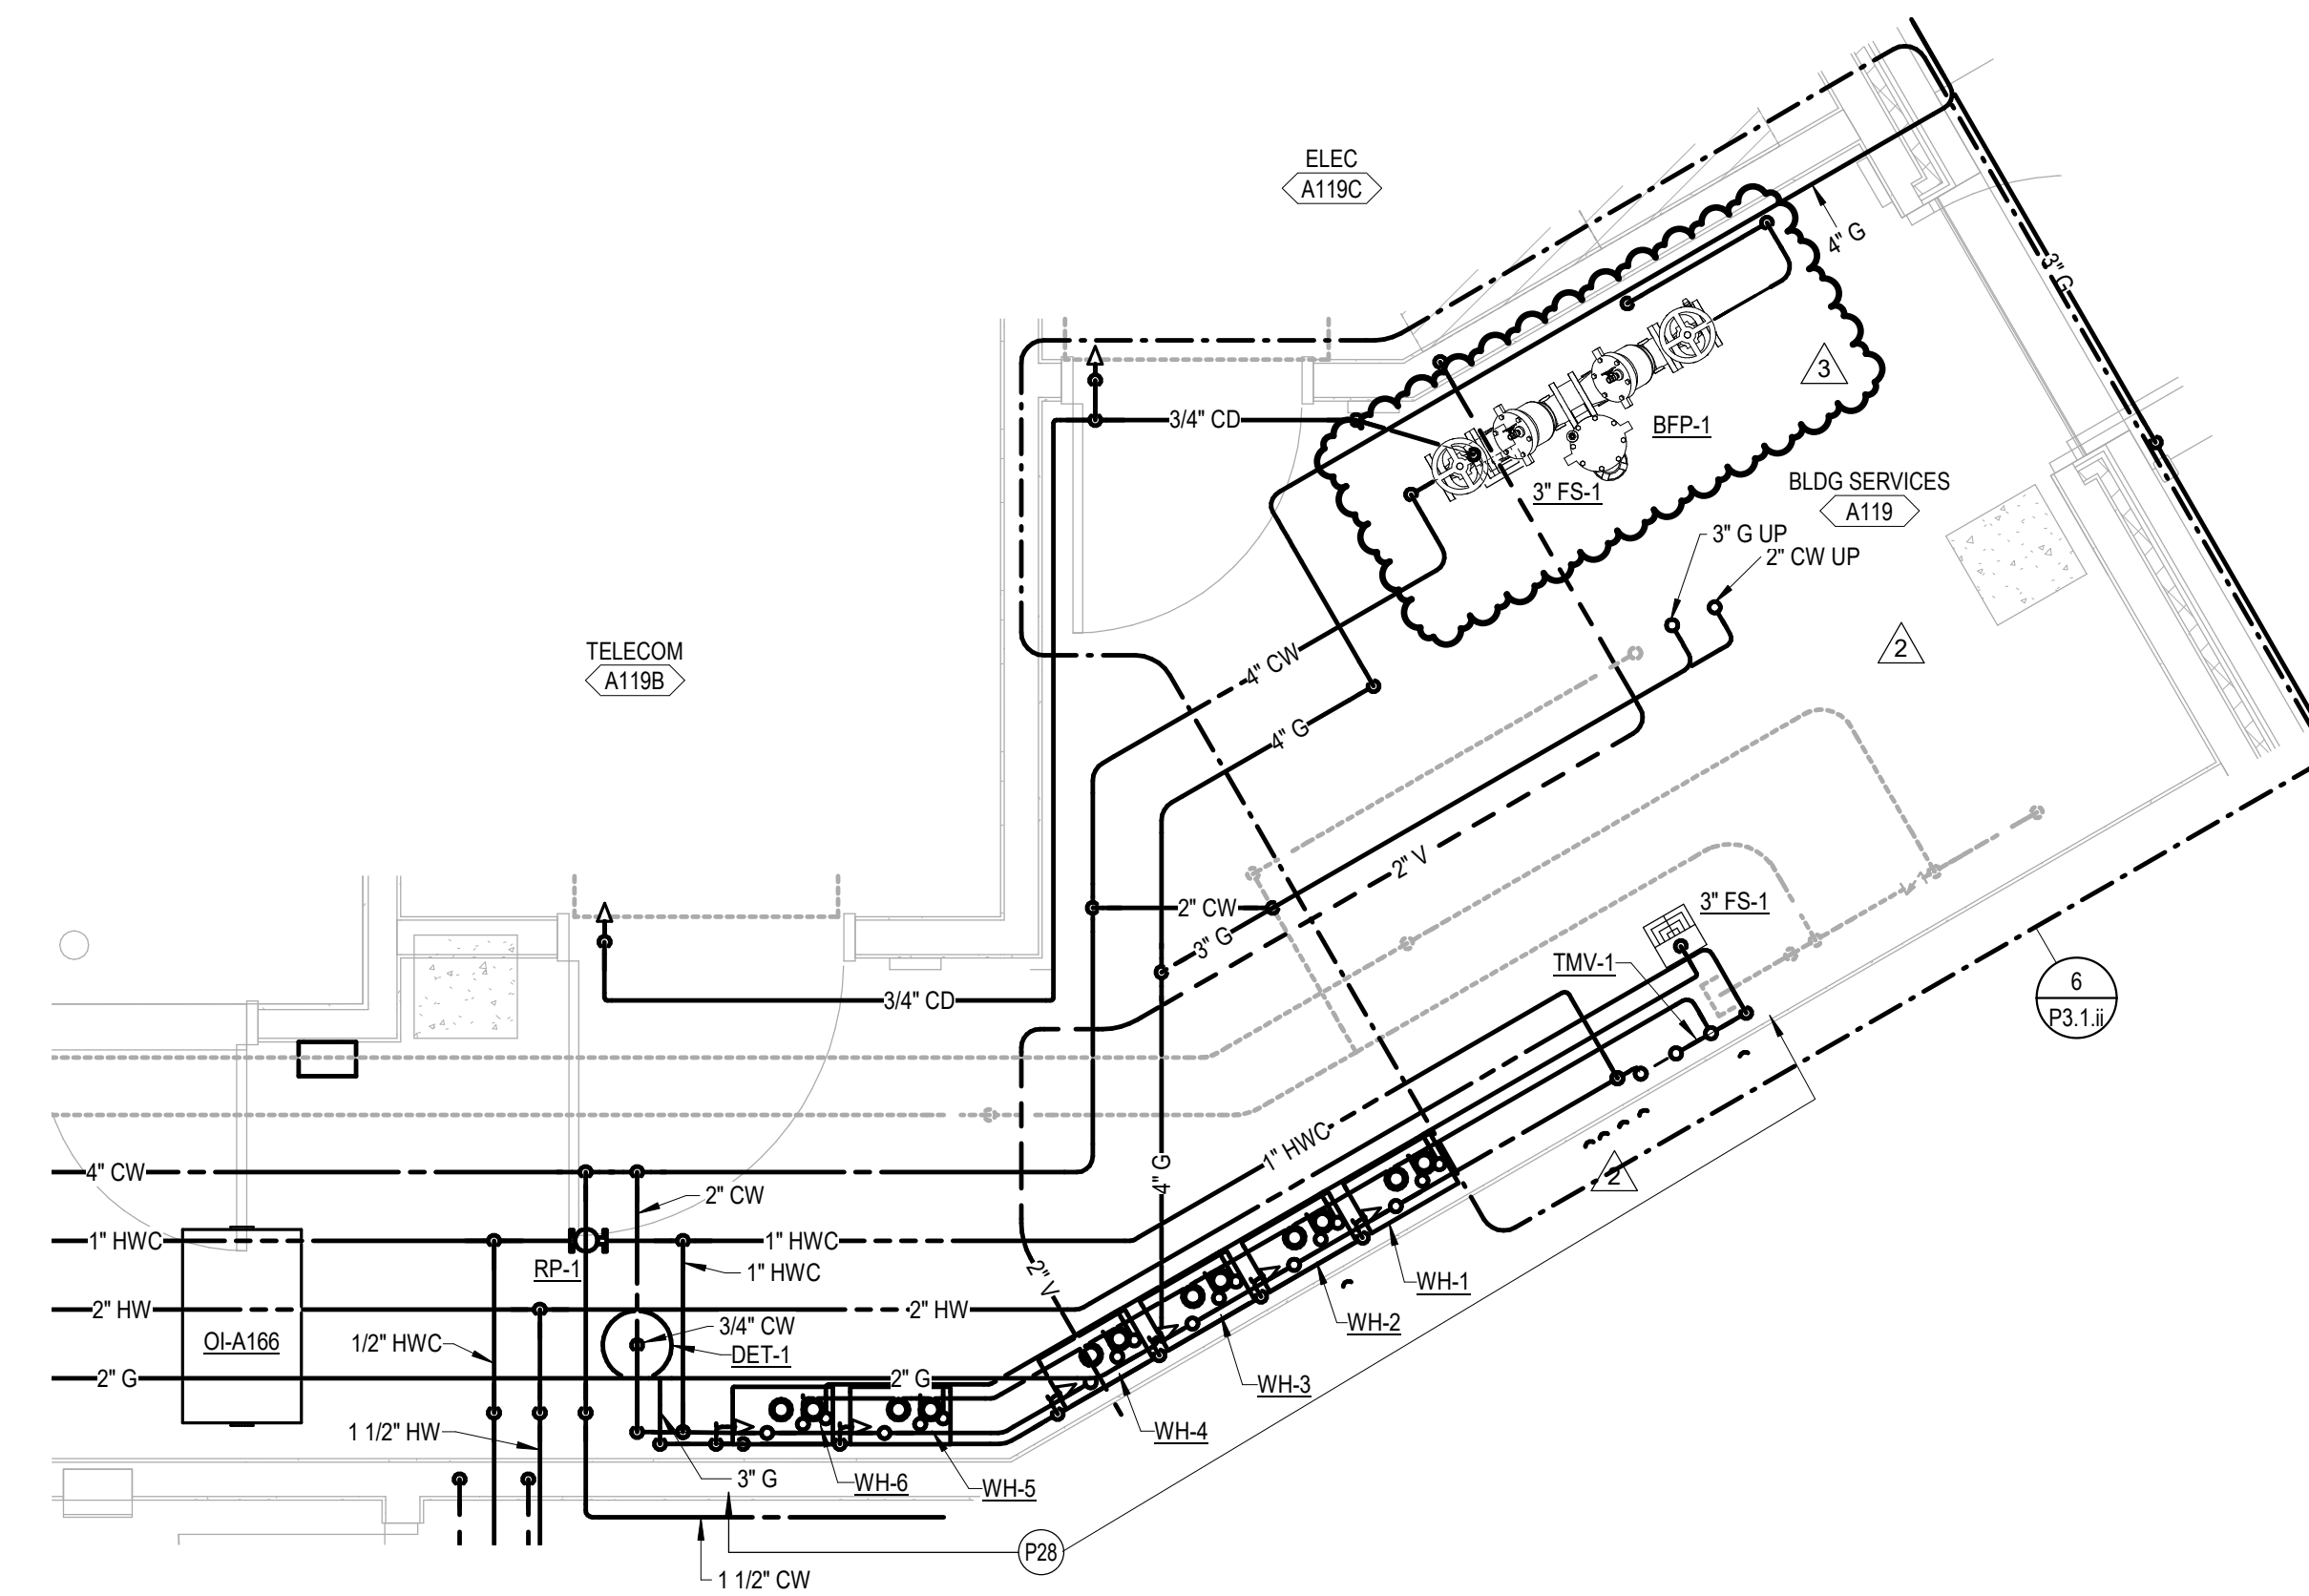


P3.1.ii SCALE: 3/8" = 1'-0"

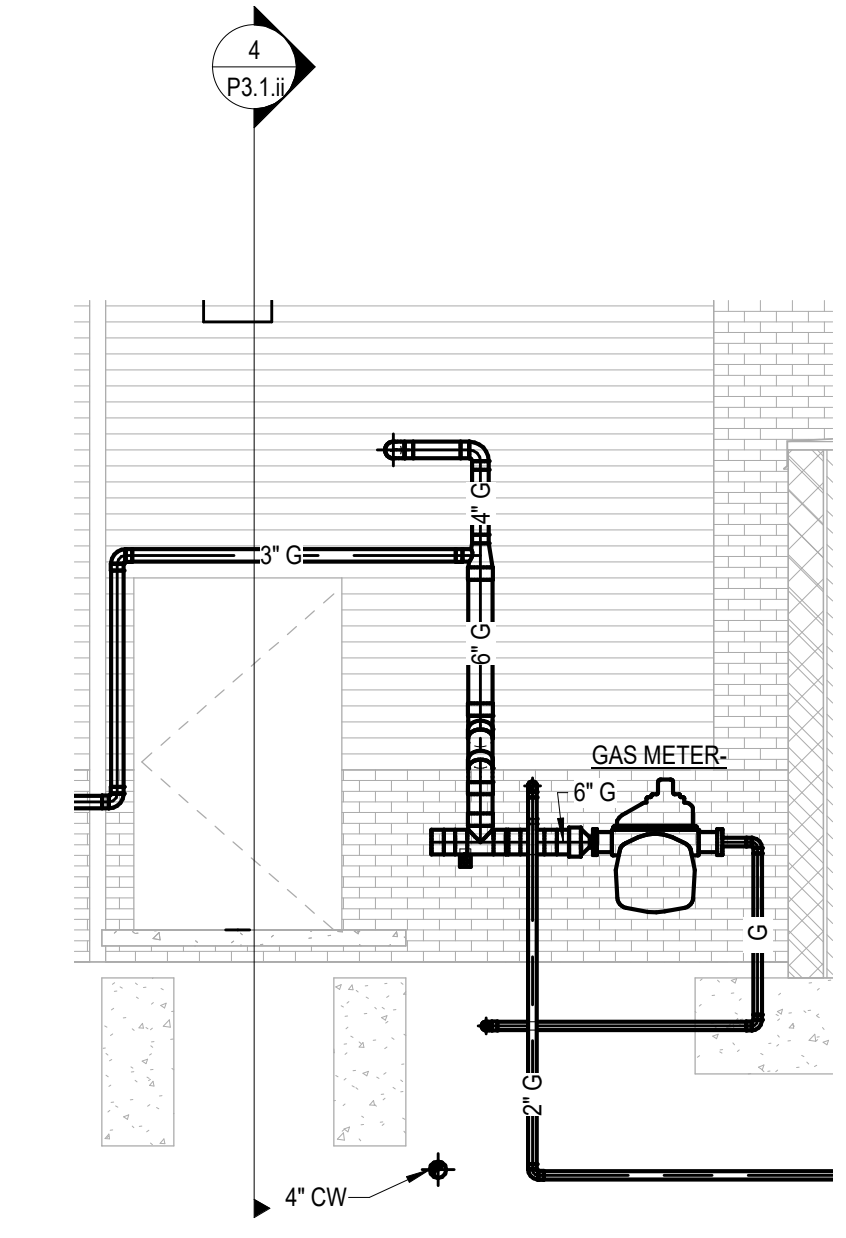


1 GAS METER SECTION
P3.1.ii SCALE: 1/4" = 1'-0"

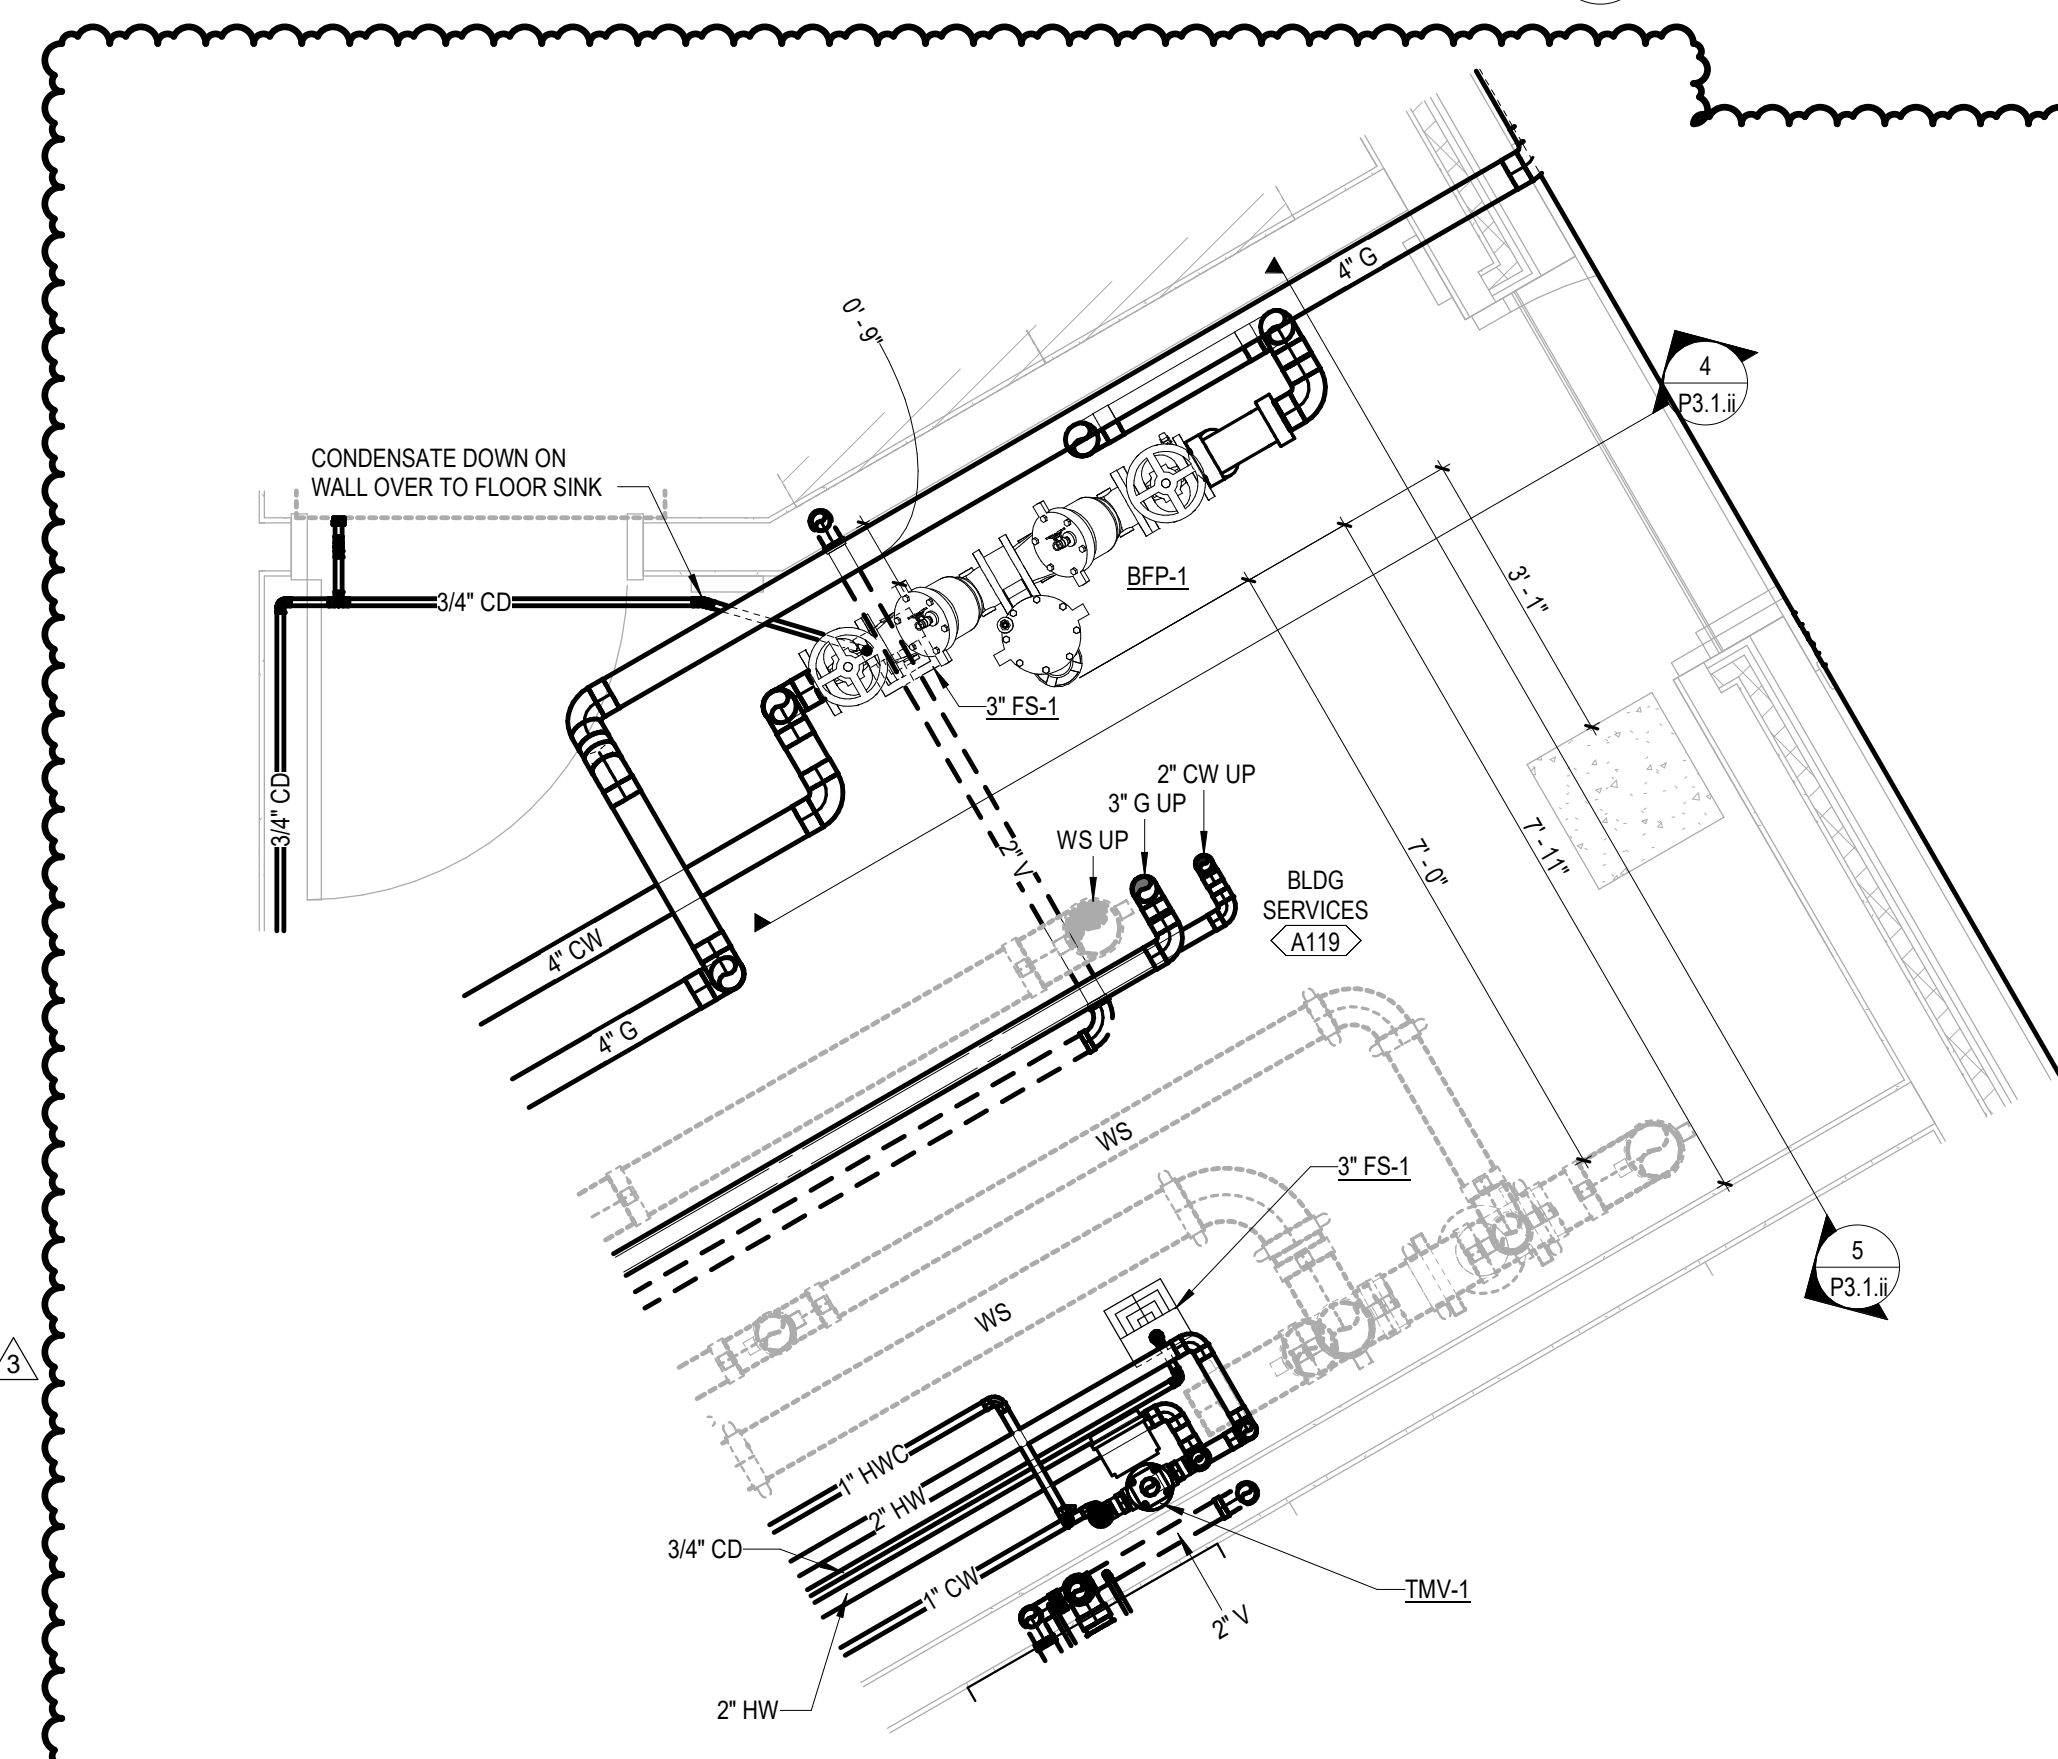

6 BACKFLOW PREVENTER ENLARGED PLAN
P3.1.ii SCALE: 1/2" = 1'-0"

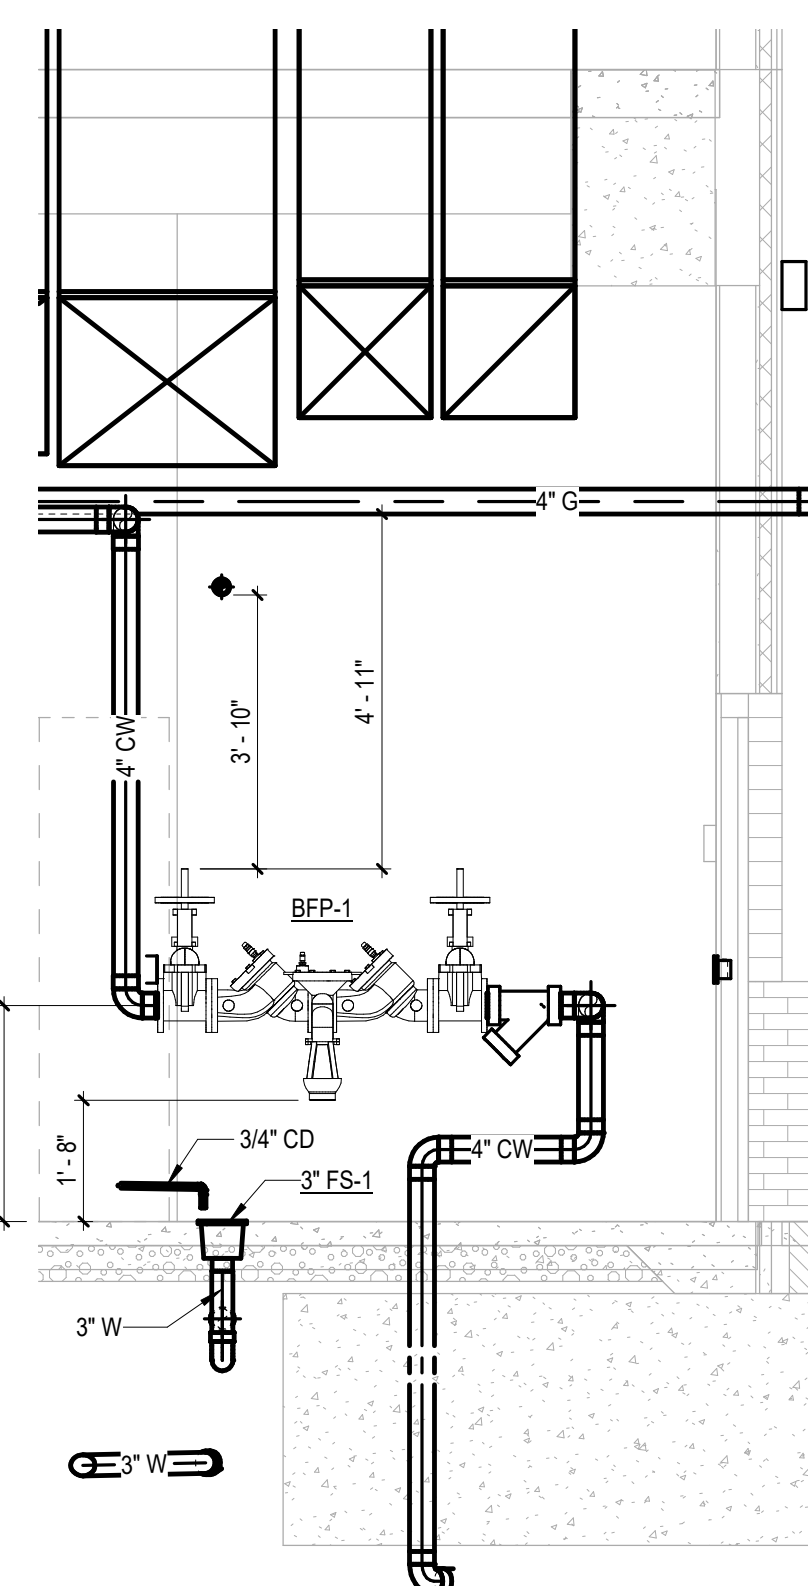

4 DOMESTIC WATER BACKFLOW PREVENTER ELEVATION
P3.1.ii SCALE: 3/8" = 1'-0"

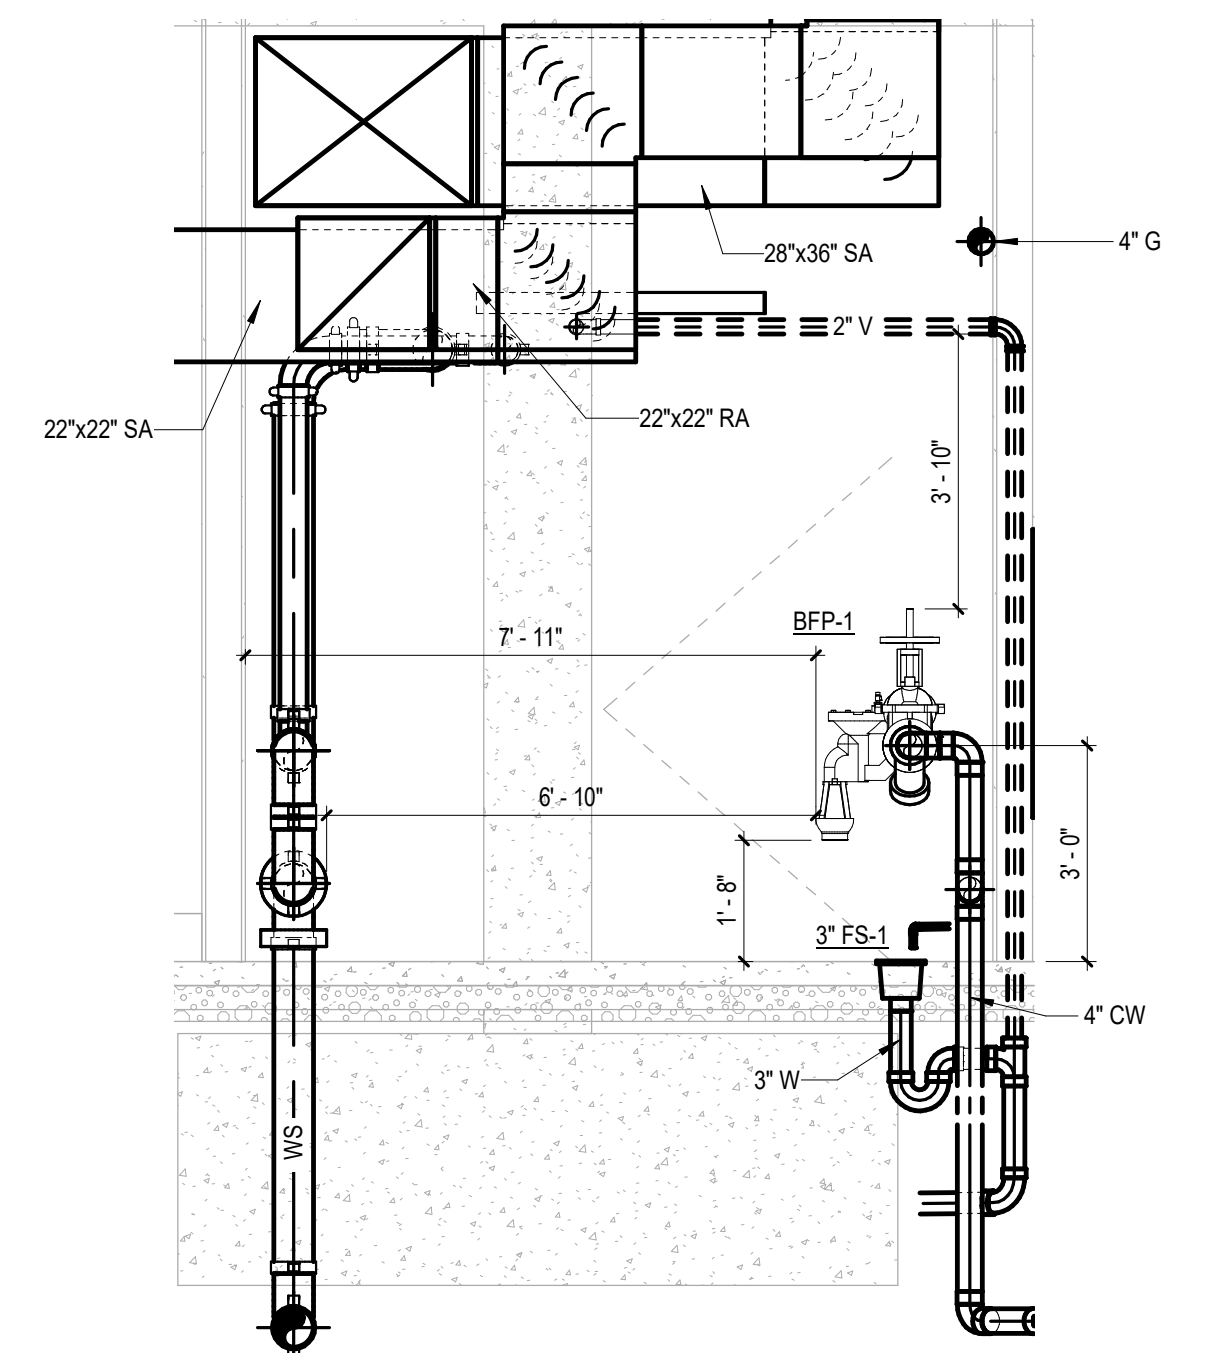


5 DOMESTIC WATER BACKFLOW PREVENTER SECTION
P3.1.ii SCALE: 3/8" = 1'-0"

B:\050\057\21113\00_Dutchess Stadium_Plan\057-21113-00_Dutchess Stadium_Plan_MEP_2020.rvt
11/7/2023 12:28:39 PM

1

1A WALL CLEANOUT DETAIL

PS.1.11 NO SCALE

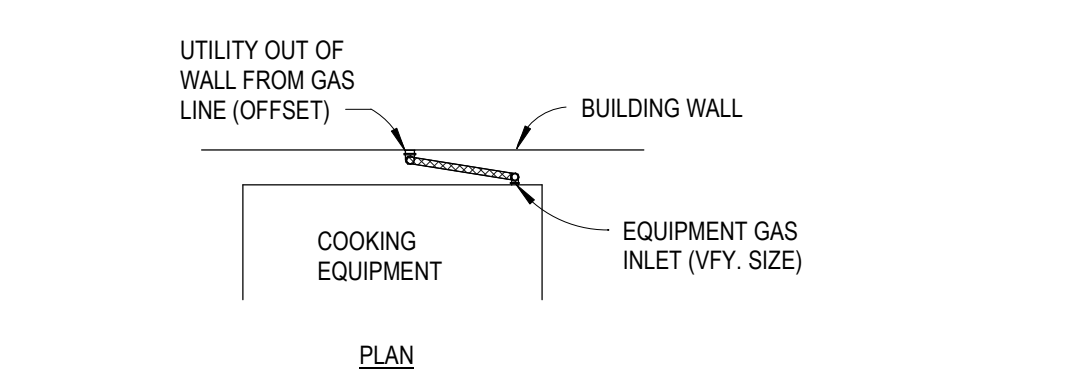

2

2A GAS DISCONNECT DETAIL


PS.1.11 NO SCALE



3

3A INLINE CIRCULATOR PUMP DETAIL


PS.1.11 NO SCALE

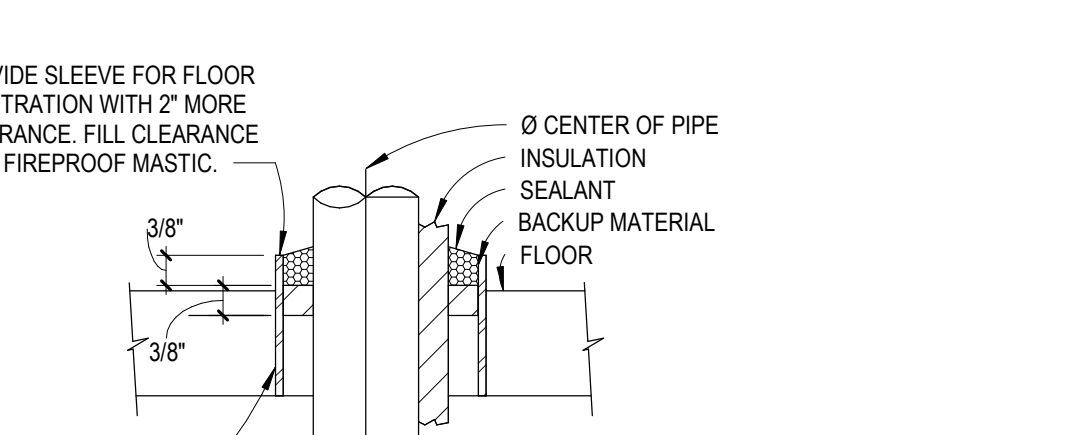

4

4A PIPE PENETRATIONS DETAIL


PS.1.11 NO SCALE

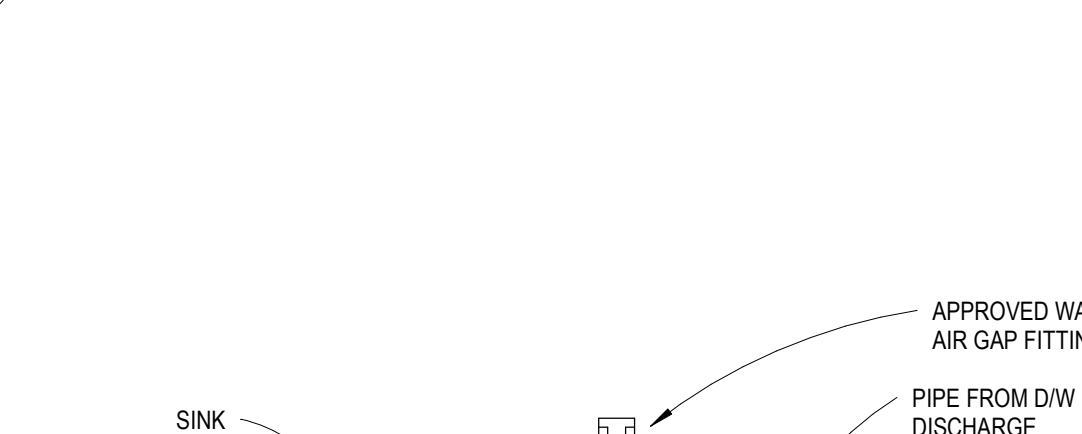

5


5A DISHWASHER PIPING DETAIL

PS.1.11 NO SCALE

 


1B CLEANOUT DETAILS

PS.1.11 NO SCALE

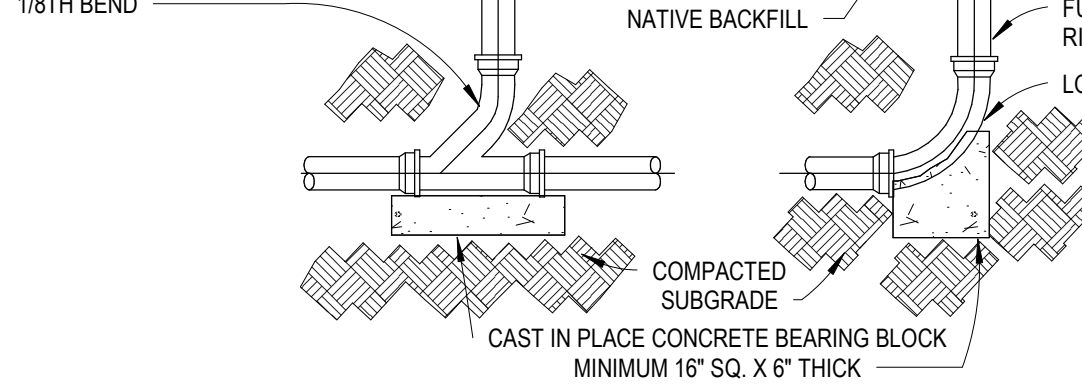


1C FINISHED GRADE 2-WAY CLEANOUT DETAIL

PS.1.11 NO SCALE

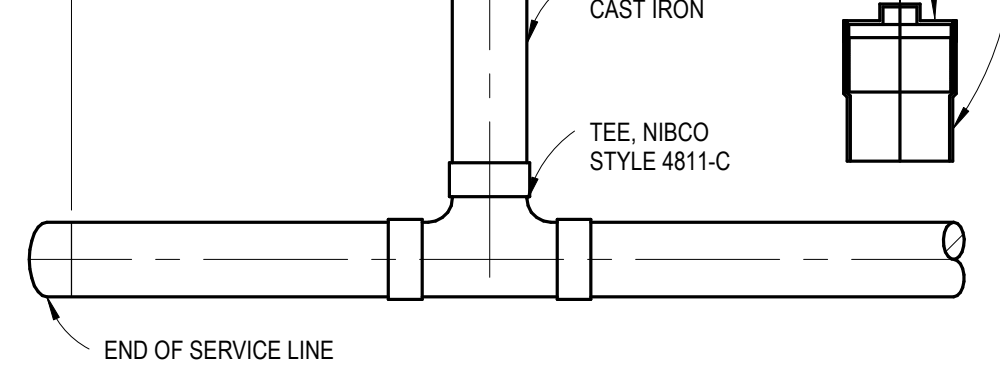


1D FINISHED FLOOR CLEANOUT DETAIL

PS.1.11 NO SCALE

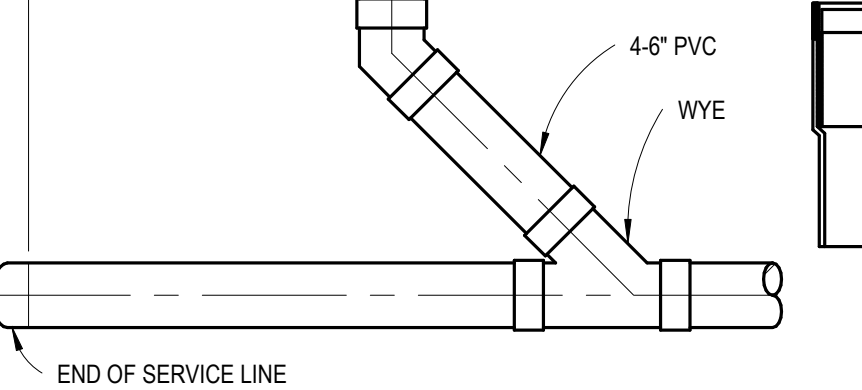


1E BLOW DOWN CONNECTION DETAIL

PS.1.11 NO SCALE

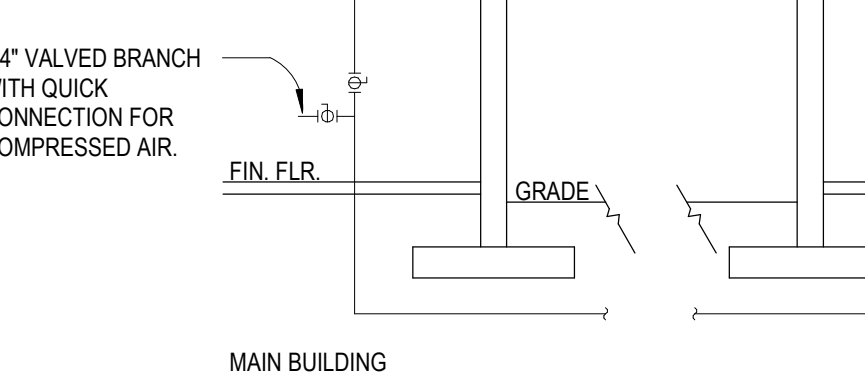


1F ADA ACCESSIBLE LAVATORY DETAIL

PS.1.11 NO SCALE

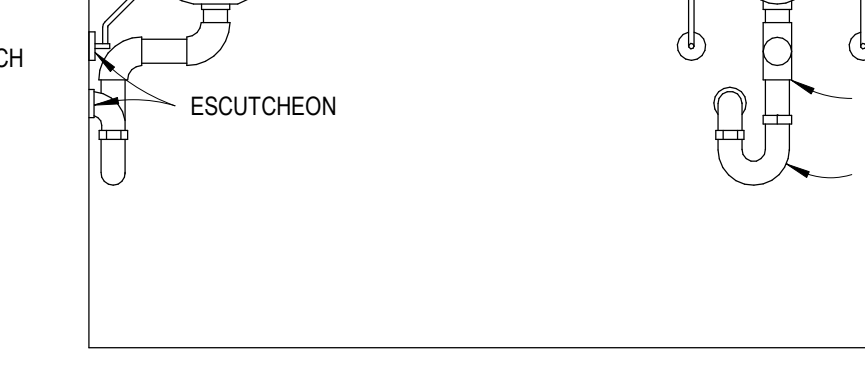


2B GAS CONNECTION DETAIL

PS.1.11 NO SCALE

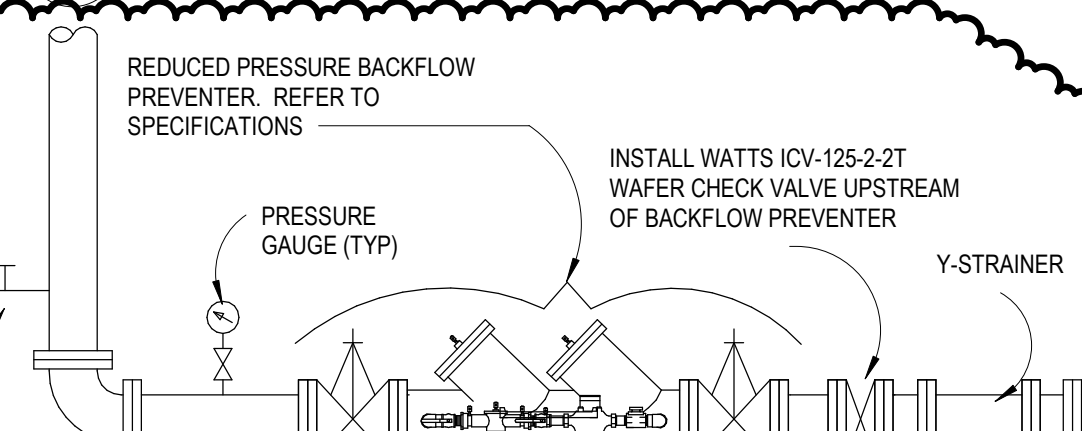


2C PLUMBING ROOF VENT DETAIL

PS.1.11 NO SCALE

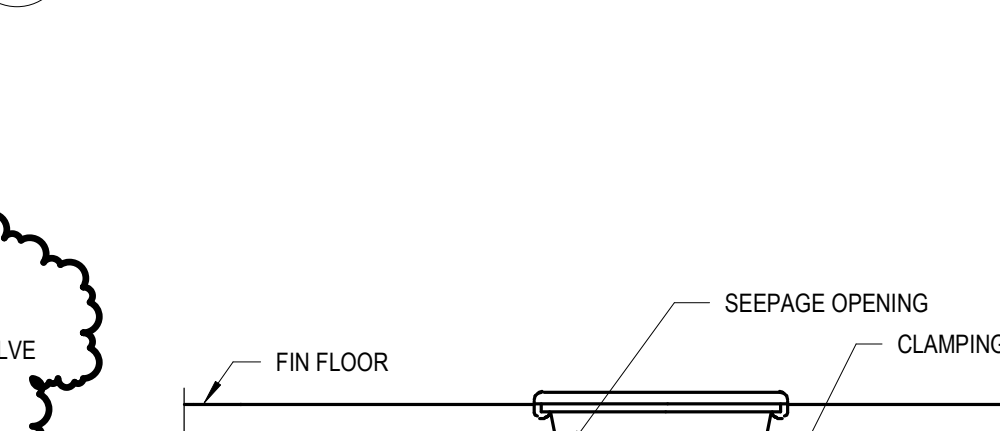


3B DOMESTIC WATER BACKFLOW PREVENTER DETAIL

PS.1.11 NO SCALE

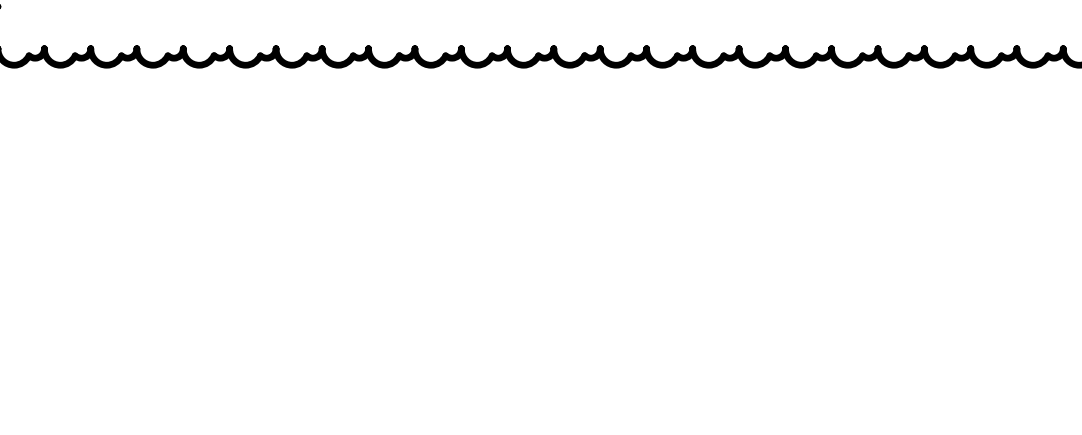


3C TYPICAL FLOOR SINK ON ELEVATED SLAB DETAIL


PS.1.11 NO SCALE

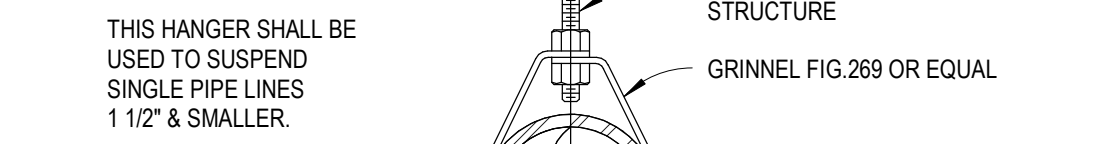

THIS HANGER SHALL BE USED TO SUSPEND SINGLE PIPE LINES 1 1/2" & SMALLER.

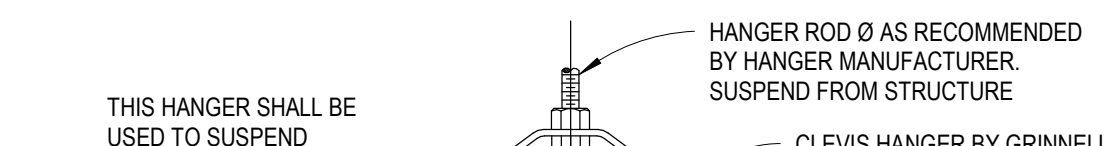

THIS HANGER SHALL BE USED TO SUSPEND SINGLE PIPE LINES 2" & LARGER.

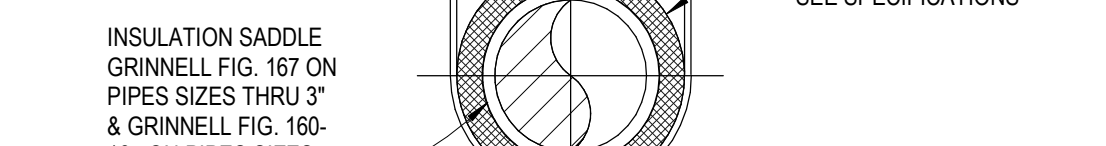



SEE TABLE BELOW FOR SUPPORT SPACING REQUIREMENTS.

Table with 3 columns: PIPING MATERIAL, MAXIMUM HORIZONTAL SPACING (FEET), MAXIMUM VERTICAL SPACING (FEET). Rows include ABS PIPE, CAST-IRON PIPE, COPPER OR COPPER-ALLOY PIPE, COPPER OR COPPER-ALLOY TUBING, CROSS-LINKED POLYETHYLENE (PEX) PIPE, CPVC PIPE OR TUBING, STEEL PIPE, POLYPROPYLENE PIPE OR TUBING, and PVC PIPE.

- NOTES: (a) THE MAXIMUM HORIZONTAL SPACING OF CAST-IRON PIPE HANGERS SHALL BE INCREASED TO 10 FEET WHERE 10-FOOT LENGTHS OF PIPE ARE INSTALLED. (b) MIDSTORY GUIDE FOR SIZES 2 INCHES AND SMALLER. REMARKS: 1) HANGERS AND SUPPORTING MATERIALS SHALL BE OF AN APPROVED MATERIAL THAT WILL NOT PROMOTE GALVANIC ACTION. 2) HANGERS AND ANCHORS SHALL BE ATTACHED TO THE BUILDING CONSTRUCTION IN AN APPROVED MANNER.

4D PIPE HANGER SUPPORT DETAIL

PS.1.11 NO SCALE

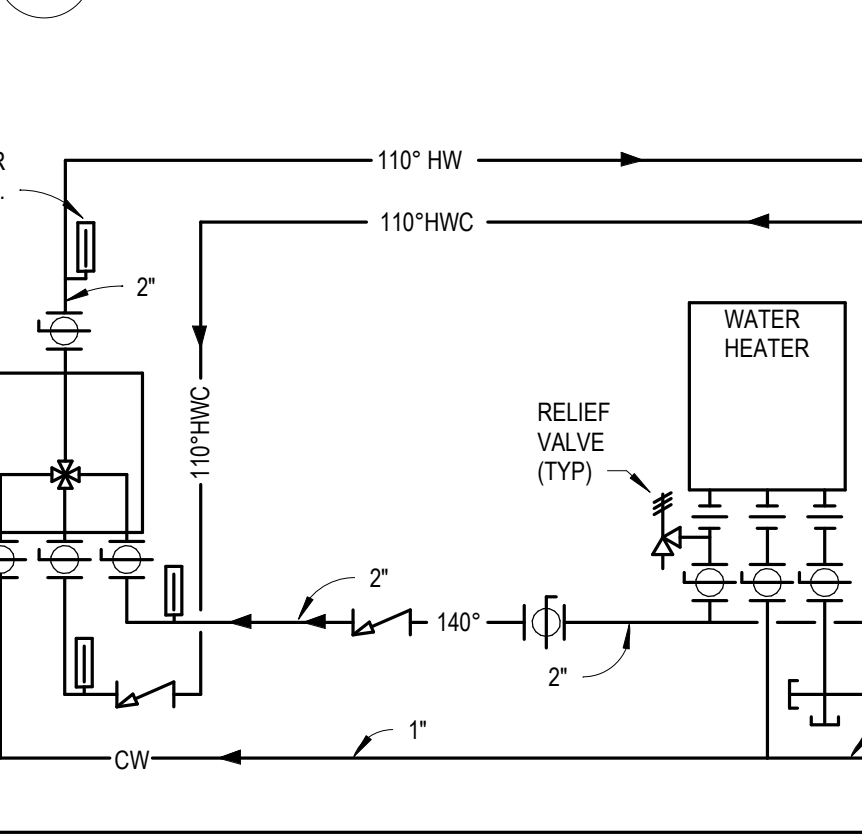


NOTE: DETAIL HERE IS A GUIDE. INSTALL ALL EQUIPMENT AND DEVICES PER MANUFACTURER'S INSTRUCTIONS INCLUDING ALL ACCESSORIES AND INCIDENTAL DEVICES.

5D TANKLESS GAS WATER HEATER DETAIL - NEW CLUBHOUSE

PS.1.11 NO SCALE

2E DOMESTIC WATER SERVICE ENTRANCE DETAIL

PS.1.11 NO SCALE

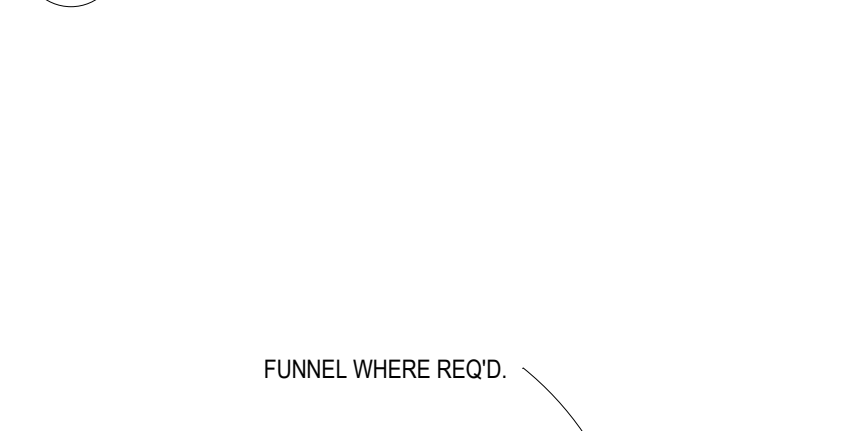


3E TYP. FLOOR DRAIN DETAIL SLAB ON GRADE DETAIL

PS.1.11 NO SCALE




3F TYPICAL FLOOR SINK DETAIL

PS.1.11 NO SCALE

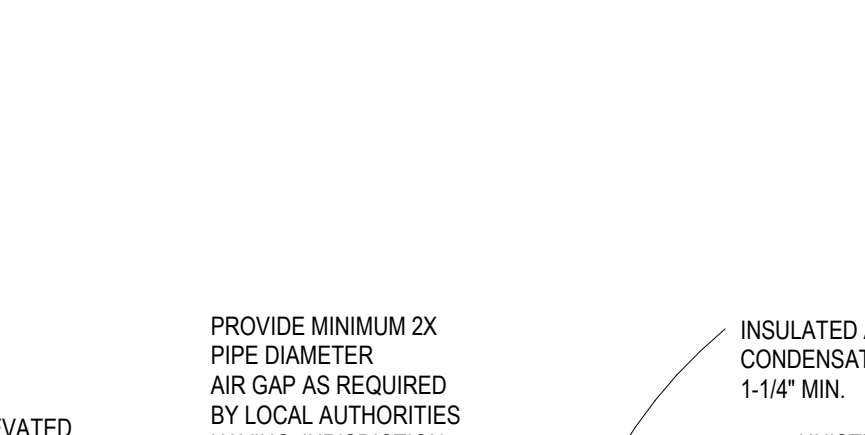


4E WATER HAMMER ARRESTOR DETAIL

PS.1.11 NO SCALE

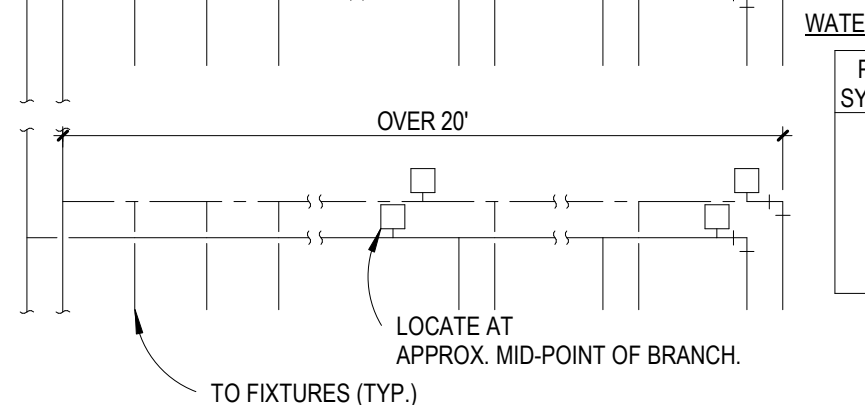

4F TYP. FLOOR DRAIN DETAIL ELEVATED SLAB DETAIL

PS.1.11 NO SCALE

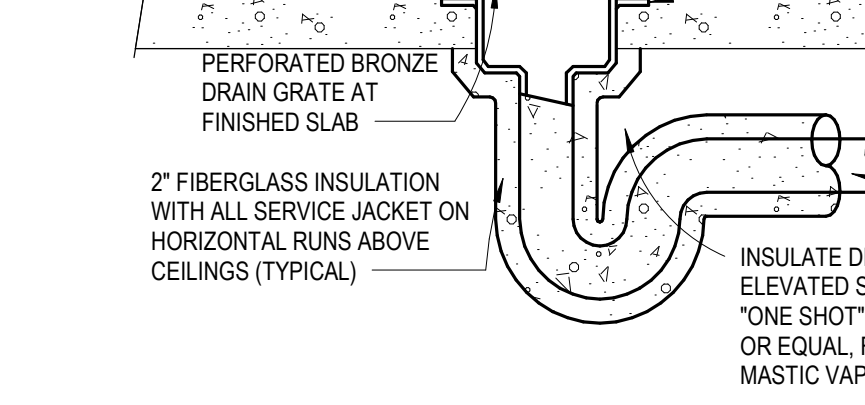

ARRANGEMENT SHOWN IS SCHEMATIC. ADJUST TO SUIT ACTUAL CONDITIONS. LOCATE FLOATS AT ELEVATIONS RECOMMENDED BY PUMP MANUFACTURER. INTERLOCK OF HIGH LEVEL ALARM WITH ALARM BELL. REFER TO FLOOR PLANS IF PROVIDED. INTERLOCK OF HIGH LEVEL ALARM WITH BUILDING AUTOMATION SYSTEM (REFER TO SPECIFICATIONS IF PROVIDED) IS SPECIFIED IN DIVISION 15. REFER TO ARCHITECTURAL AND STRUCTURAL PLANS FOR LOCATION OF CONCRETE SLUMP PIT. INSTALL PIPE AND CONTROLS TO NOT INTERFERE WITH ELEVATOR ITEMS.

5B ELEVATOR PIT SLUMP PUMP DETAIL

PS.1.11 NO SCALE

